



MURRIETA VALLEY
UNIFIED SCHOOL DISTRICT

Murrieta Valley Unified School District
41870 McAlby Court
Murrieta, CA 92562

DISTRICT BID ADDENDUM NO. 5

Date: October 25, 2022

To: All Bidders

From: Nadia Zeien, Director of Purchasing

Project: Murrieta Valley Unified School District Tovashal and Thompson HVAC Replacement Project

Subject: Mechanical As-built Drawings for Tovashal E.S. and Thompson M.S.;
New Bid Date

The attached Addendum is issued for the purposes of amending certain requirements of the bid and hereby made part of and incorporated in full force as part of the Contract Documents. Unless hereinafter specifically noted or specified otherwise, all work shall conform to the applicable provisions of the Contract Documents.


BID ADDENDUM NO. 5 DESCRIPTION:

1. Mechanical as-built drawings for Tovashal E.S. and Thompson M.S. (attached). This is a follow-up to the Bid RFI 2 response provided in District Bid Addendum 04 issued on October 21, 2022.
2. **The Bid Date is being moved to Monday, October 31, 2022 at 1:00p.m. to allow for Bidders to review the as-built drawings and provide pricing accordingly.**

ATTACHMENTS:

- Tovashal E.S. Mechanical As-built Drawings (attached)
- Thompson M.S. Mechanical As-built Drawings (attached)

END OF DISTRICT BID ADDENDUM NO. 5

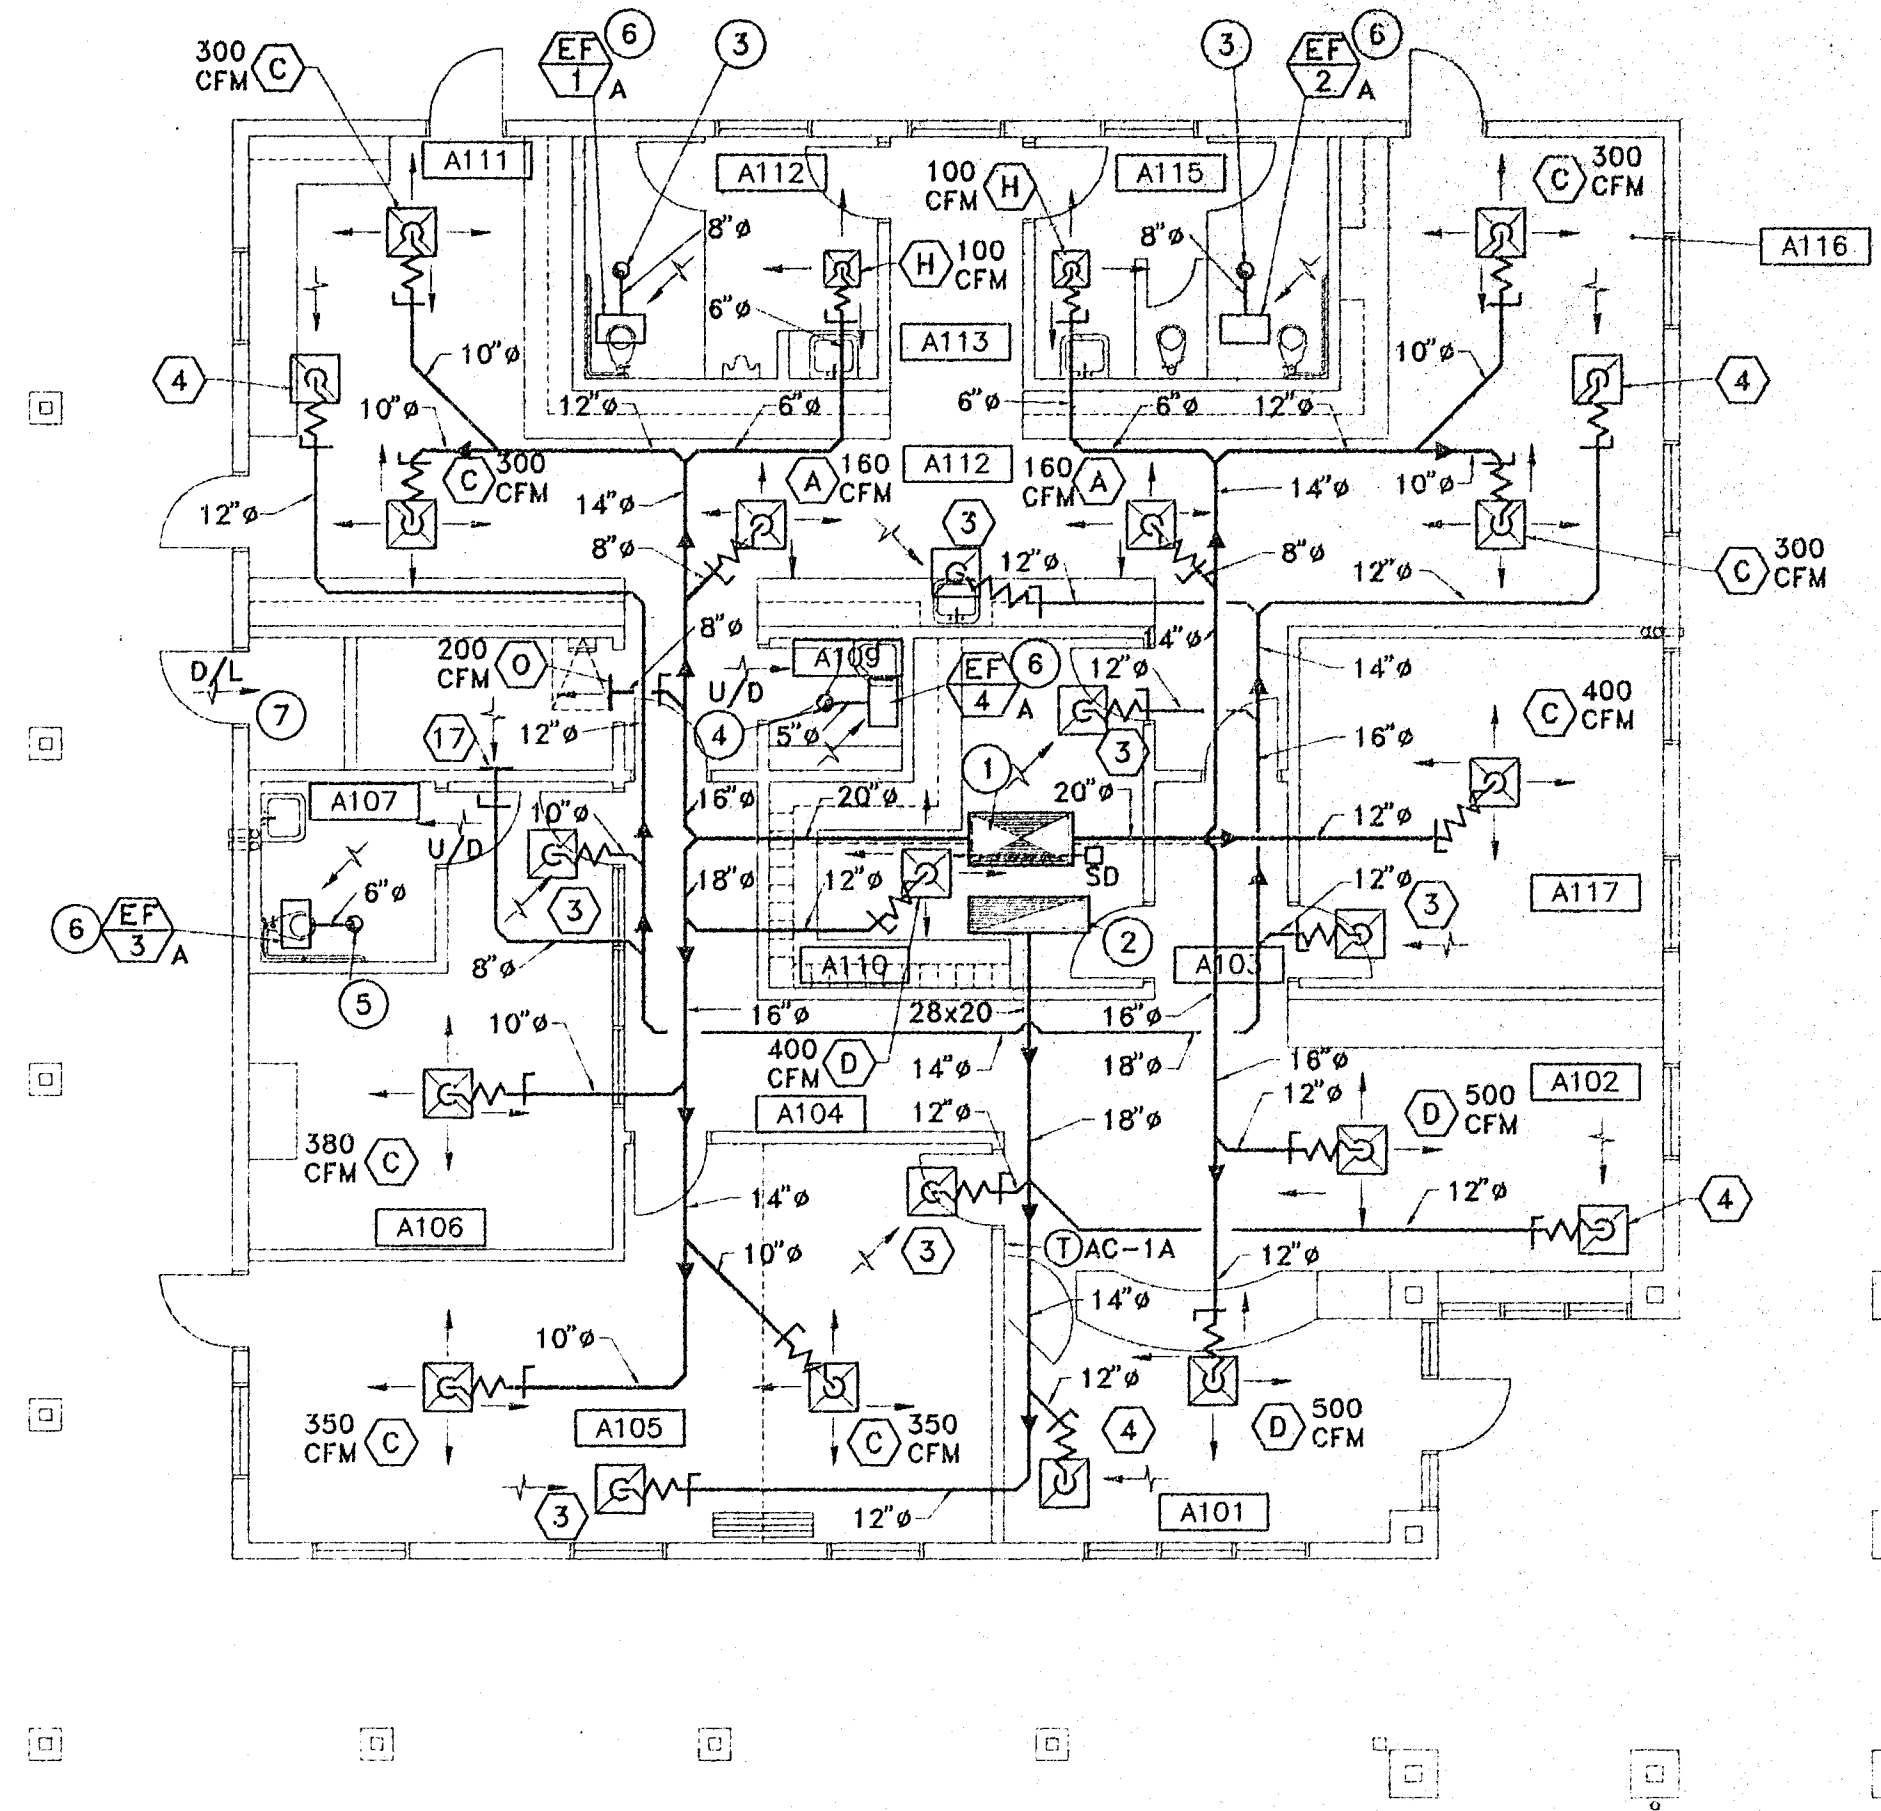


MECHANICAL FLOOR PLAN

1/8"=1'-0" 1

REFERENCE NOTES:

- 1 52"x26" LINED SUPPLY AIR DUCT UP THRU ROOF TO AC-1A. PROVIDE FLEXIBLE CONNECTION AS REQUIRED.
- 2 60"x18" LINED RETURN AIR DUCT UP THRU ROOF TO AC-1A. PROVIDE FLEXIBLE CONNECTION AS REQUIRED.
- 3 8" EXHAUST AIR DUCT UP THRU ROOF AND CONNECT TO ROOF JACK. PROVIDE TRANSITION AS REQUIRED. CONNECT DUCT TO EXHAUST FAN WITH FLEXIBLE CONNECTORS.
- 4 5" EXHAUST AIR DUCT UP THRU ROOF AND CONNECT TO ROOF JACK. PROVIDE TRANSITION AS REQUIRED. CONNECT DUCT TO EXHAUST FAN WITH FLEXIBLE CONNECTORS.
- 5 6" EXHAUST AIR DUCT UP THRU ROOF AND CONNECT TO ROOF JACK. PROVIDE TRANSITION AS REQUIRED. CONNECT DUCT TO EXHAUST FAN WITH FLEXIBLE CONNECTORS.
- 6 EXHAUST FAN IN CEILING PLENUM.
- 7 FULL LOUVER DOOR WITH SCREEN BY OTHERS.

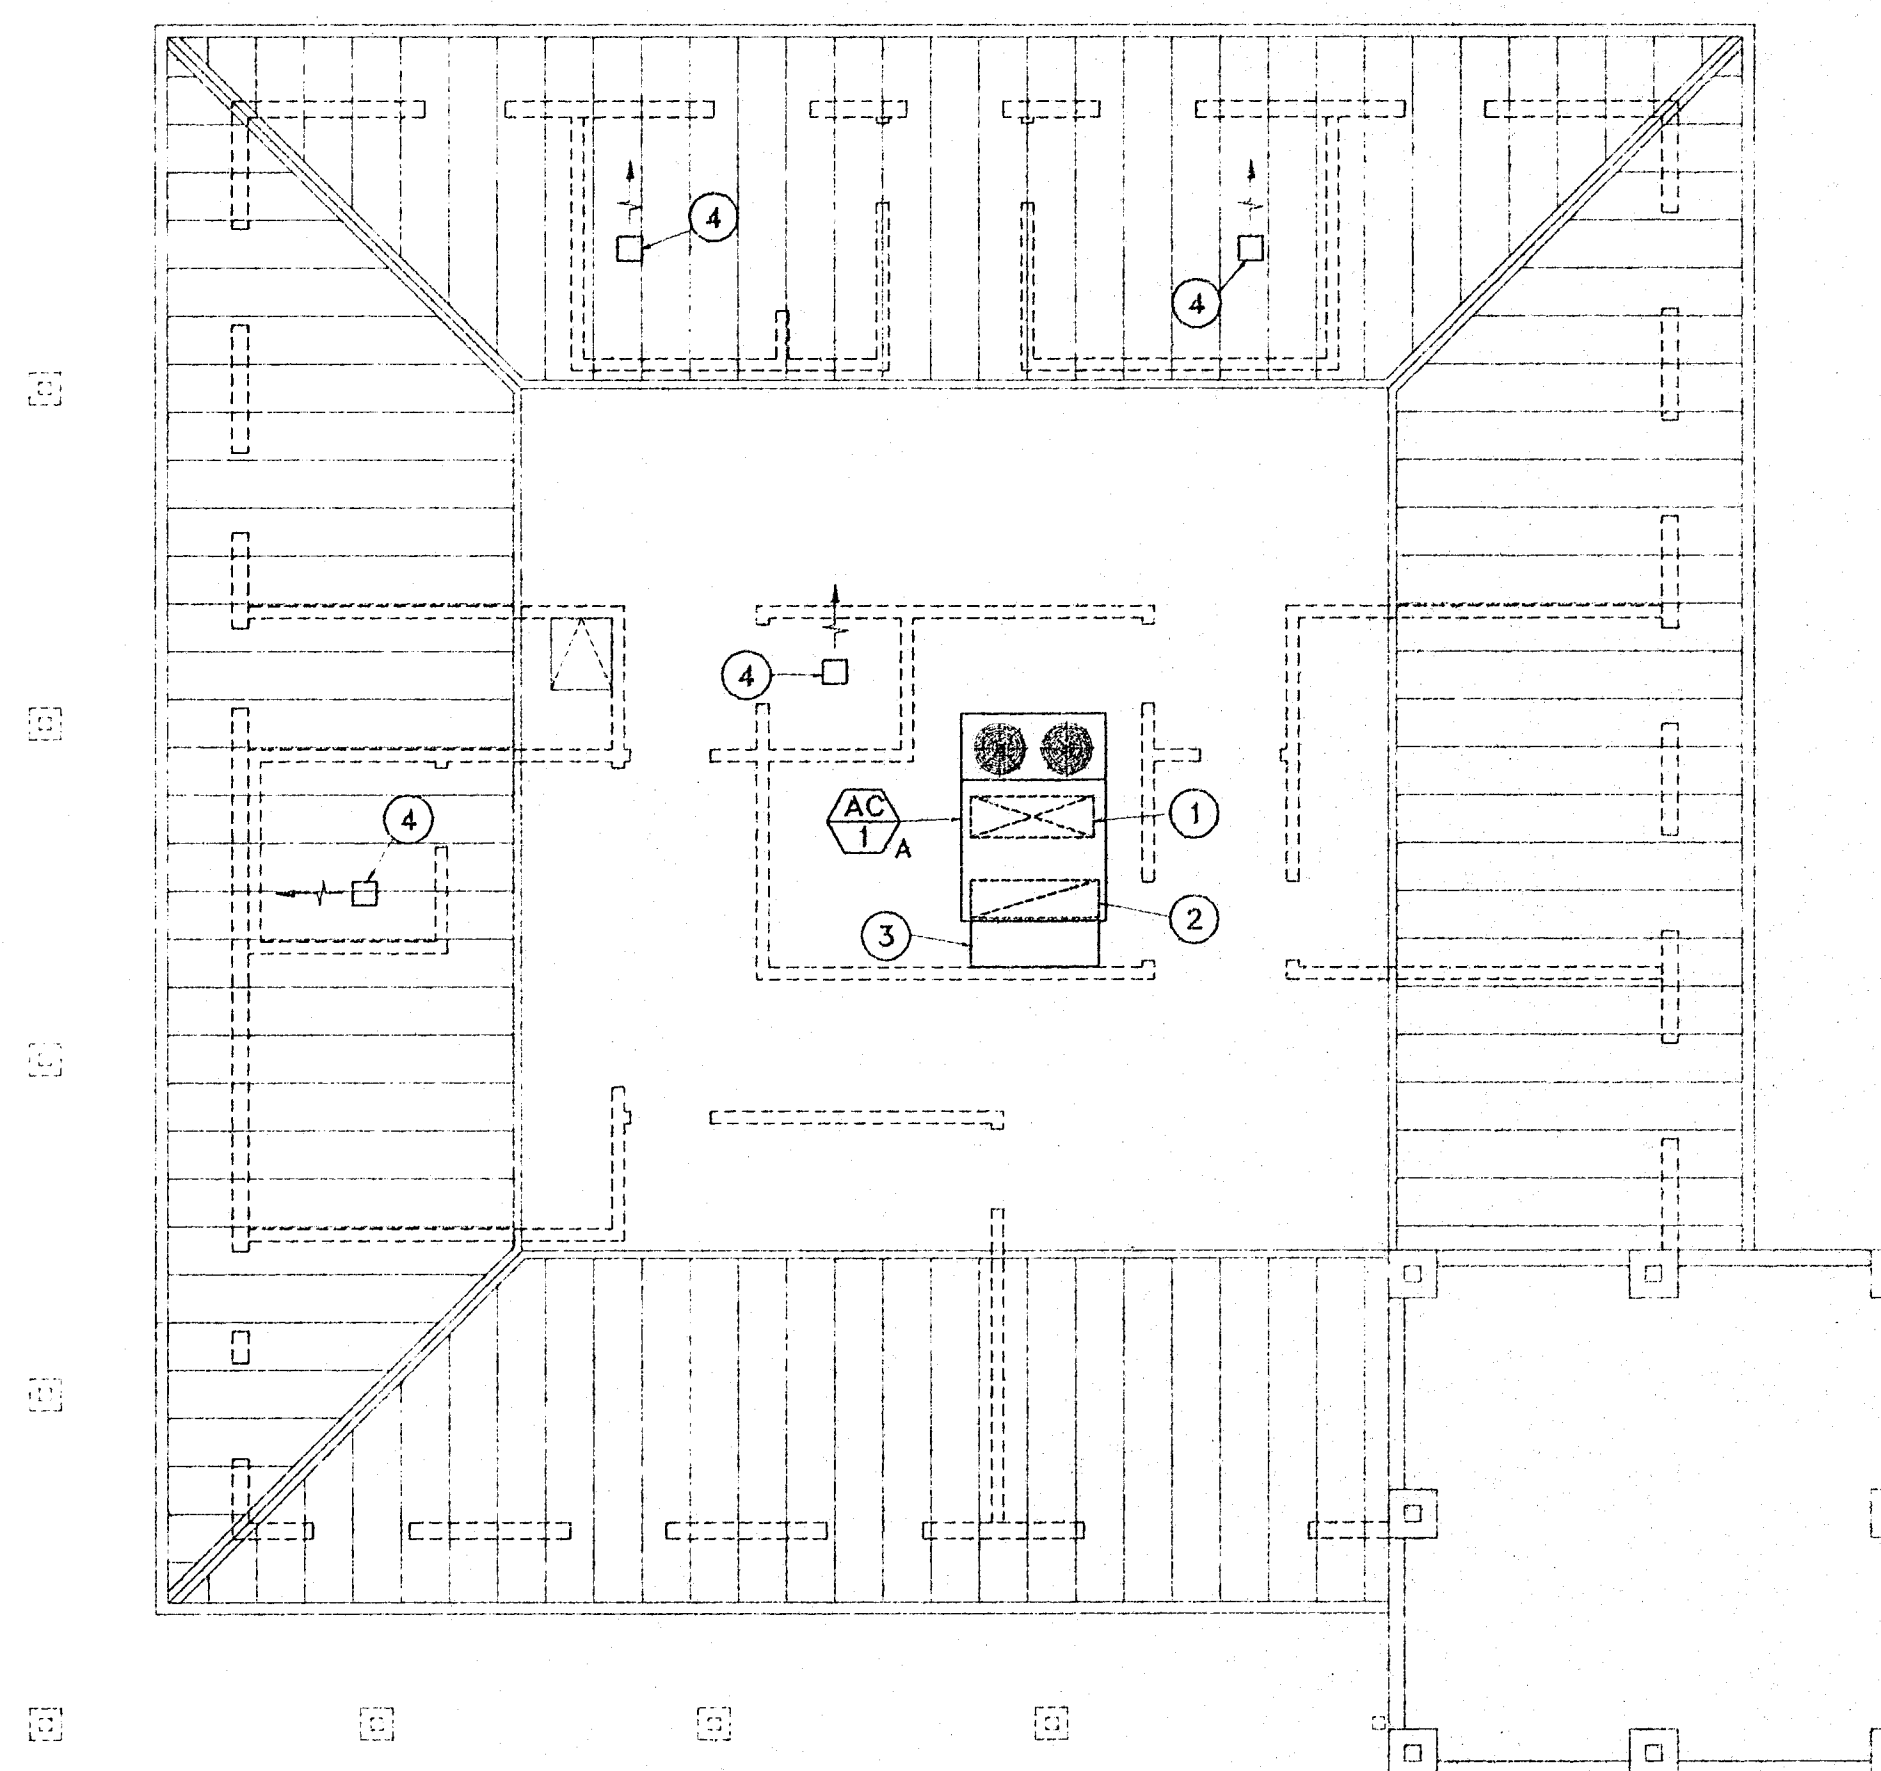


MECHANICAL ROOF PLAN

1/8"=1'-0" 2

REFERENCE NOTES:


- 1 52"x26" LINED SUPPLY AIR DUCT DOWN.
- 2 60"x18" LINED RETURN AIR DUCT DOWN.
- 3 OUTSIDE AIR HOOD.
- 4 ROOF JACK.

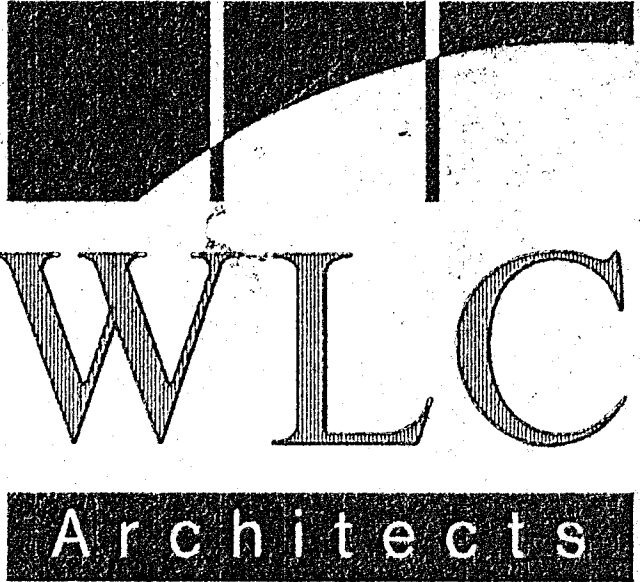

Virginia Dare Tower
10470 Foothill Blvd.
Rancho Cucamonga
California 91730-3754
Tel: 909 987 0909
Fax: 909 980 9980

Tovoshal Elementary School

Murrieta Valley
Unified School District

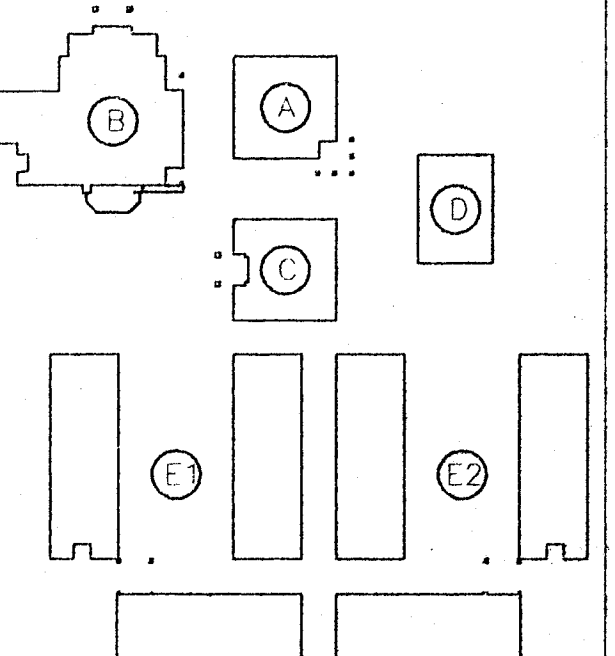


KEY PLAN


CONSULTANT

APPROVED

APPROVED

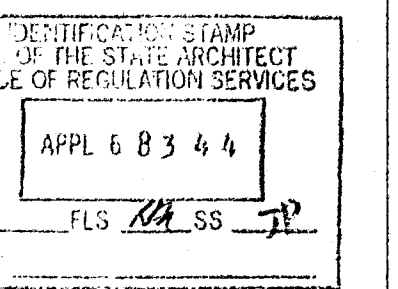

APPROVED

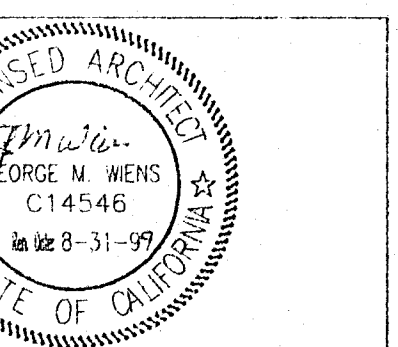

NO	DATE	BY	REMARKS


BLDG. A
FLOOR AND
ROOF PLAN

DRAWN MFS
CHECKED SSM
DATE MAY 1997
SCALE 1/8"=1'-0"
JOB NO. 95113

M-A21



MATHAUDHU ENGINEERING, INC.
CONSULTING MECHANICAL ENGINEERS
3833 JURUPA AVENUE, RIVERSIDE, CALIFORNIA 92506-2221
(909) 686-1776 FAX (909) 686-5001

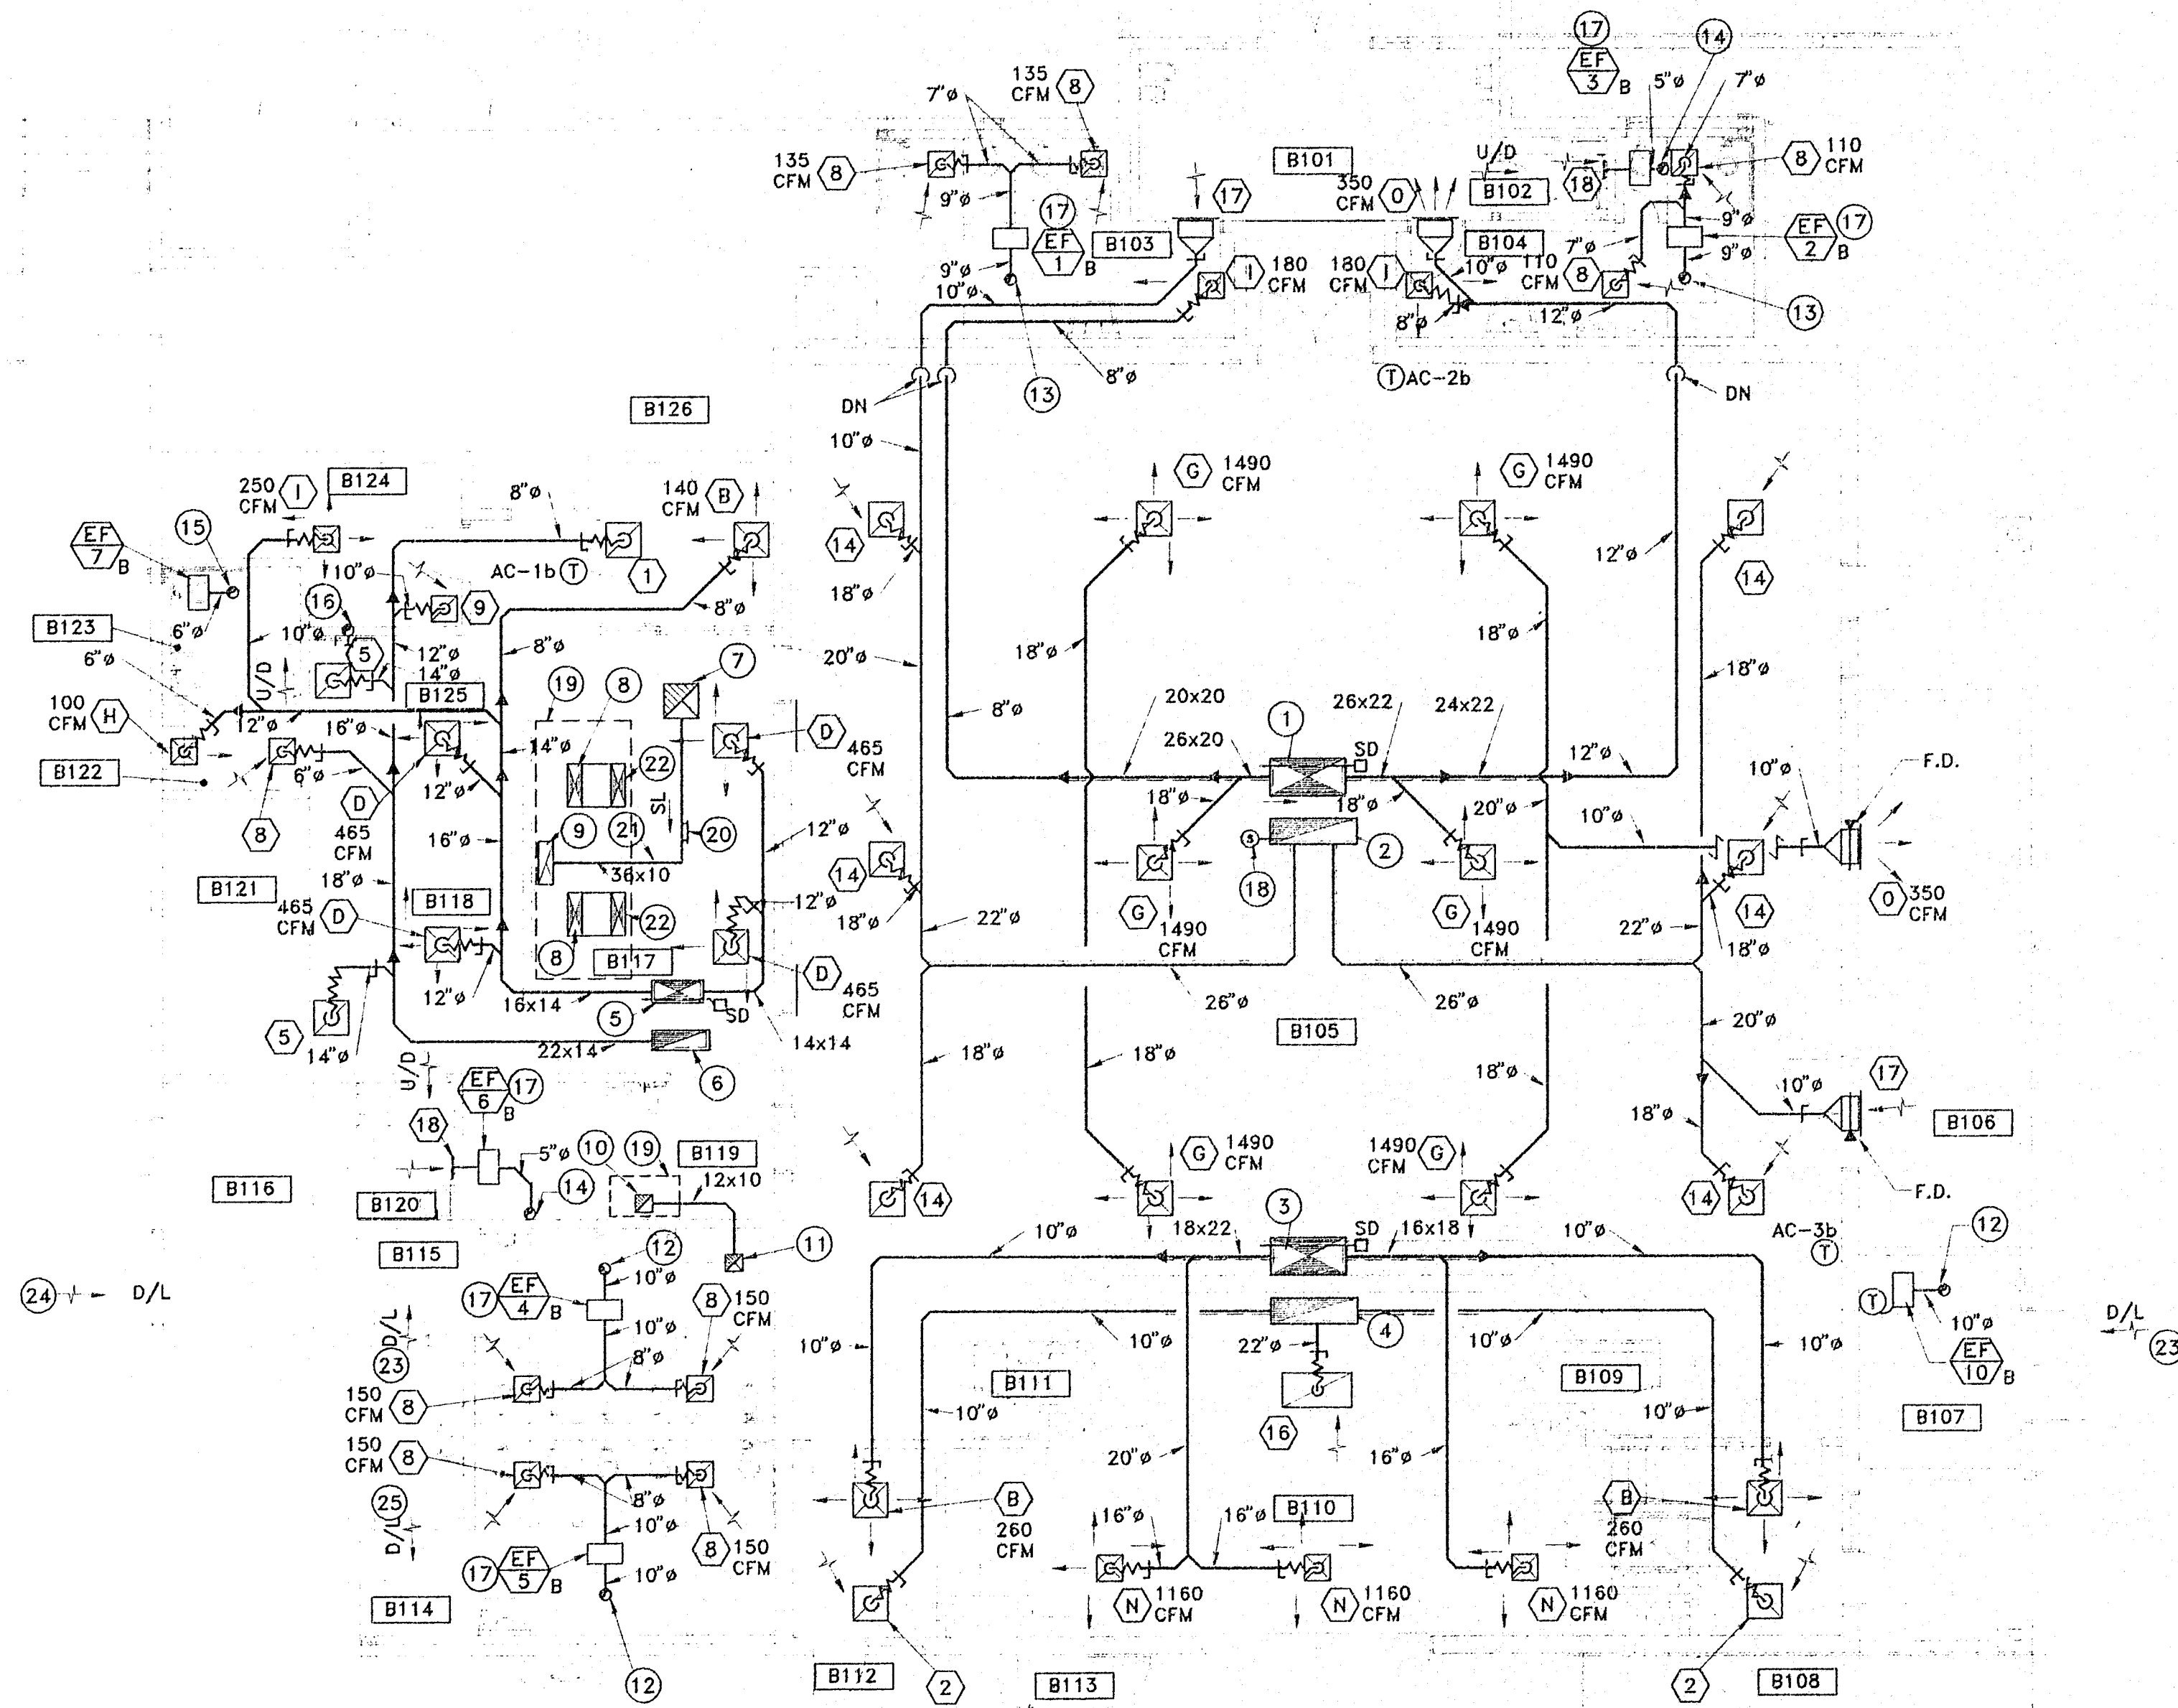


REFERENCE NOTES:

- ① 66"x28" LINED SUPPLY AIR DUCT UP THRU ROOF TO AC-2B. PROVIDE FLEXIBLE CONNECTION AS REQUIRED.
- ② 72"x18" LINED RETURN AIR DUCT UP THRU ROOF TO AC-2B. PROVIDE FLEXIBLE CONNECTION AS REQUIRED.
- ③ 44"x22" LINED SUPPLY AIR DUCT UP THRU ROOF TO AC-3B. PROVIDE FLEXIBLE CONNECTION AS REQUIRED.
- ④ 52"x16" LINED RETURN AIR DUCT UP THRU ROOF TO AC-3B. PROVIDE FLEXIBLE CONNECTION AS REQUIRED.
- ⑤ 36"x16" LINED SUPPLY AIR DUCT UP THRU ROOF TO AC-1B. PROVIDE FLEXIBLE CONNECTION AS REQUIRED.
- ⑥ 40"x14" LINED RETURN AIR DUCT UP THRU ROOF TO AC-1B. PROVIDE FLEXIBLE CONNECTION AS REQUIRED.
- ⑦ 24" x 24" EXHAUST AIR DUCT UP THRU ROOF TO EF-8B. PROVIDE FLEXIBLE CONNECTION AS REQUIRED.
- ⑧ 10" x 30" SUPPLY AIR DUCT UP THRU ROOF.
- ⑨ 10" x 36" EXHAUST AIR DUCT DOWN TO HOOD.
- ⑩ 12" x 12" EXHAUST AIR DUCT DOWN TO HOOD.
- ⑪ 12" x 12" EXHAUST AIR DUCT UP THRU ROOF TO EF-9B.
- ⑫ 10" EXHAUST DUCT UP THRU ROOF AND CONNECT TO ROOF JACK. PROVIDE TRANSITION AS REQUIRED. CONNECT TO EXHAUST FAN WITH FLEXIBLE CONNECTORS.
- ⑬ 9" EXHAUST DUCT UP THRU ROOF AND CONNECT TO ROOF JACK. PROVIDE TRANSITION AS REQUIRED. CONNECT TO EXHAUST FAN WITH FLEXIBLE CONNECTORS.
- ⑭ 5" EXHAUST DUCT UP THRU ROOF AND CONNECT TO ROOF JACK. PROVIDE TRANSITION AS REQUIRED. CONNECT TO EXHAUST FAN WITH FLEXIBLE CONNECTORS.
- ⑮ 6" EXHAUST DUCT UP THRU ROOF AND CONNECT TO ROOF JACK. PROVIDE TRANSITION AS REQUIRED. CONNECT TO EXHAUST FAN WITH FLEXIBLE CONNECTORS.
- ⑯ 4" EXHAUST DUCT UP THRU ROOF AND CONNECT TO ROOF JACK. PROVIDE TRANSITION AS REQUIRED. TERMINATE DUCT +16" FROM FINISH FLOOR FOR DRYER VENT CONNECTION.
- ⑰ EXHAUST FAN IN CEILING PLENUM.
- ⑱ CO2 SENSOR.
- ⑲ EXHAUST HOOD BY OTHERS.
- ⑳ DUCT ACCESS DOOR.
- ㉑ SLOPE DUCT DOWN TOWARD THE HOOD.
- ㉒ 10" x 30" SUPPLY AIR DUCT DOWN TO HOOD.
- ㉓ 24" x 12" DOOR LOUVER W/SCREEN (BY OTHERS).



Virginia Dare Tower
10470 Foothill Blvd
Rancho Cucamonga
California 91730-3754
tel: 909 987 0909
fax: 909 980 9980


Tovoshal Elementary School
Murrieta Valley
Unified School District

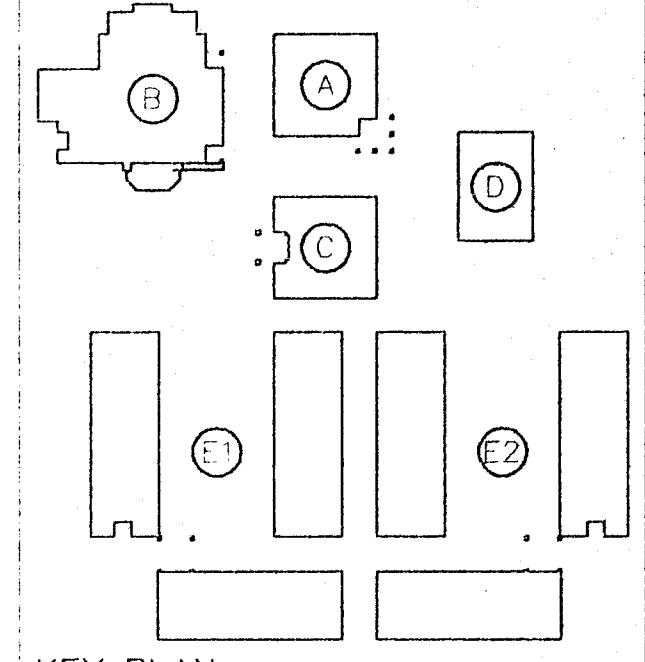


KEY PLAN

CONSULTANT

APPROVED

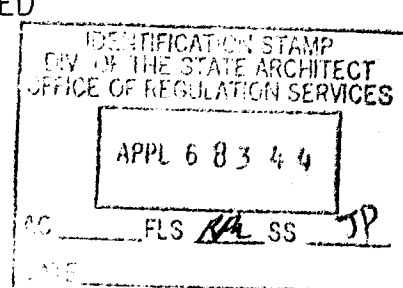APPROVED

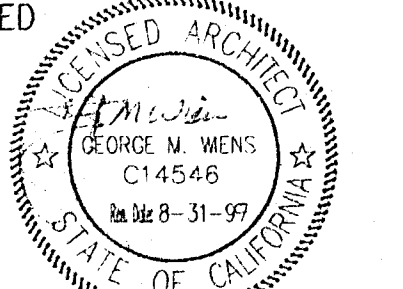 APR 6 8 5 4
 RLS SS

APPROVED

 MATHAUDHU ENGINEERING, INC.
 CONSULTING MECHANICAL ENGINEERS
 3833 JURUPA AVENUE, RIVERSIDE, CALIFORNIA, 92504-2211
 (951) 686-1776 FAX (951) 686-5081

NO	DATE	BY	REMARKS


BLDG. B
FLOOR
PLAN

DRAWN MFS
 CHECKED SSM
 DATE MAY 1997
 SCALE 1/8"=1'-0"
 JOB NO. 95113

M-B21

MECHANICAL FLOOR PLAN

1/8"=1'-0" 1

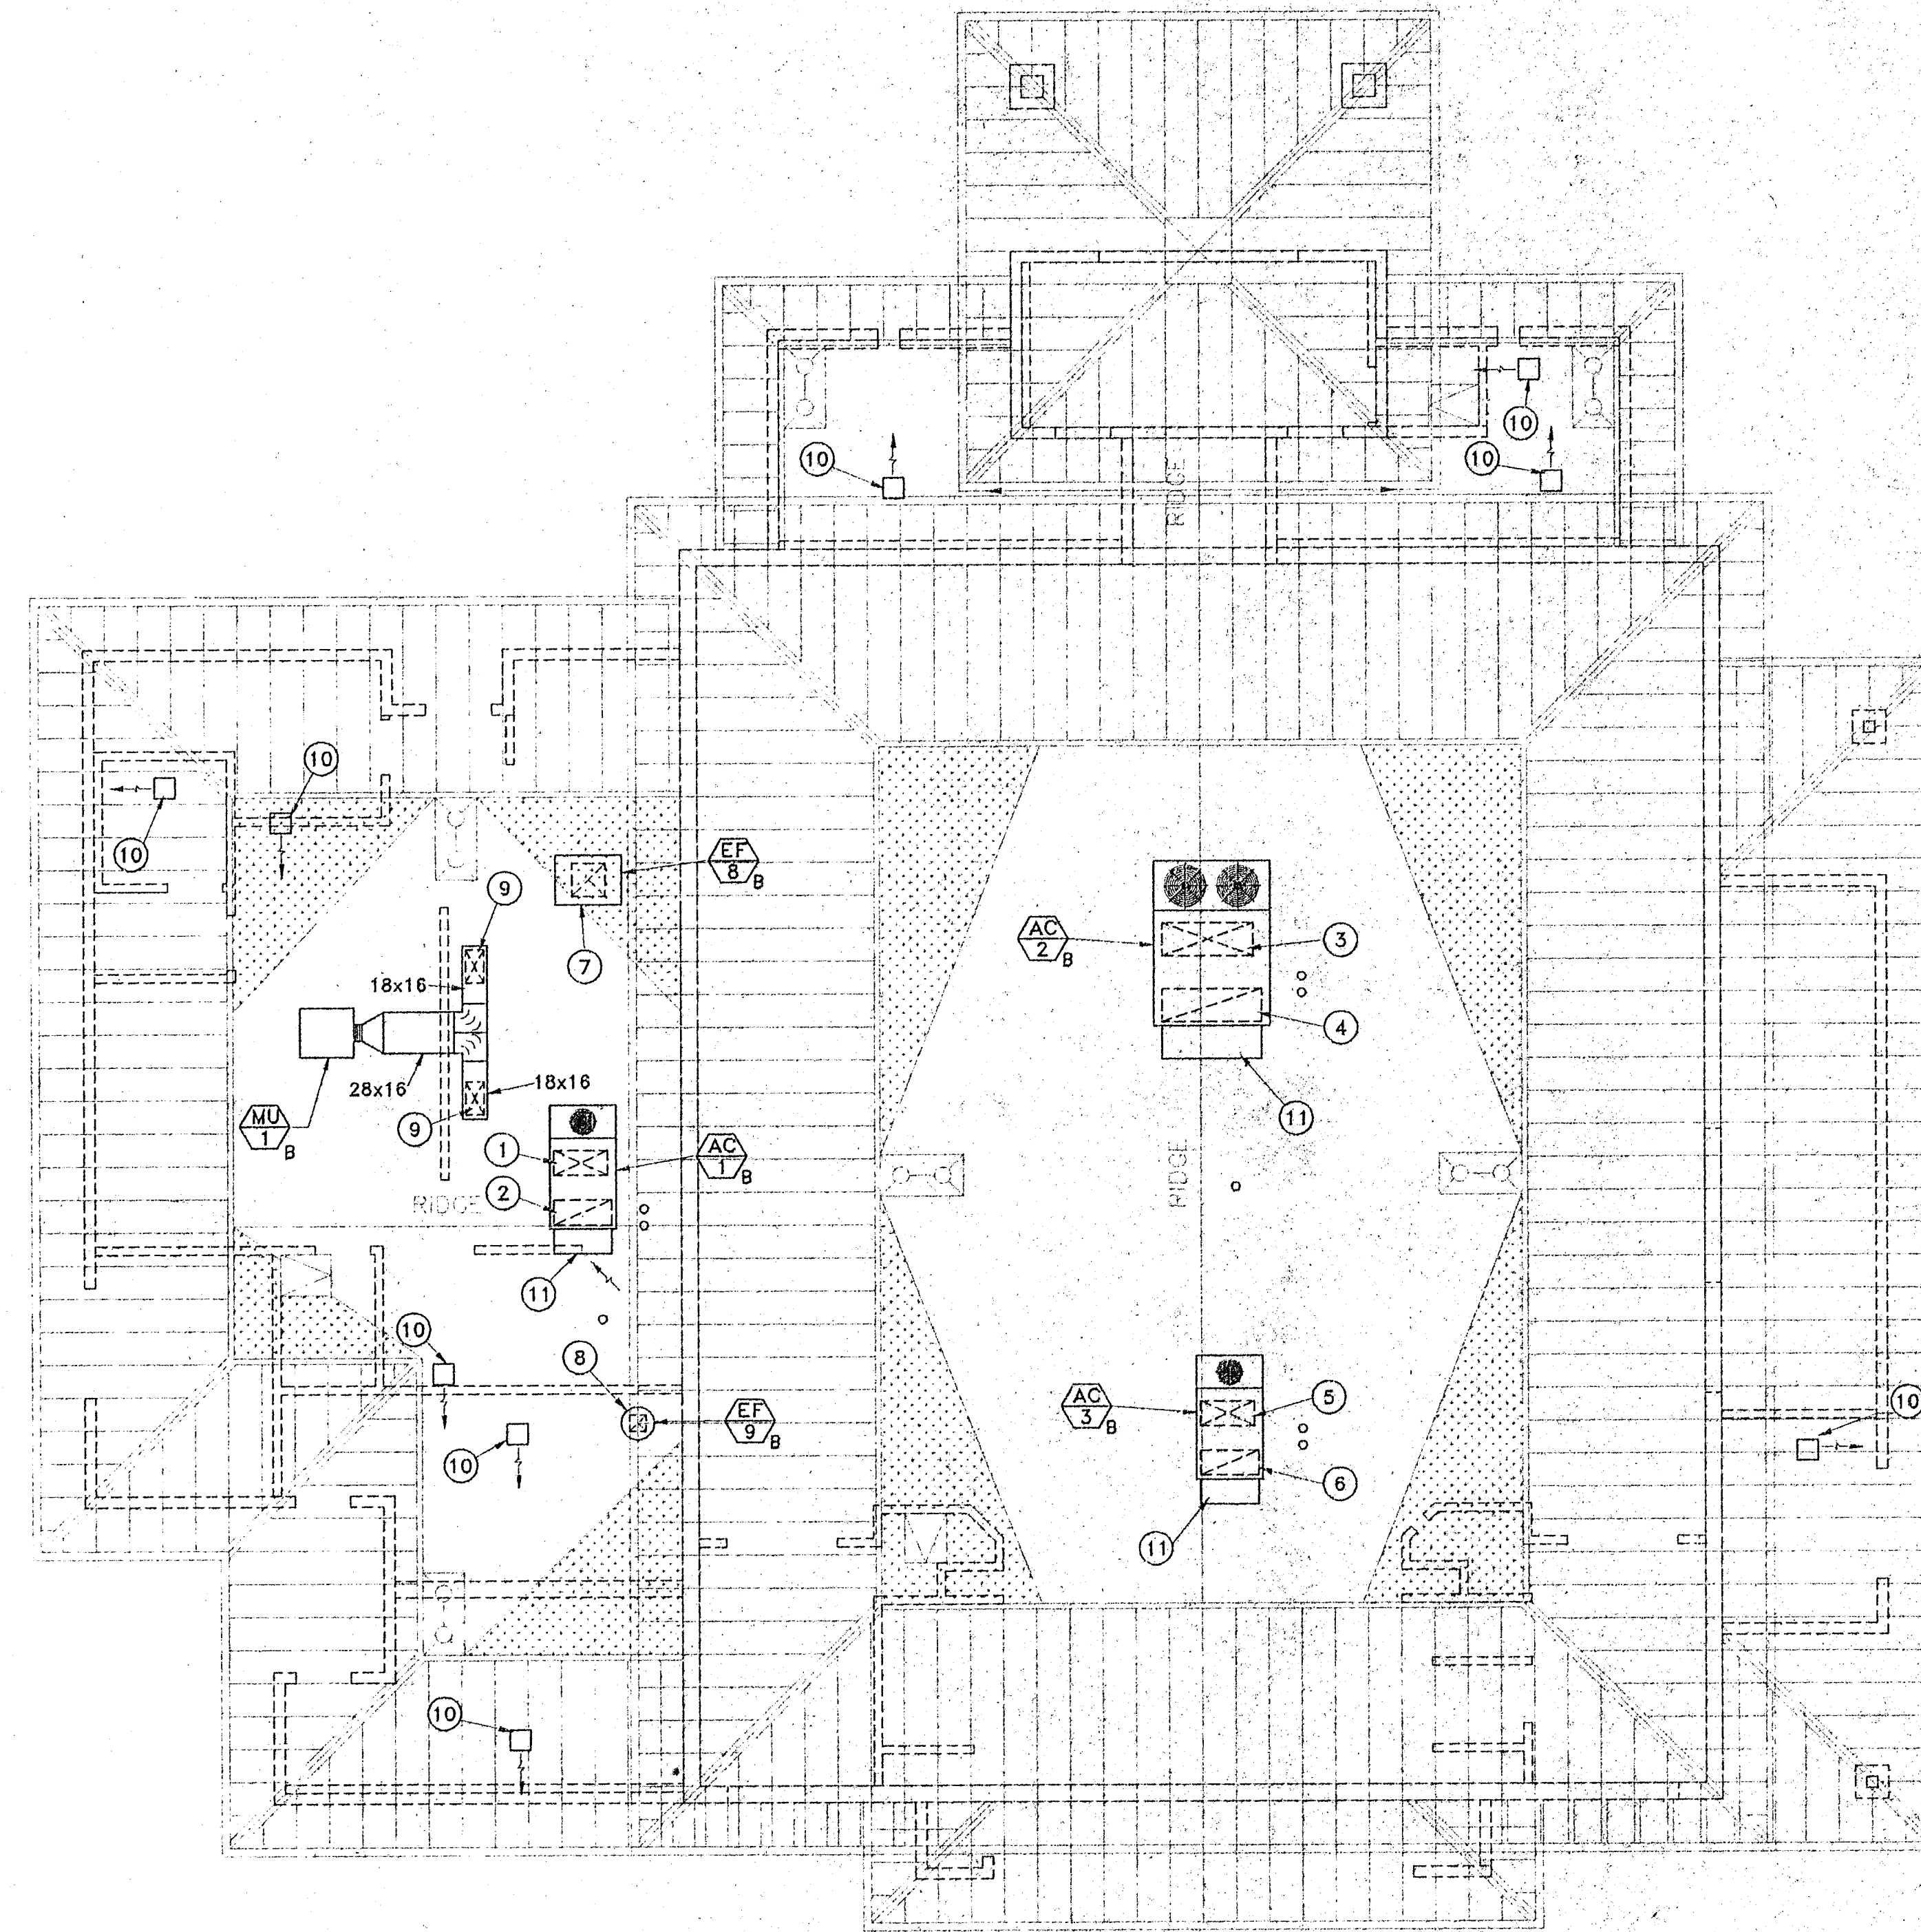

REFERENCE NOTES:


- ① 36"x16" LINED SUPPLY AIR DUCT DOWN.
- ② 40"x14" LINED RETURN AIR DUCT DOWN.
- ③ 66"x26" LINED SUPPLY AIR DUCT DOWN.
- ④ 72"x18" LINED RETURN AIR DUCT DOWN.
- ⑤ 44"x22" LINED SUPPLY AIR DUCT DOWN.
- ⑥ 52"x16" LINED RETURN AIR DUCT DOWN.
- ⑦ 24"x24" EXHAUST AIR DUCT DOWN.
- ⑧ 12"x12" EXHAUST AIR DUCT DOWN.
- ⑨ 10"x30" SUPPLY AIR DUCT DOWN.
- ⑩ ROOF JACK.
- ⑪ OUTSIDE AIR HOOD.



Virginia Dare Tower
10470 Foothill Blvd.
Rancho Cucamonga
California 91730-3754
tel: 909 987 0909
fax: 909 980 9980

Tovoshal Elementary School

Murrieta Valley
Unified School District

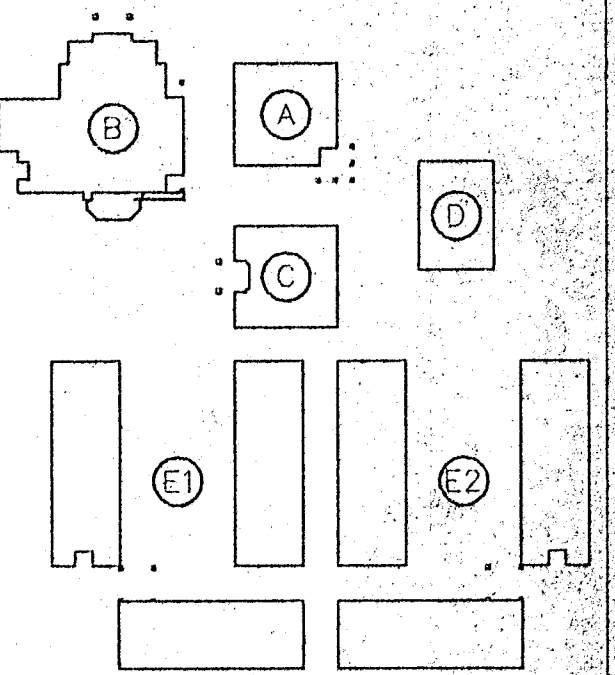


KEY PLAN


CONSULTANT

APPROVED

APPROVED

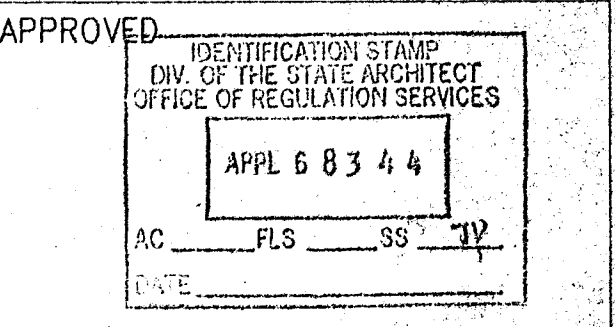

APPROVED

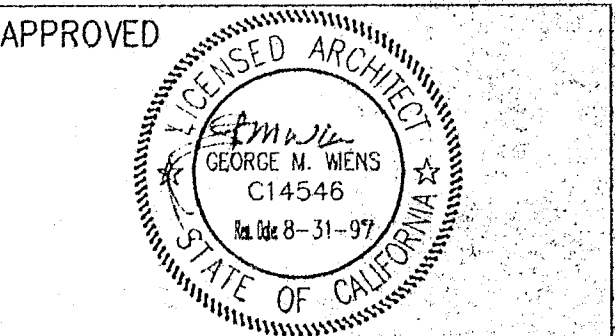

NO	DATE	BY	REMARKS

BLDG. B
ROOF
PLAN



DRAWN MFS
CHECKED SSM
DATE MAY 1997
SCALE 1/8"=1'-0"
JOB NO. 95113

M-B22


MECHANICAL ROOF PLAN

1/8"=1'-0"

1

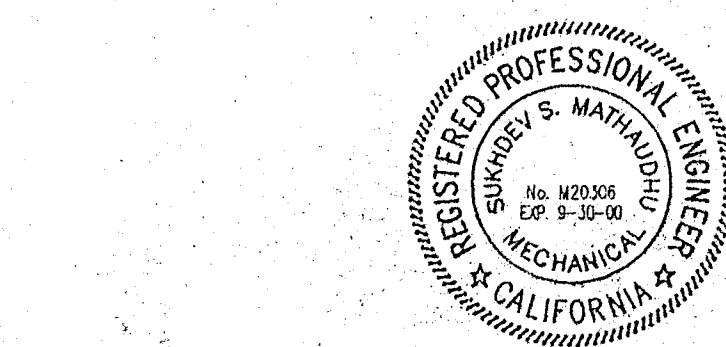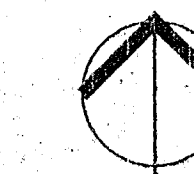


MATHAUDHU ENGINEERING, INC.
CONSULTING MECHANICAL ENGINEERS
3833 JURUPA AVENUE, RIVERSIDE, CALIFORNIA, 92506-2211
(909) 886-1776 FAX (909) 886-5061

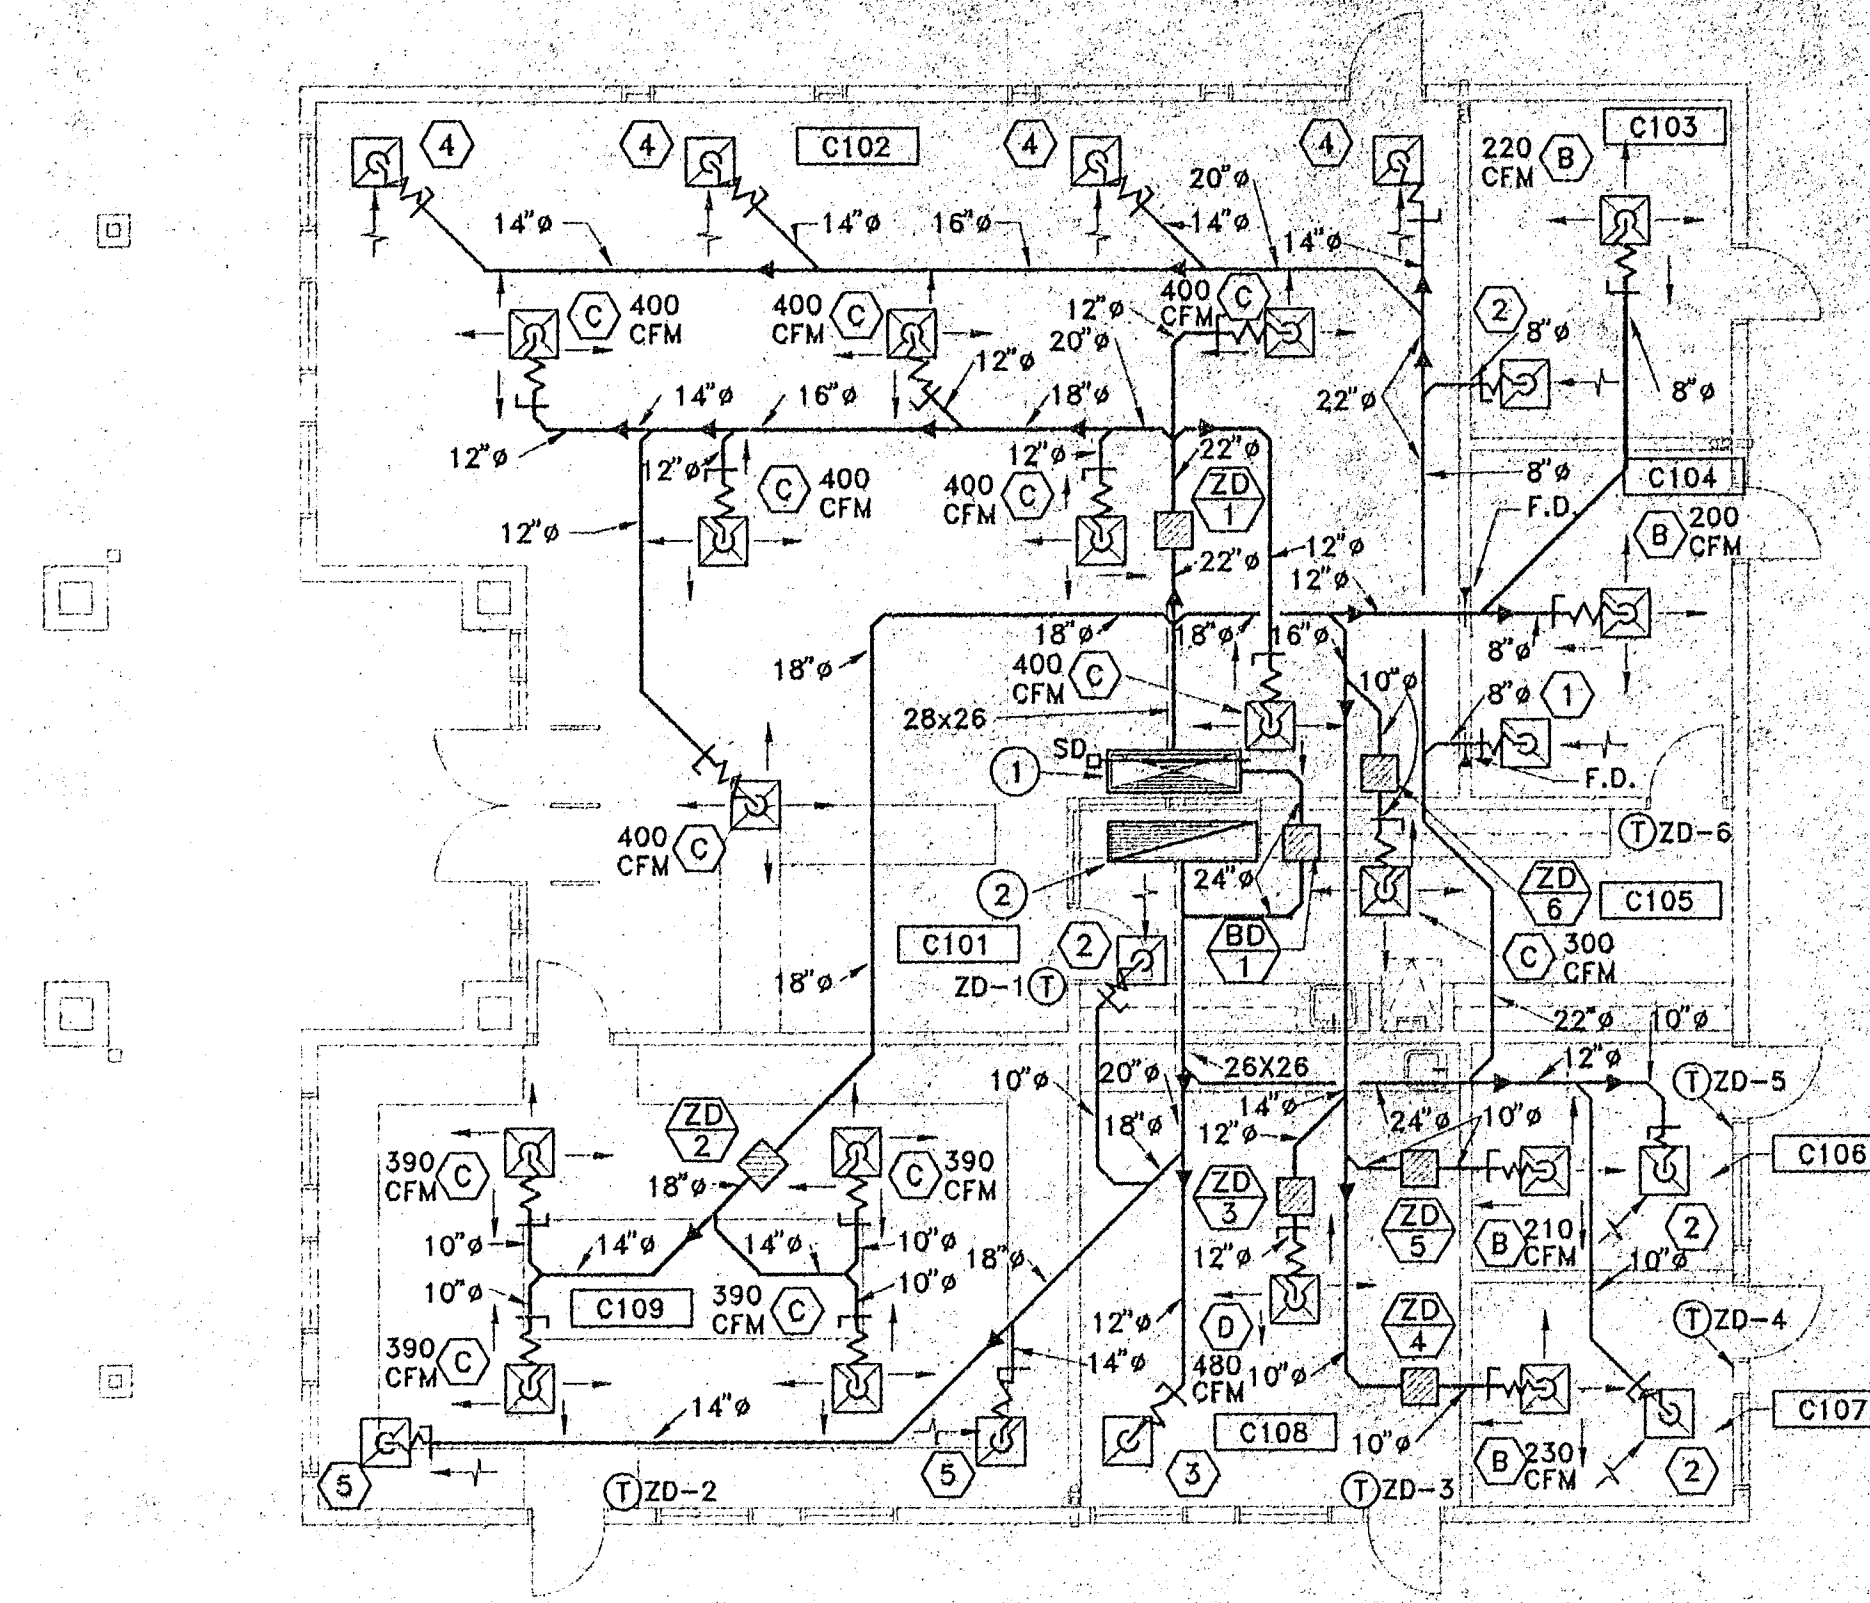

MECHANICAL FLOOR PLAN

1/8"=1'-0"

1

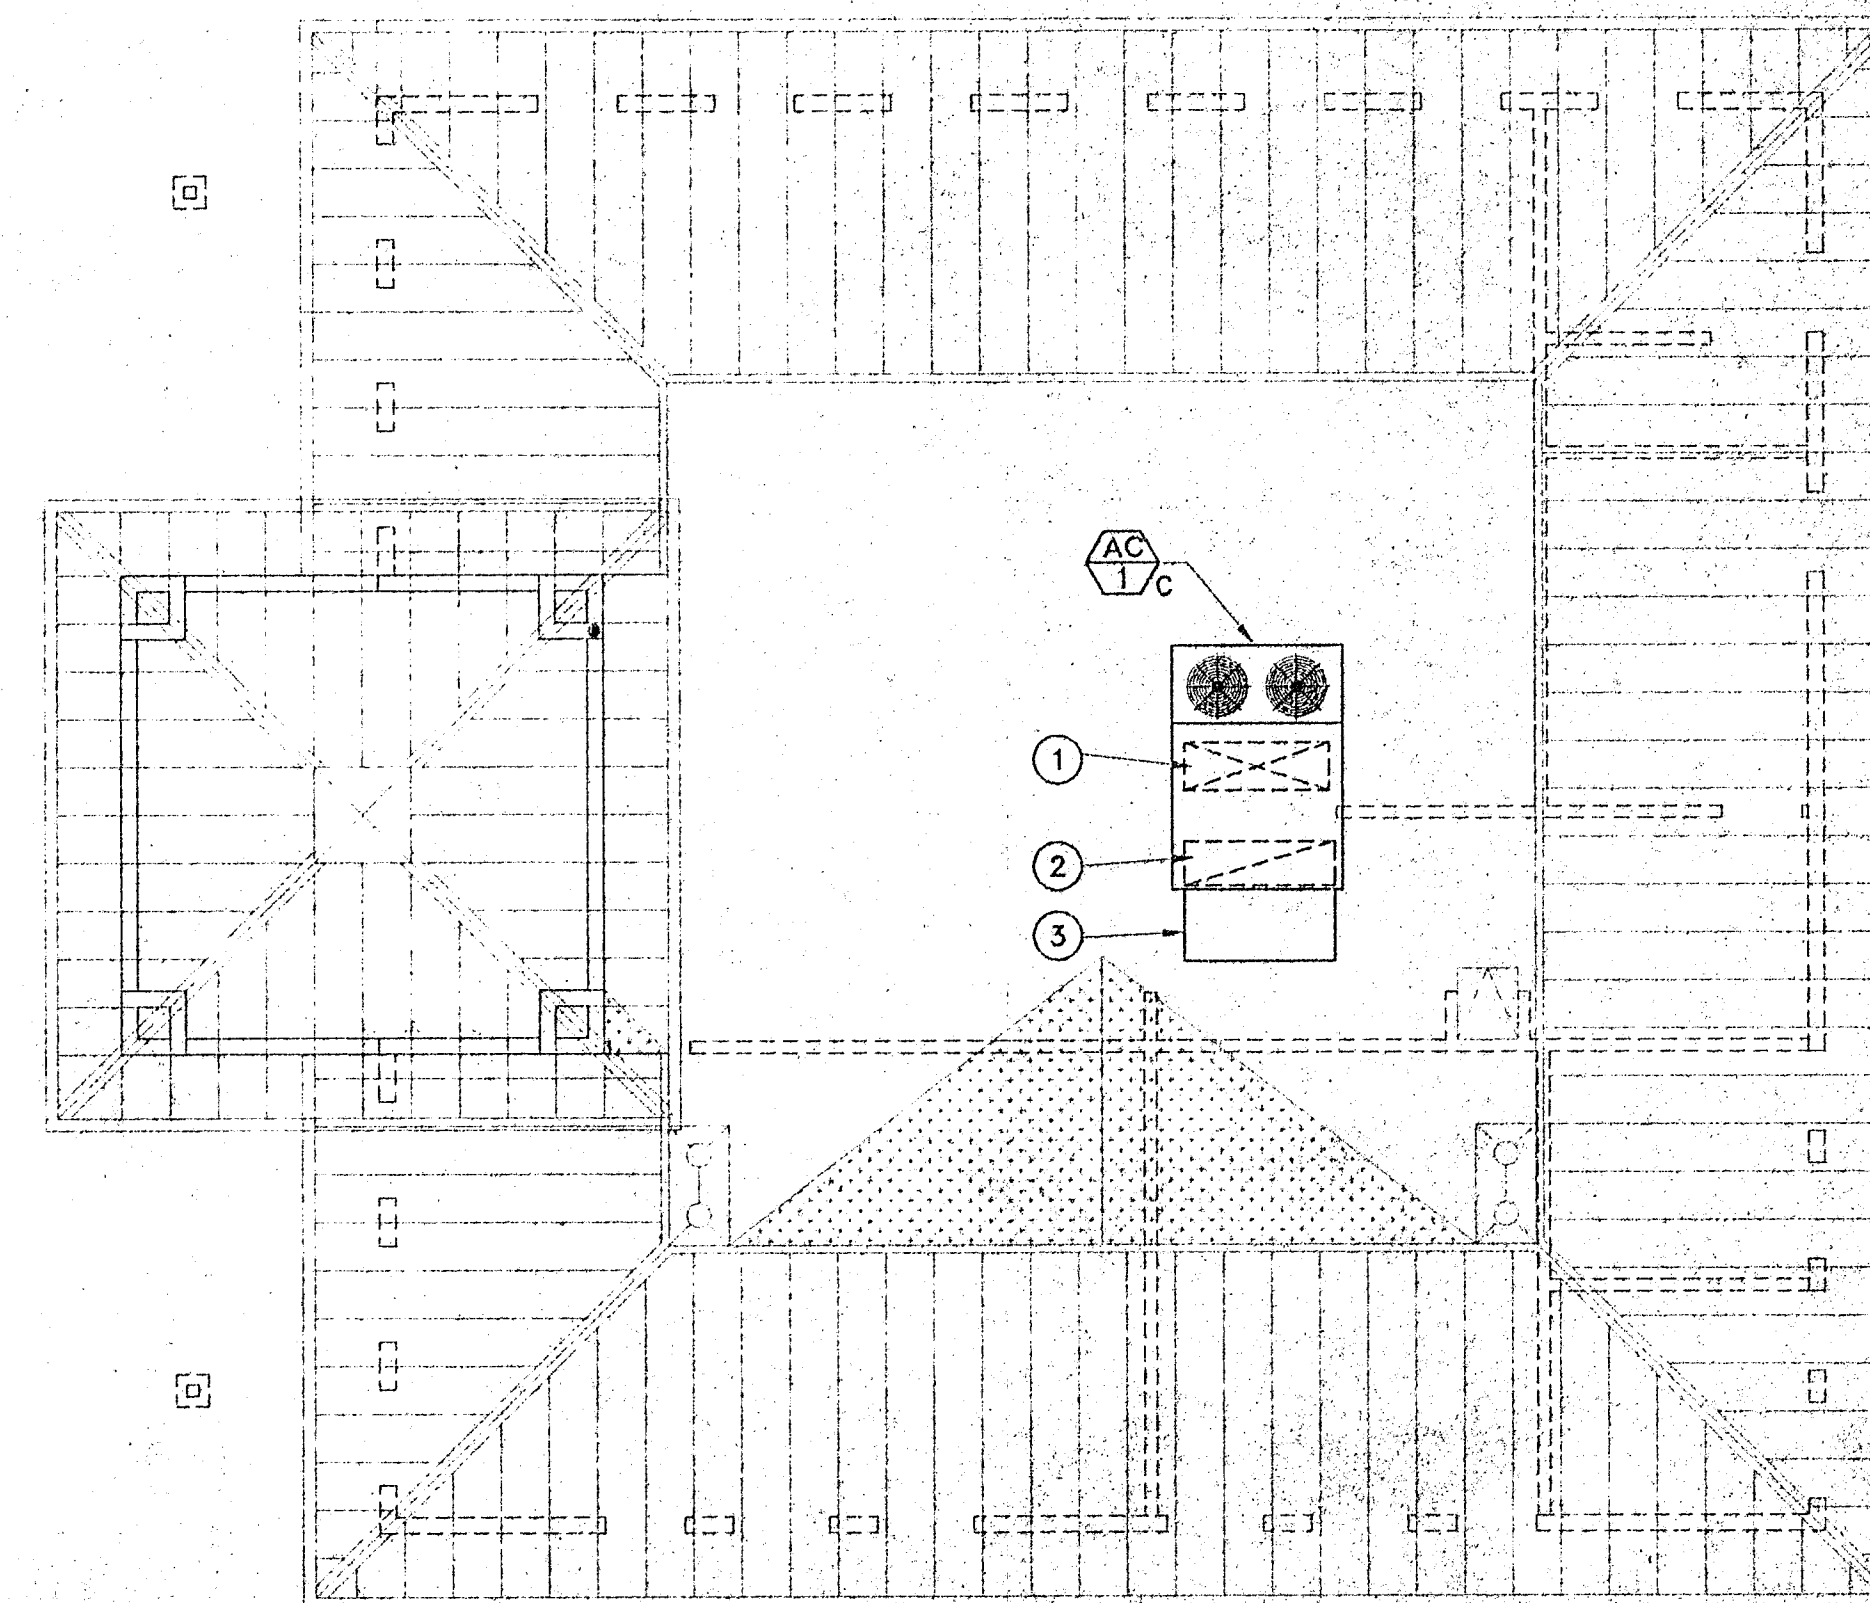

MECHANICAL ROOF PLAN

1/8"=1'-0"

2

REFERENCE NOTES:

- ① 66"x22" LINED SUPPLY AIR DUCT UP THRU ROOF TO AC-1C. PROVIDE FLEXIBLE CONNECTION AS REQUIRED.
- ② 74"x20" LINED RETURN AIR DUCT UP THRU ROOF TO AC-1C. PROVIDE FLEXIBLE CONNECTION AS REQUIRED.


REFERENCE NOTES:

- ① 66"x22" LINED SUPPLY AIR DUCT DOWN.
- ② 74"x20" LINED RETURN AIR DUCT DOWN.
- ③ OUTSIDE AIR HOOD.



Virginia Dare Tower
10470 Foothill Blvd
Rancho Cucamonga
California 91730-3754
tel: 909 987 0909
fax: 909 980 9980

Tovoshal Elementary School
Murrieta Valley
Unified School District

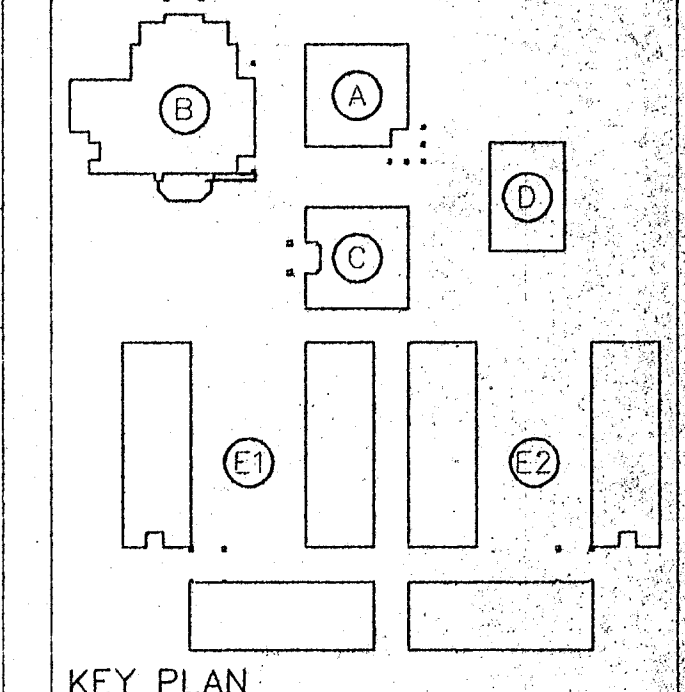

KEY PLAN

CONSULTANT

APPROVED

APPROVED
IDENTIFICATION STAMP
DIV. OF THE STATE ARCHITECT
OFFICE OF REGULATION SERVICES
APR 16 8 3 4 4
AC FL3 SS 07
DATE


APPROVED
LICENSED ARCHITECT
MATHAUDHU ENGINEERING, INC.
GEORGE M. WENS
C14546
12/28-31-99
STATE OF CALIFORNIA

NO	DATE	BY	REMARKS


**BLDG. C
FLOOR AND
ROOF PLAN**

DRAWN: MFS
CHECKED: SSM
DATE: MAY 1997
SCALE: 1/8"=1'-0"
JOB NO. 95113

M-C21

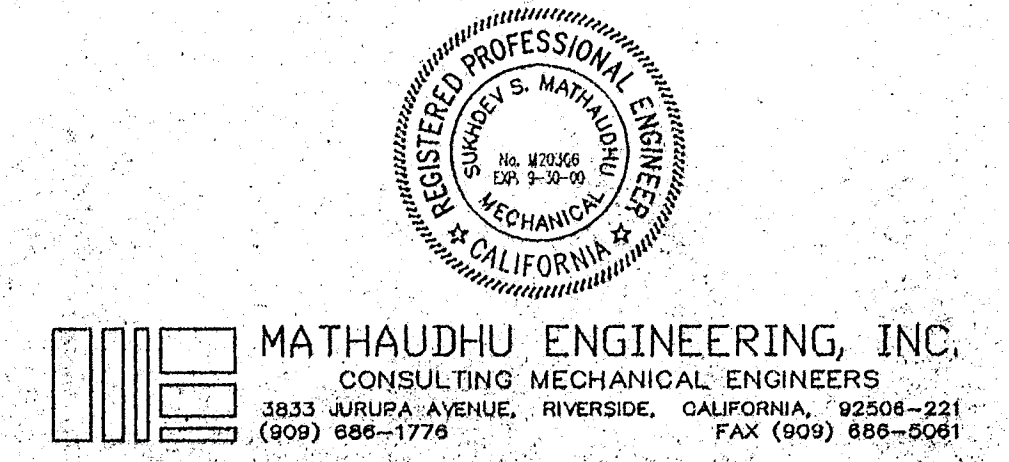

MATHAUDHU ENGINEERING, INC.
CONSULTING MECHANICAL ENGINEERS
3833 AURIPA AVENUE, RIVERSIDE, CALIFORNIA, 92506-2211
(951) 536-1779 FAX (951) 658-2067

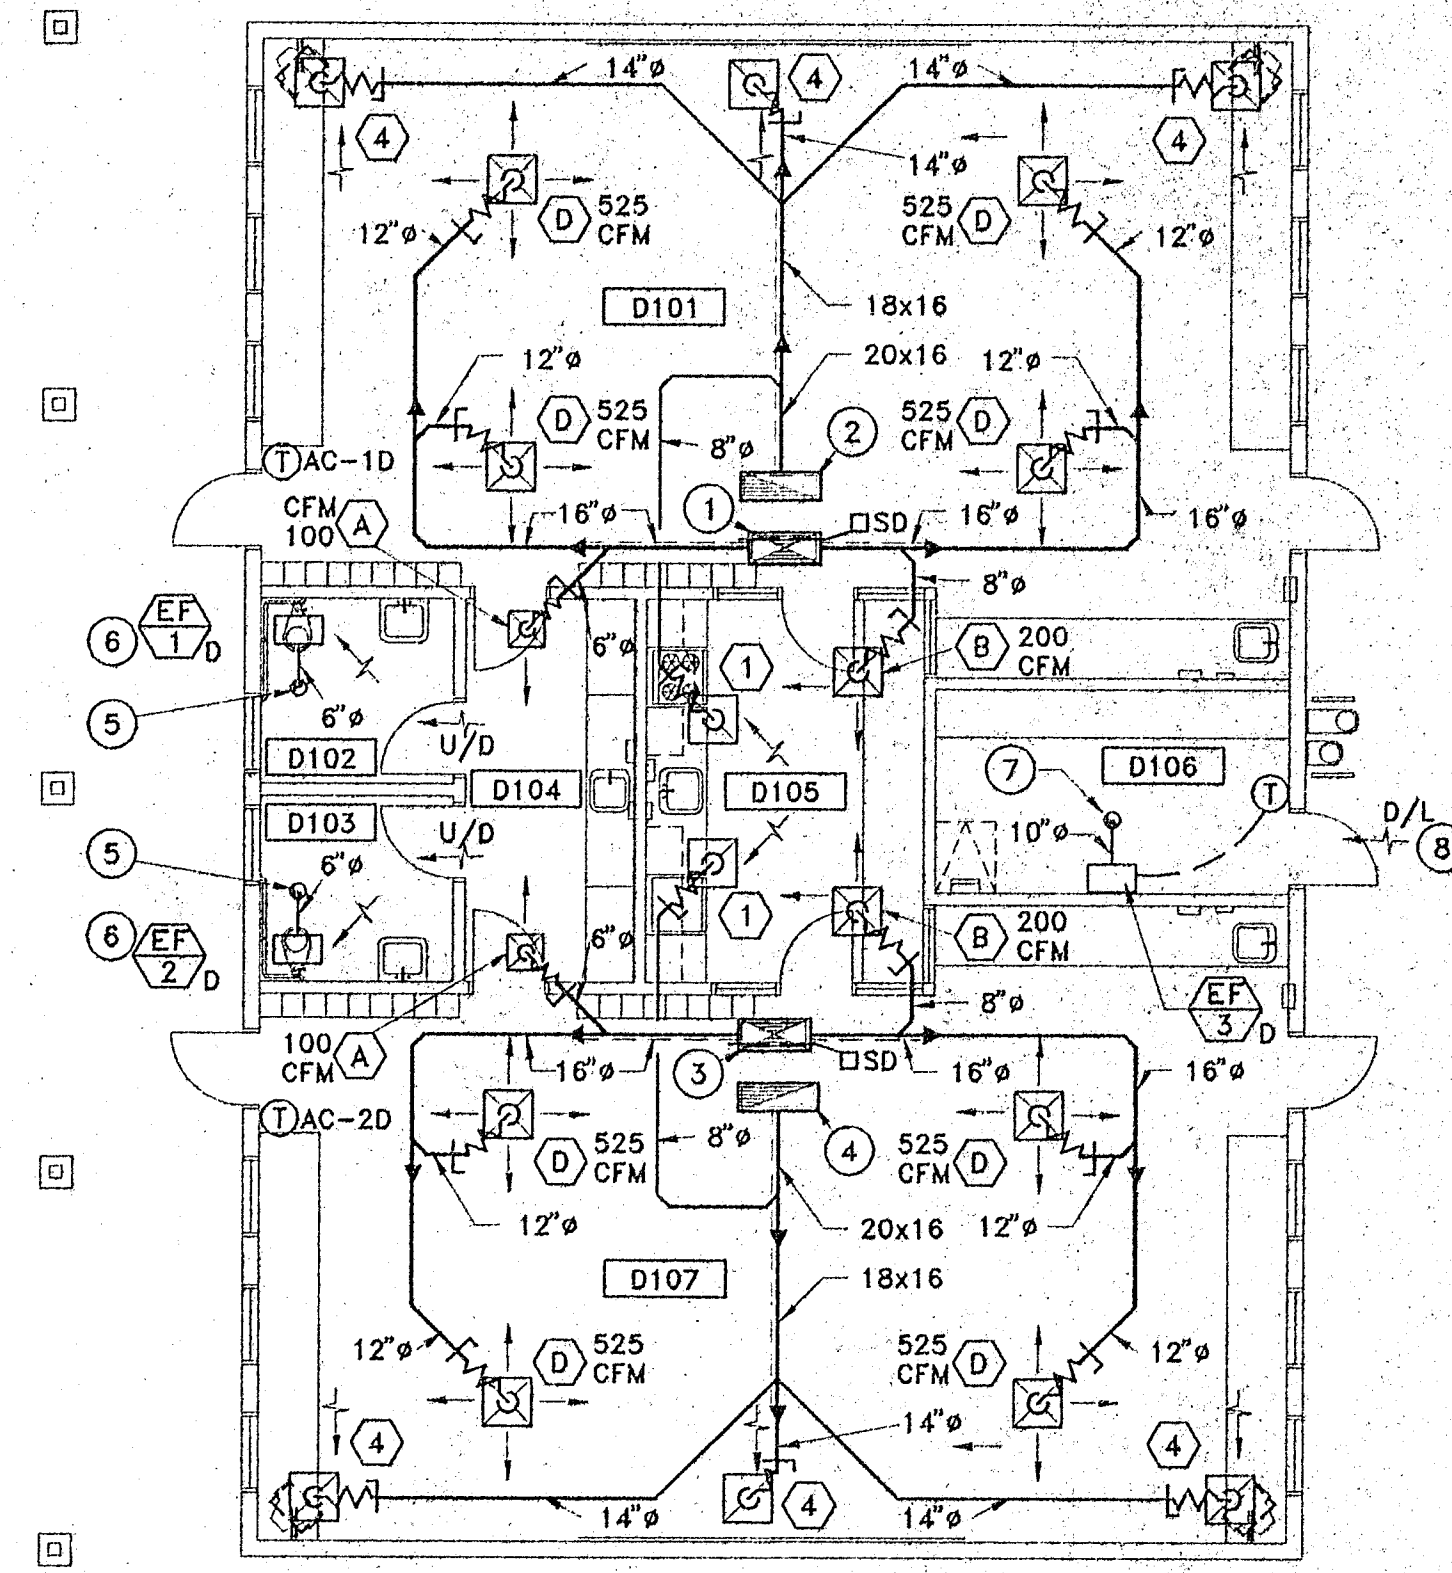

MECHANICAL FLOOR PLAN


1/8"=1'-0" 1

REFERENCE NOTES:

- ① 36"x16" LINED SUPPLY AIR DUCT UP THRU ROOF TO AC-1D. PROVIDE FLEXIBLE CONNECTION AS REQUIRED.
- ② 40"x14" LINED RETURN AIR DUCT UP THRU ROOF TO AC-1D. PROVIDE FLEXIBLE CONNECTION AS REQUIRED.
- ③ 36"x16" LINED SUPPLY AIR DUCT UP THRU ROOF TO AC-2D. PROVIDE FLEXIBLE CONNECTION AS REQUIRED.
- ④ 40"x14" LINED RETURN AIR DUCT UP THRU ROOF TO AC-2D. PROVIDE FLEXIBLE CONNECTION AS REQUIRED.
- ⑤ 6" EXHAUST AIR DUCT UP THRU ROOF AND CONNECT TO ROOF JACK. PROVIDE TRANSITION AS REQUIRED. CONNECT DUCT TO EXHAUST FAN WITH FLEXIBLE CONNECTORS.
- ⑥ EXHAUST FAN IN CEILING PLENUM.
- ⑦ 10" EXHAUST AIR DUCT UP THRU ROOF AND CONNECT TO ROOF JACK. PROVIDE TRANSITION AS REQUIRED. CONNECT DUCT TO EXHAUST FAN WITH FLEXIBLE CONNECTORS.
- ⑧ 24" X 12" DOOR LOUVER W/SCREEN (BY OTHERS).

Virginia Dare Tower
10470 Foothill Blvd
Rancho Cucamonga
California 91730-3754
Tel: 909 987 0909
Fax: 909 980 9980

Tovoshal Elementary School
Murrieta Valley
Unified School District

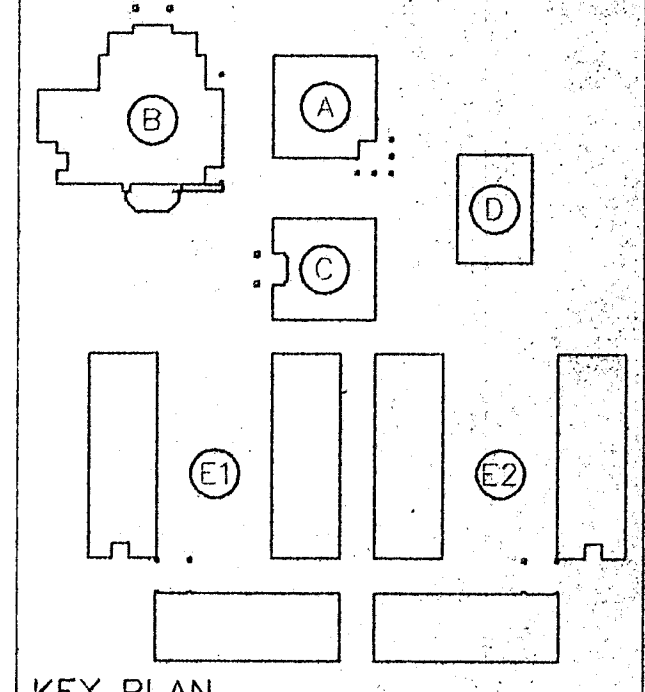

KEY PLAN

CONSULTANT

APPROVED

APPROVED
IDENTIFICATION STAMP
DIV. OF THE STATE ARCHITECT
OFFICE OF REGULATION SERVICES
APPL 6 8 3 4 4
AC FLS 12 38 27
DATE


APPROVED
REGISTERED ARCHITECT
FRENCH H. WELLS
C14546
EXPIRES 8-31-99
STATE OF CALIFORNIA

NO	DATE	BY	REMARKS

**BLDG. D
FLOOR AND
ROOF PLAN**

DRAWN MFS
CHECKED SSM
DATE MAY 1997
SCALE 1/8"=1'-0"
JOB NO. 95113

M-D21

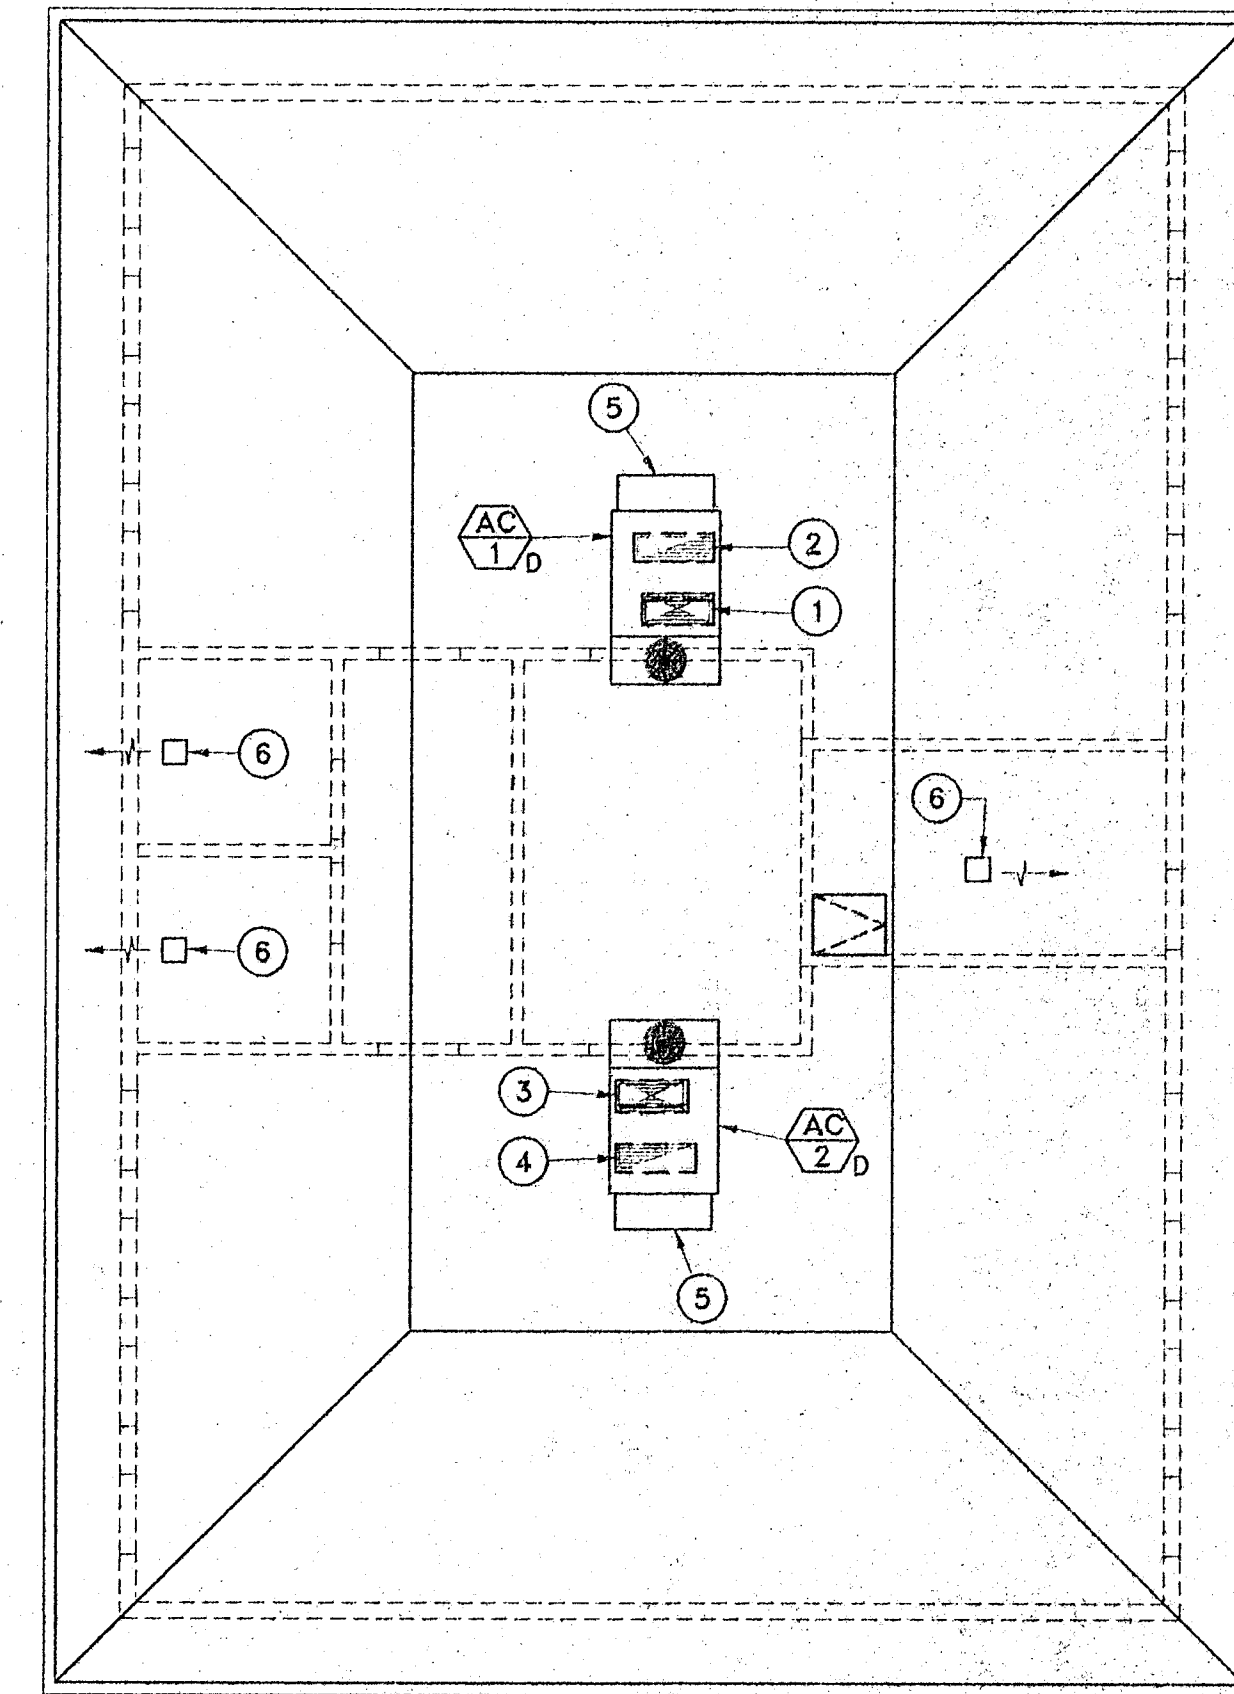


MECHANICAL ROOF PLAN



1/8"=1'-0" 2

REFERENCE NOTES:

- ① 36"x16" LINED SUPPLY AIR DUCT DOWN.
- ② 40"x14" LINED RETURN AIR DUCT DOWN.
- ③ 36"x16" LINED SUPPLY AIR DUCT DOWN.
- ④ 40"x14" LINED RETURN AIR DUCT DOWN.
- ⑤ OUTSIDE AIR HOOD.
- ⑥ ROOF JACK.


MATHAUDHU ENGINEERING, INC.
CONSULTING MECHANICAL ENGINEERS
2833 AIRIPA AVENUE, RIVERSIDE, CALIFORNIA, 92508-221
(909) 698-1170 FAX (909) 698-6081

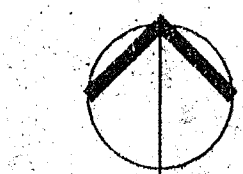

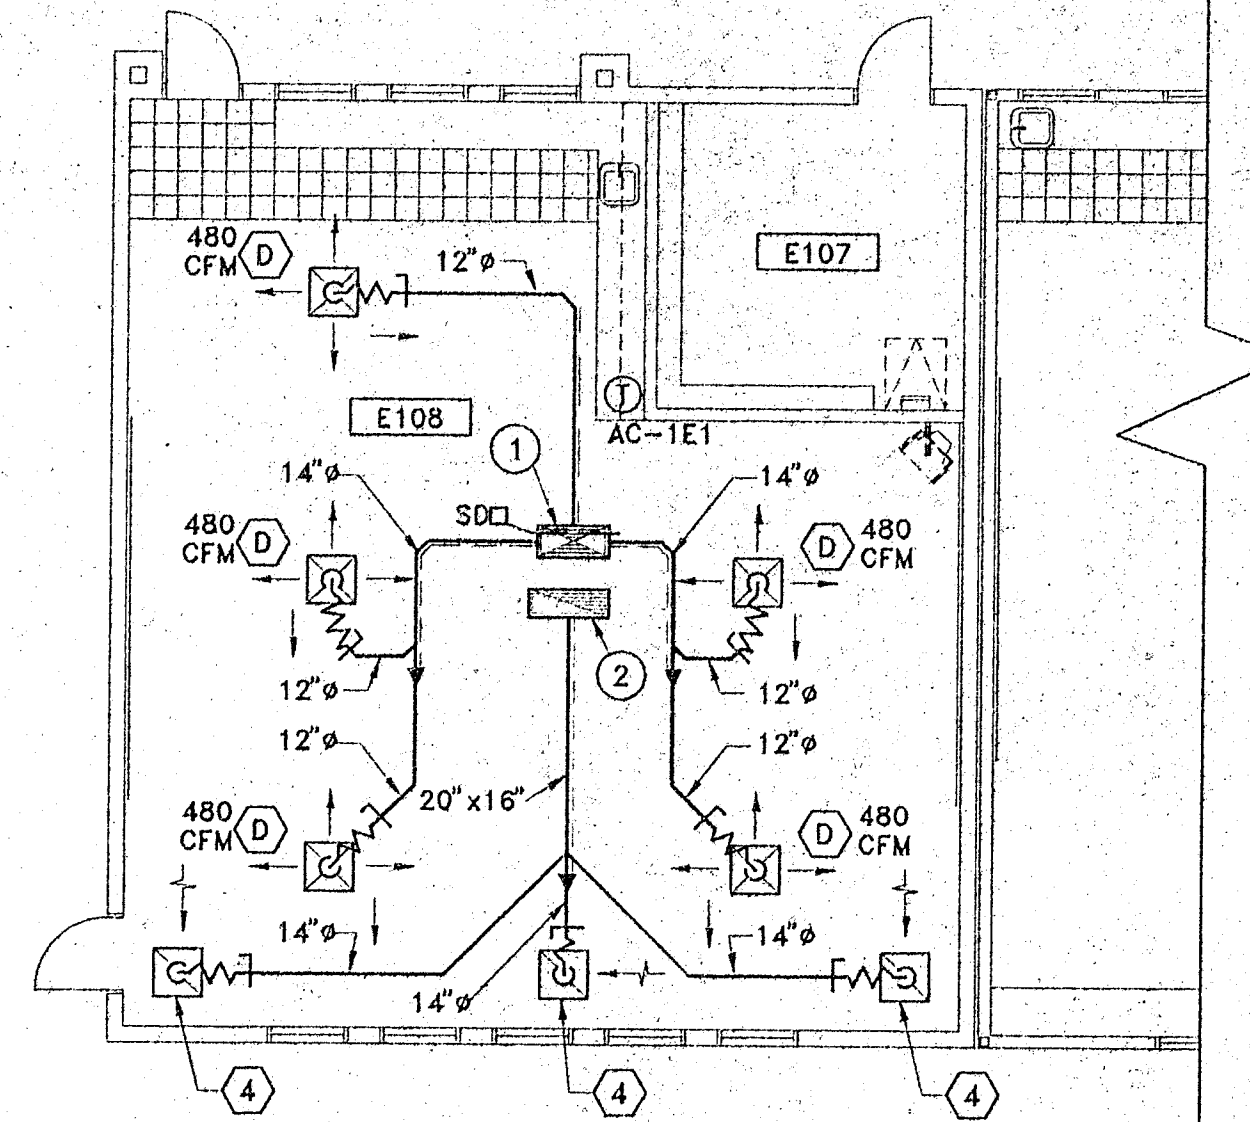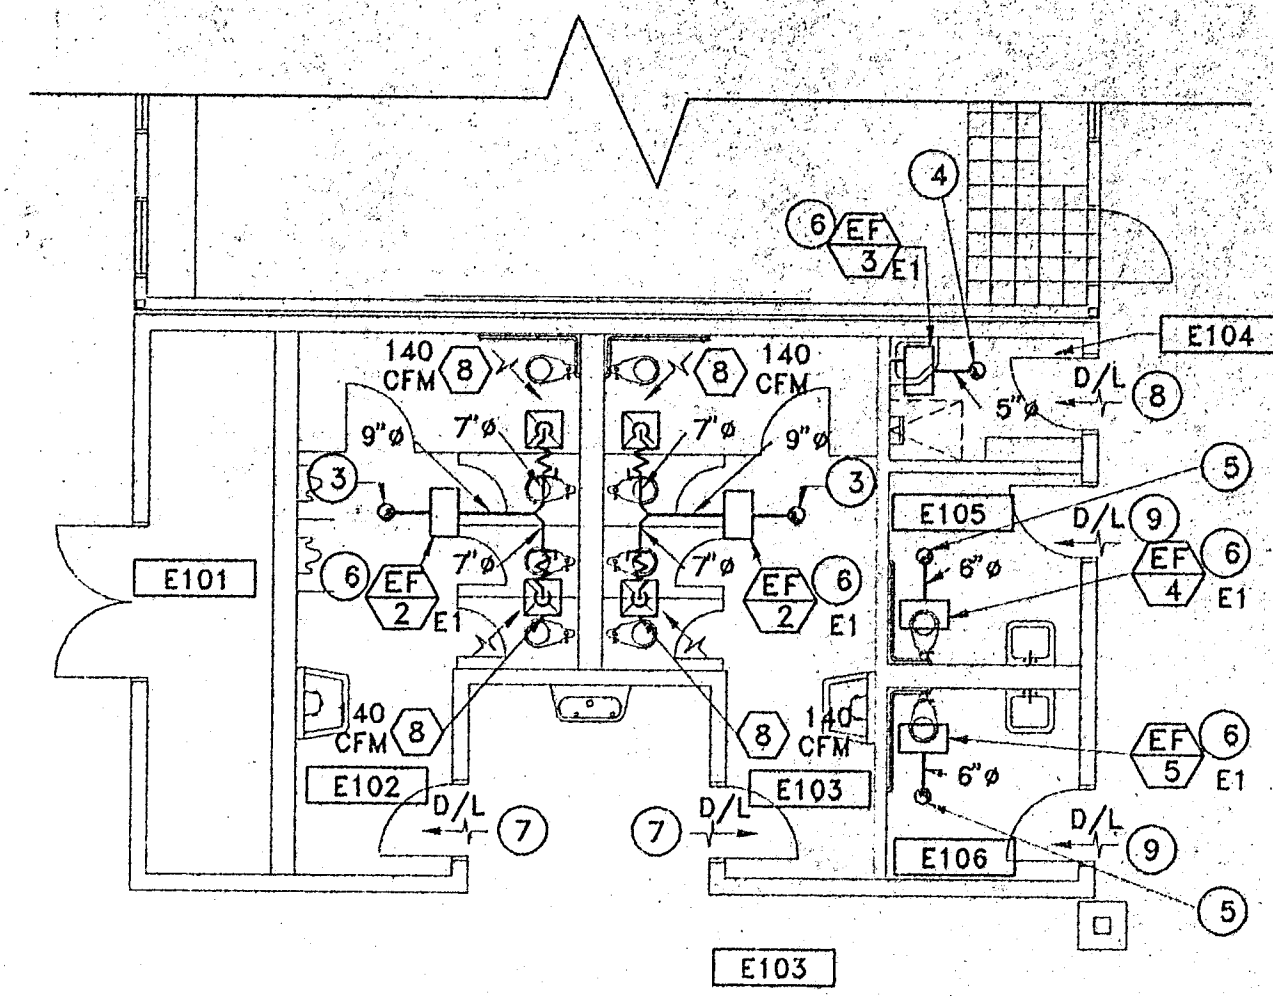

MECHANICAL FLOOR PLAN

1/8"=1'-0" 1

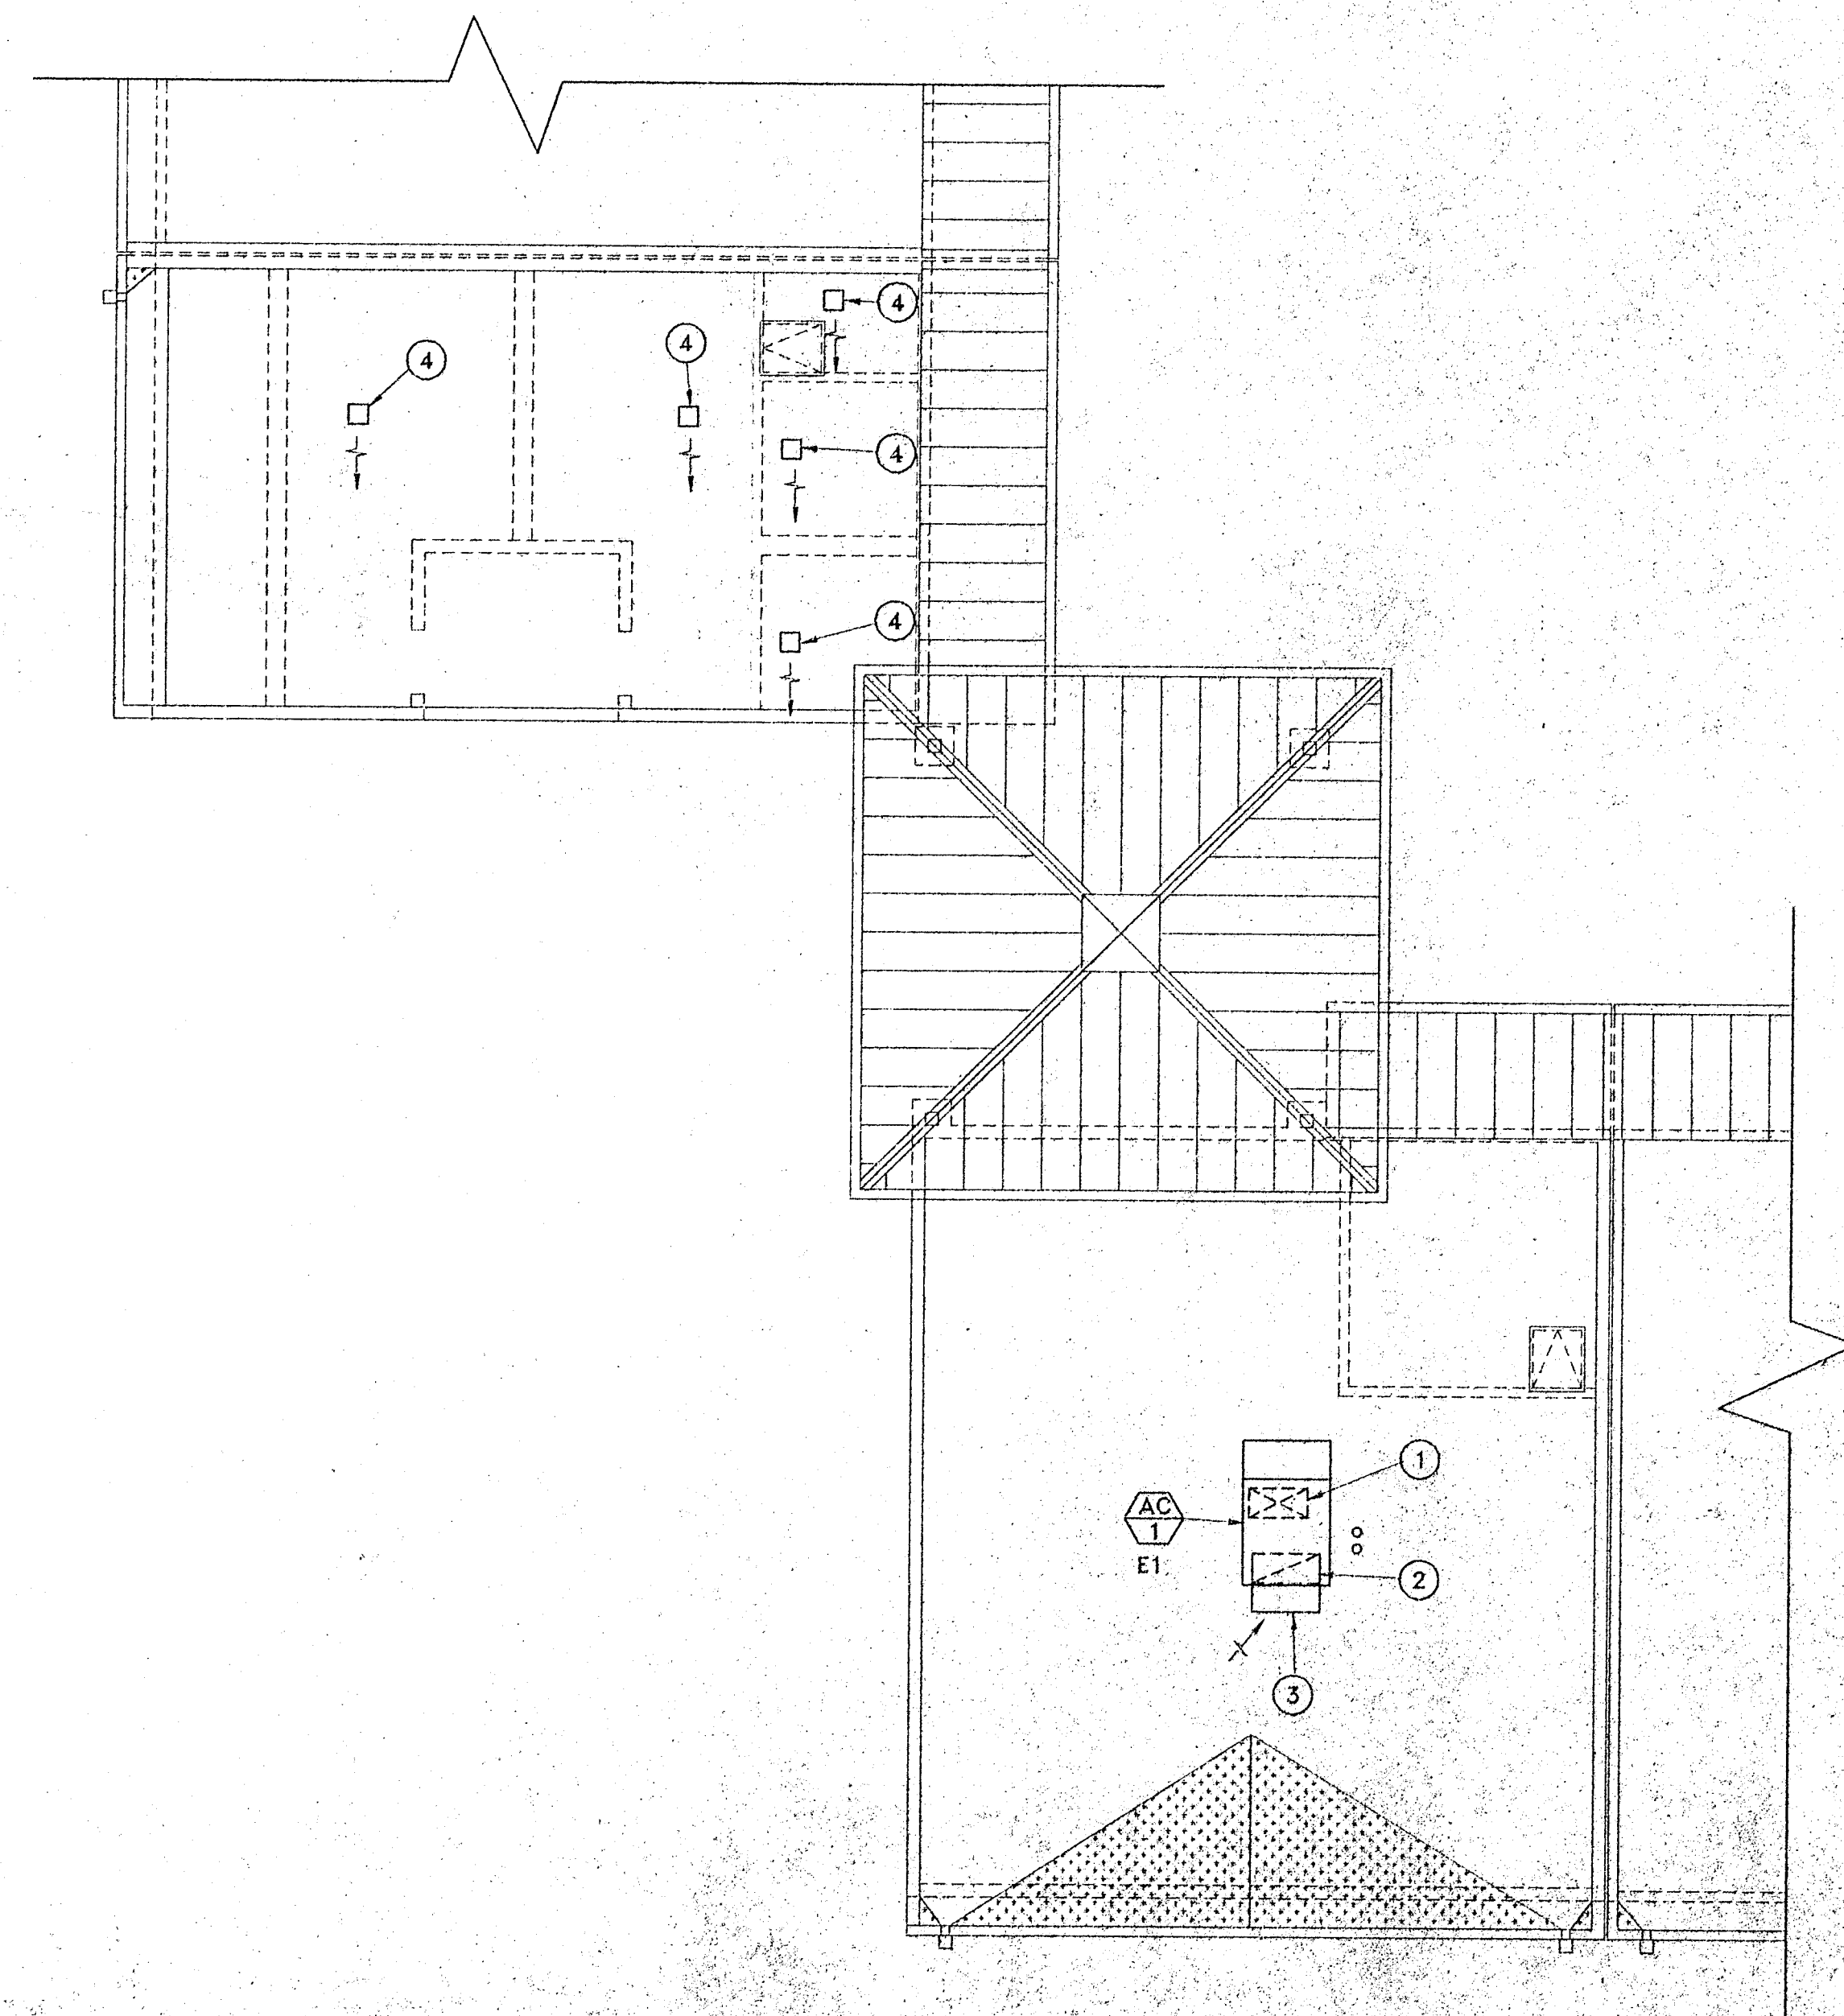

MECHANICAL ROOF PLAN

1/8"=1'-0" 2

REFERENCE NOTES:

- ① 36"x16" LINED SUPPLY AIR DUCT UP THRU ROOF TO AC-1E1. PROVIDE FLEXIBLE CONNECTION AS REQUIRED.
- ② 40"x14" LINED RETURN AIR DUCT UP THRU ROOF TO AC-1E1. PROVIDE FLEXIBLE CONNECTION AS REQUIRED.
- ③ 9" EXHAUST AIR DUCT UP THRU ROOF AND CONNECT TO ROOF JACK. PROVIDE TRANSITION AS REQUIRED. CONNECT DUCT TO EXHAUST FAN WITH FLEXIBLE CONNECTORS.
- ④ 5" EXHAUST AIR DUCT UP THRU ROOF AND CONNECT TO ROOF JACK. PROVIDE TRANSITION AS REQUIRED. CONNECT DUCT TO EXHAUST FAN WITH FLEXIBLE CONNECTORS.
- ⑤ 6" EXHAUST AIR DUCT UP THRU ROOF AND CONNECT TO ROOF JACK. PROVIDE TRANSITION AS REQUIRED. CONNECT DUCT TO EXHAUST FAN WITH FLEXIBLE CONNECTORS.
- ⑥ EXHAUST FAN IN CEILING PLENUM.
- ⑦ 24" x 12" DOOR LOUVER W/ SCREEN (BY OTHERS).
- ⑧ 24" x 12" DOOR LOUVER W/ SCREEN (BY OTHERS).
- ⑨ 24" x 12" DOOR LOUVER W/ SCREEN (BY OTHERS).


REFERENCE NOTES:

- ① 36"x16" LINED SUPPLY AIR DOWN.
- ② 40"x14" LINED RETURN AIR DUCT DOWN.
- ③ OUTSIDE AIR HOOD.
- ④ ROOF JACK.



Virginia Dare Tower
10470 Foothill Blvd.
Rancho Cucamonga
California 91730-3754
tel: 909 987 0909
fax: 909 980 9980

Tovoshal Elementary School
Murrieta Valley
Unified School District

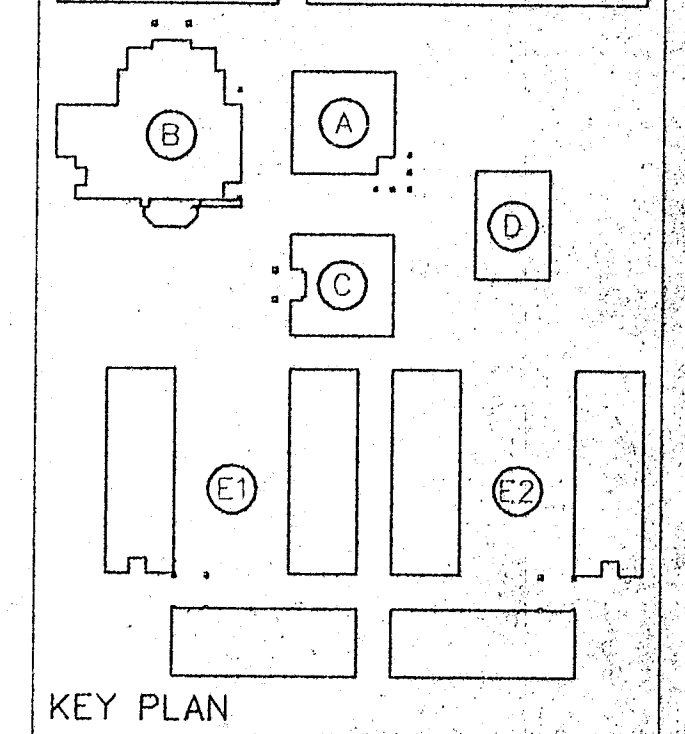


KEY PLAN


CONSULTANT

APPROVED

APPROVED

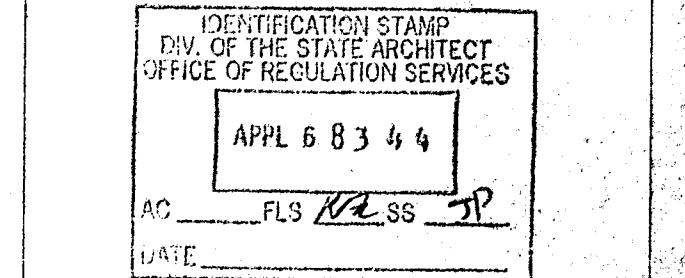

APPROVED

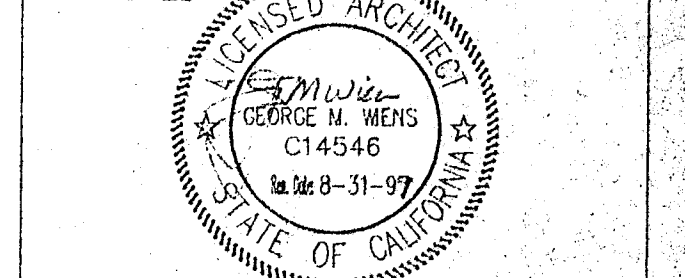


NO	DATE	BY	REMARKS



**BLDG. E (AREA 1)
FLOOR AND
ROOF PLAN**

DRAWN MFS
CHECKED SSM
DATE MAY 1997
SCALE 1/8"=1'-0"
JOB NO. 95113

M-E21

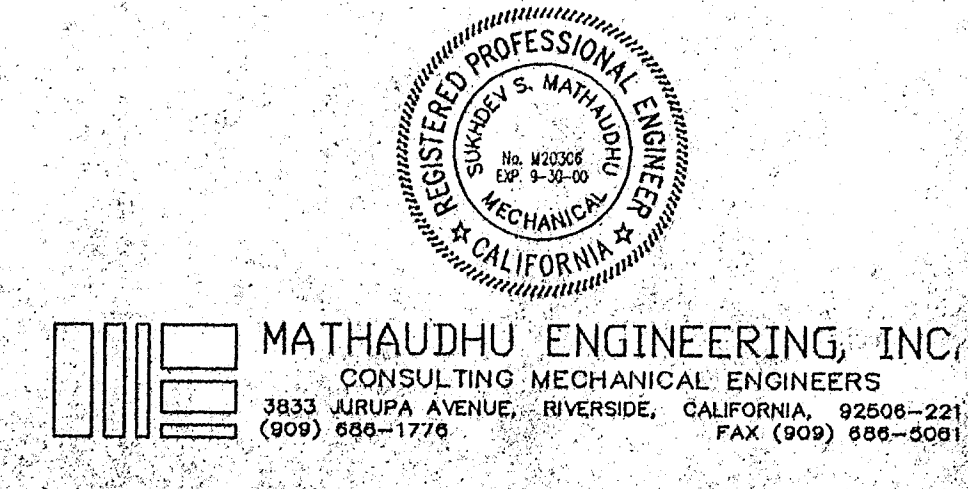

MATHAUDHU ENGINEERING, INC.
CONSULTING MECHANICAL ENGINEERS
3833 ARAPA AVENUE, RIVERSIDE, CALIFORNIA, 92506-2211
(909) 596-1776 FAX (909) 496-5081

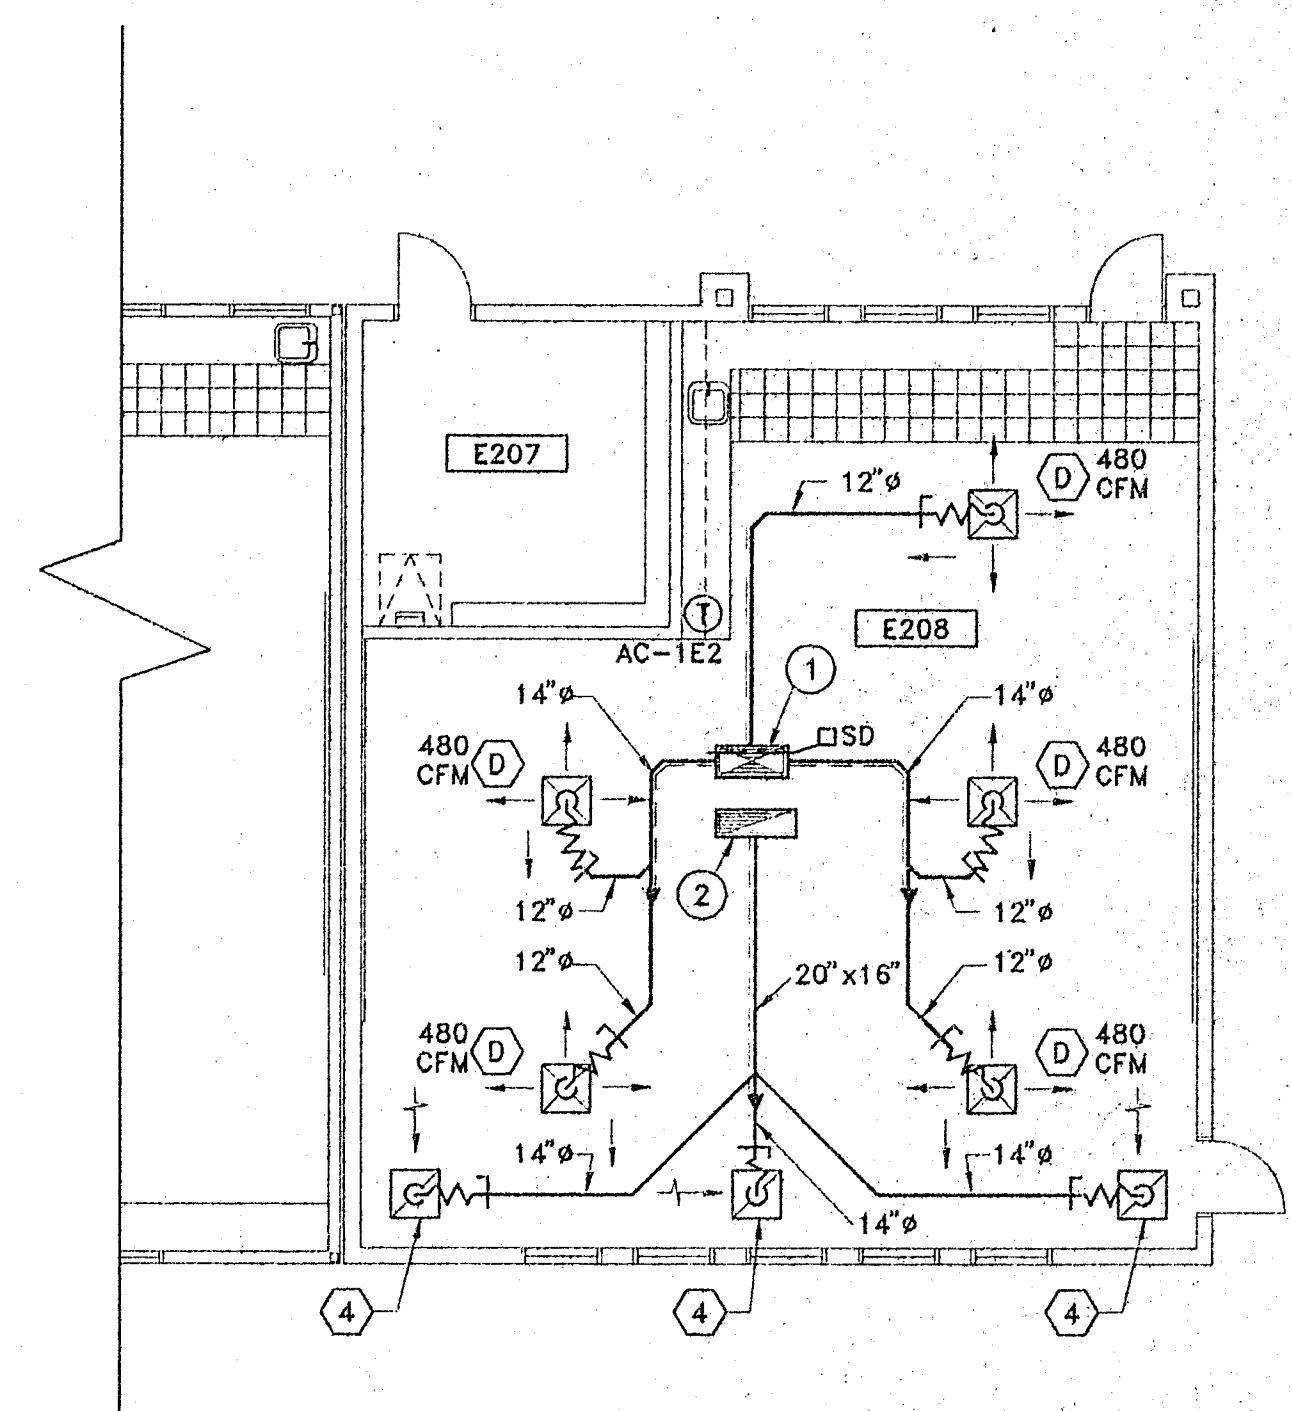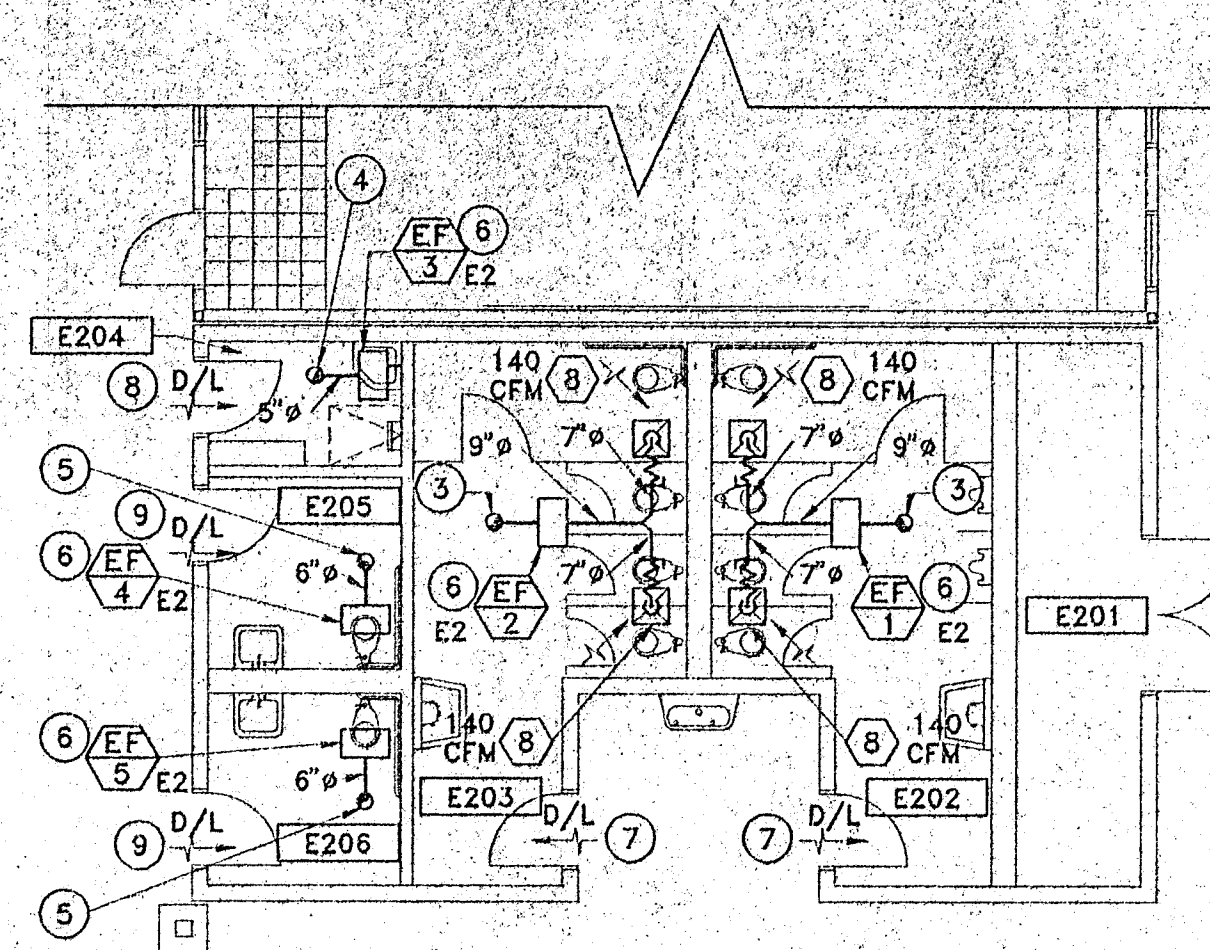


MECHANICAL FLOOR PLAN

1/8"=1'-0" 1


REFERENCE NOTES:

- ① 36"x16" LINED SUPPLY AIR DUCT UP THRU ROOF TO AC-1E2. PROVIDE FLEXIBLE CONNECTION AS REQUIRED.
- ② 40"x14" LINED RETURN AIR DUCT UP THRU ROOF TO AC-1E2. PROVIDE FLEXIBLE CONNECTION AS REQUIRED.
- ③ 9" EXHAUST AIR DUCT UP THRU ROOF AND CONNECT TO ROOF JACK. PROVIDE TRANSITION AS REQUIRED. CONNECT DUCT TO EXHAUST FAN WITH FLEXIBLE CONNECTORS.
- ④ 5" EXHAUST AIR DUCT UP THRU ROOF AND CONNECT TO ROOF JACK. PROVIDE TRANSITION AS REQUIRED. CONNECT DUCT TO EXHAUST FAN WITH FLEXIBLE CONNECTORS.
- ⑤ 6" EXHAUST AIR DUCT UP THRU ROOF AND CONNECT TO ROOF JACK. PROVIDE TRANSITION AS REQUIRED. CONNECT DUCT TO EXHAUST FAN WITH FLEXIBLE CONNECTORS.
- ⑥ EXHAUST FAN IN CEILING PLENUM.
- ⑦ 24" x 12" DOOR LOUVER W/ SCREEN (BY OTHERS).
- ⑧ 24" x 12" DOOR LOUVER W/ SCREEN (BY OTHERS).
- ⑨ 24" x 12" DOOR LOUVER W/ SCREEN (BY OTHERS).

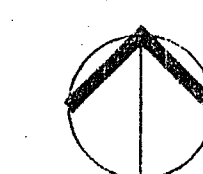


REFERENCE NOTES:

- ① 36"x16" LINED SUPPLY DUCT AIR DOWN.
- ② 40"x14" LINED RETURN AIR DUCT DOWN.
- ③ OUTSIDE AIR HOOD.
- ④ ROOF JACK.

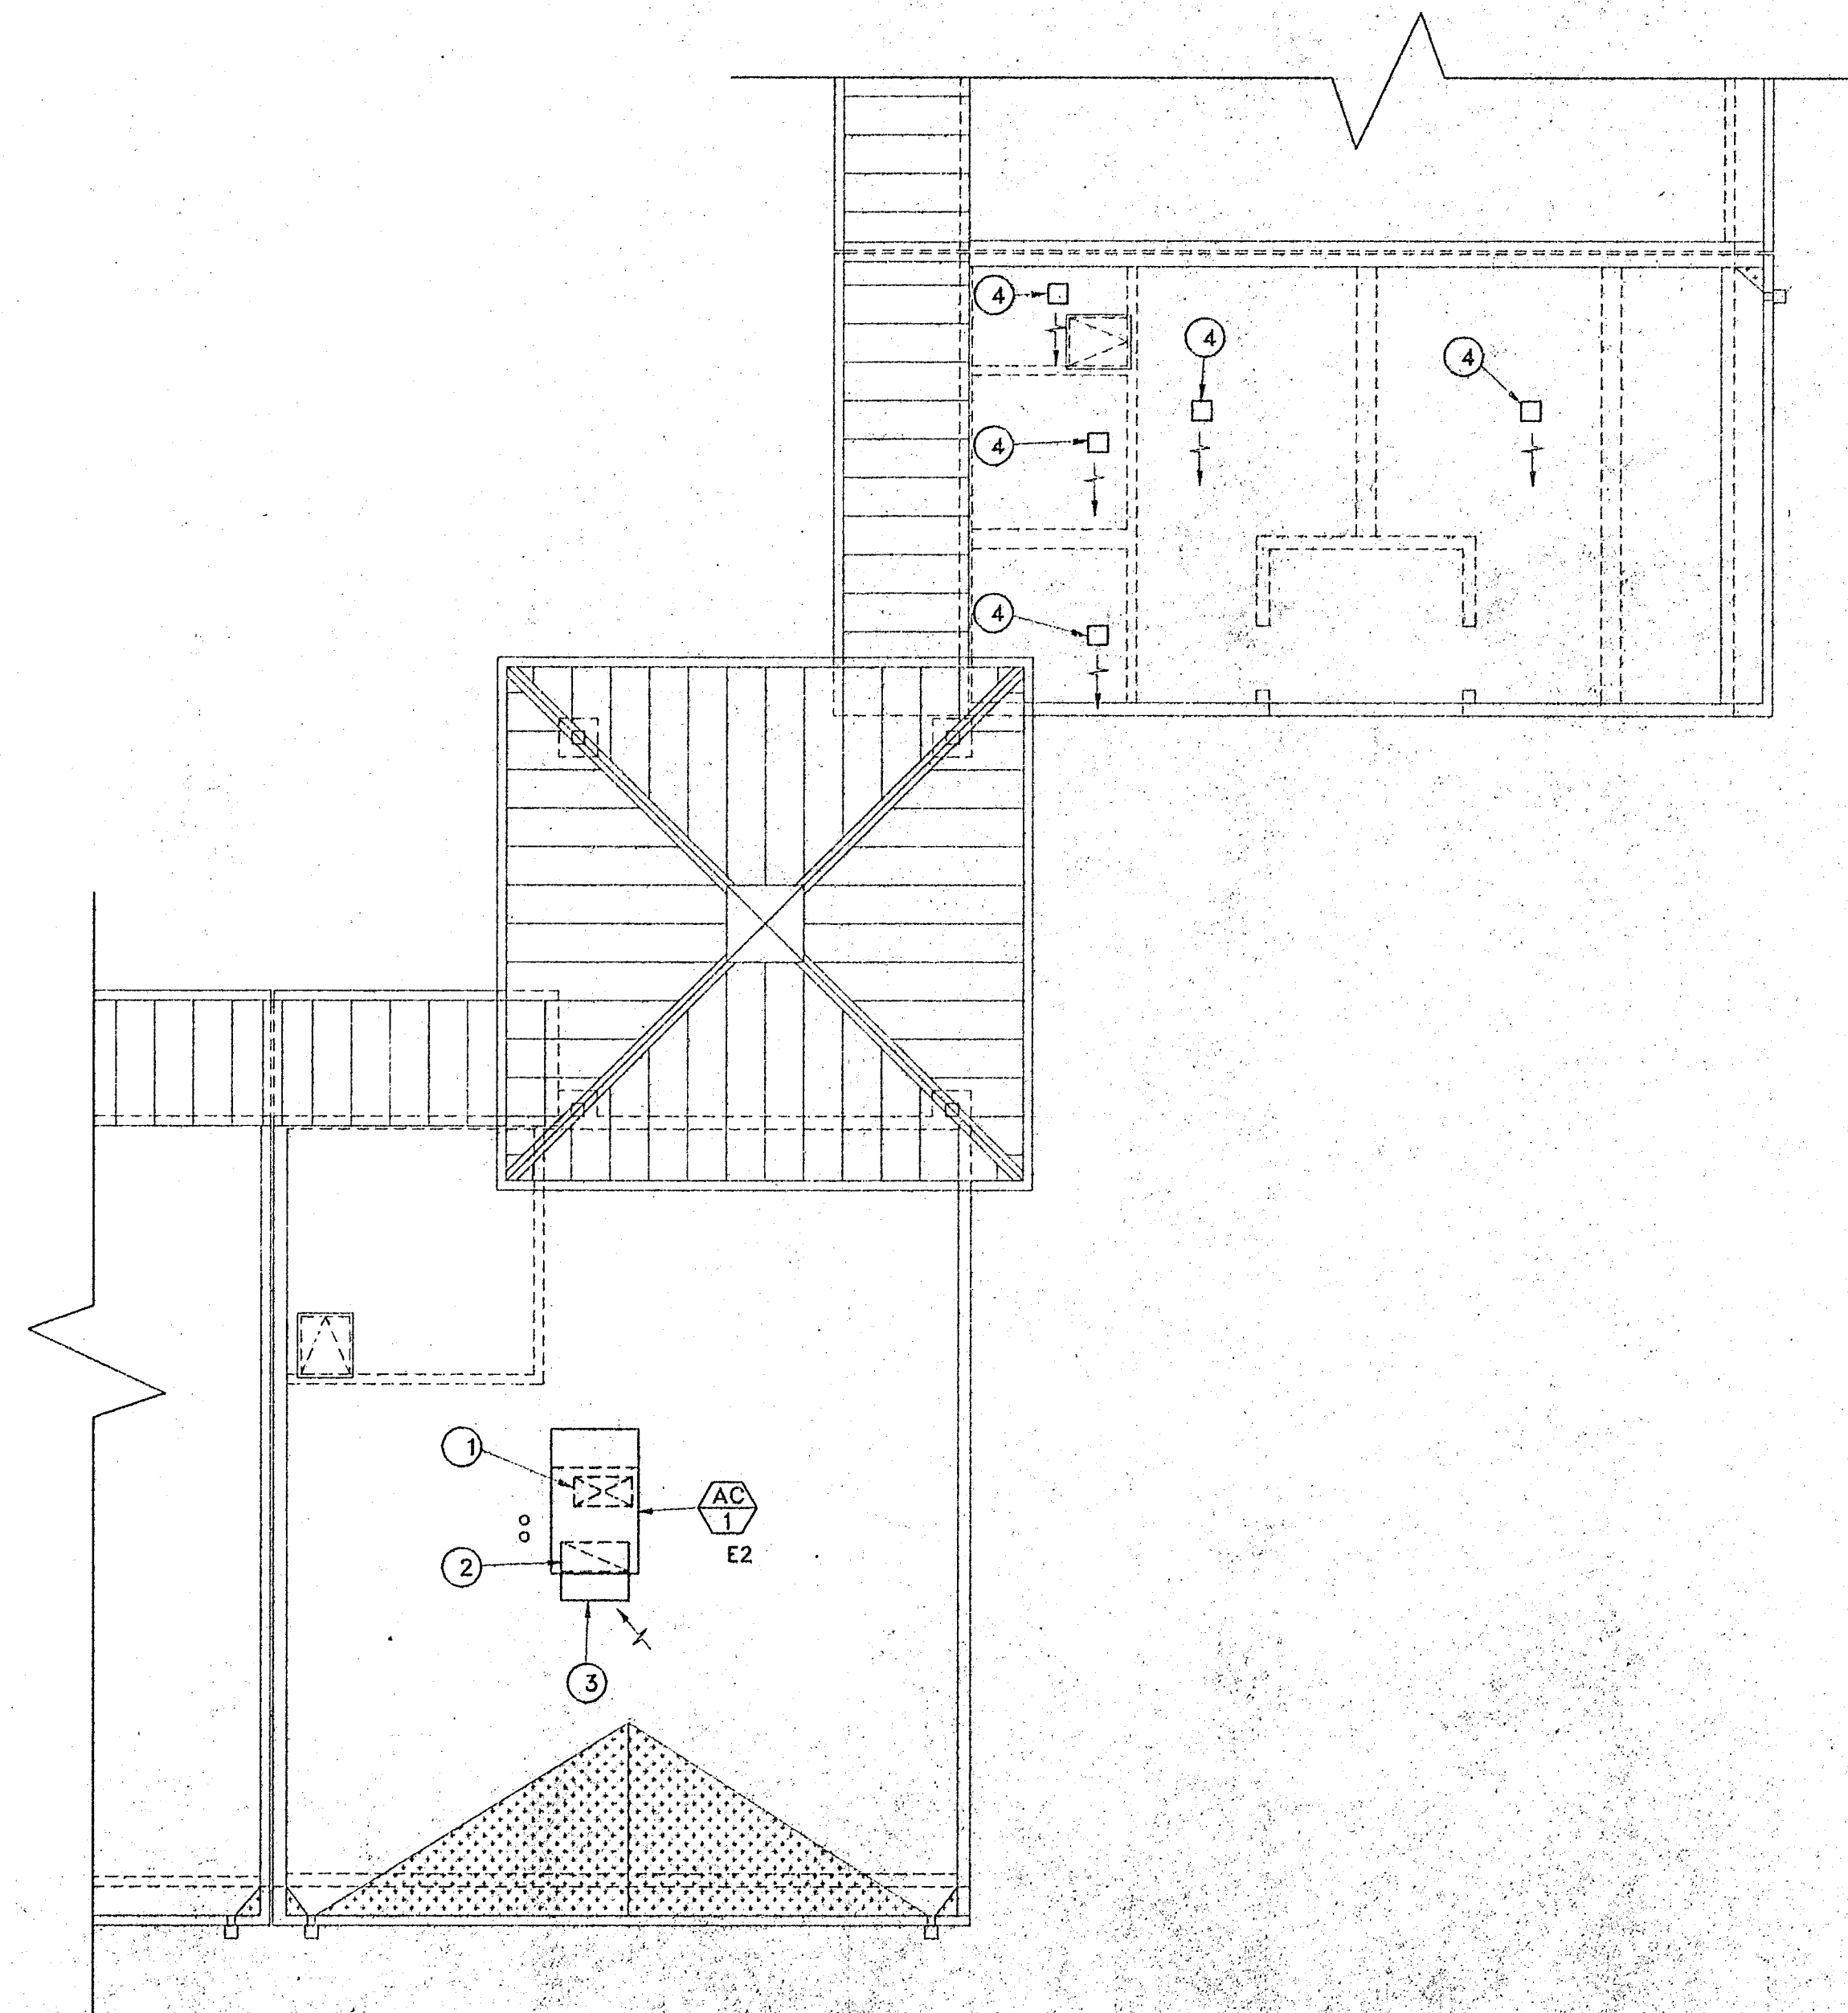


MECHANICAL ROOF PLAN

1/8"=1'-0" 2

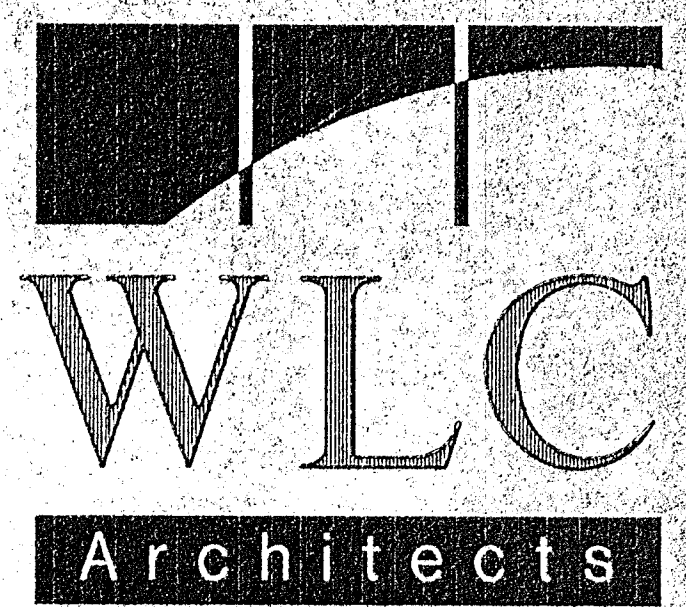

Virginia Dora Tower
10470 Foothill Blvd
Rancho Cucamonga
California 91730-3754
tel: 909 987 0909
fax: 909 980 9980



Tovoshal Elementary School
Murrieta Valley
Unified School District

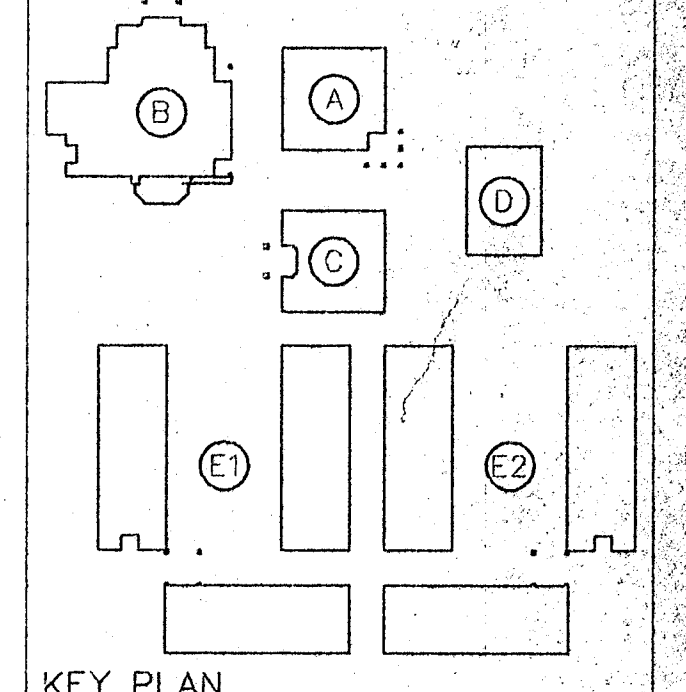

KEY PLAN

CONSULTANT

APPROVED

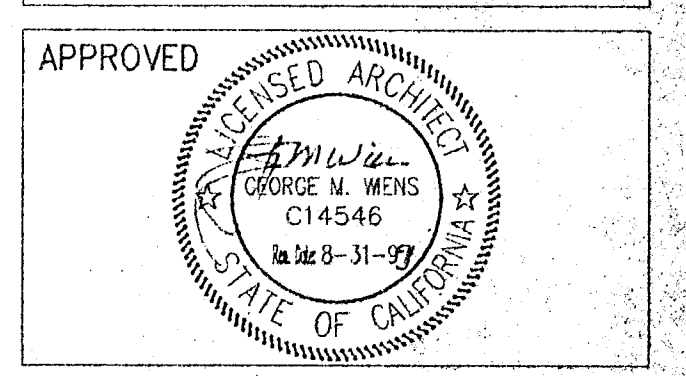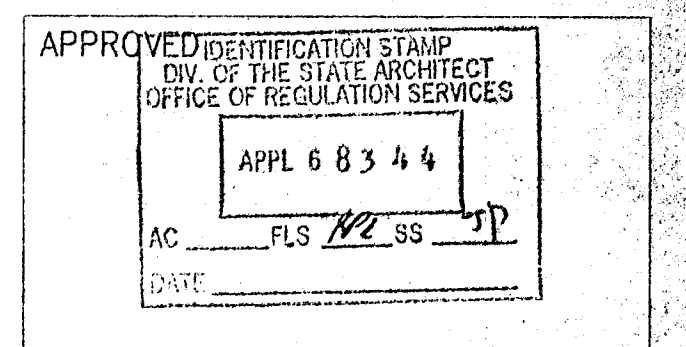

NO	DATE	BY	REMARKS


BLDG. E (AREA 2)
FLOOR AND
ROOF PLAN

DRAWN MFS
CHECKED SSM
DATE MAY 1997
SCALE 1/8"=1'-0"
JOB NO. 95113

M-E22



MATHAUDHU ENGINEERING, INC.
CONSULTING MECHANICAL ENGINEERS
3833 AIRIPA AVENUE, REVERSHOPE, CALIFORNIA, 92208-2211
(951) 506-1776 FAX: (951) 506-9501

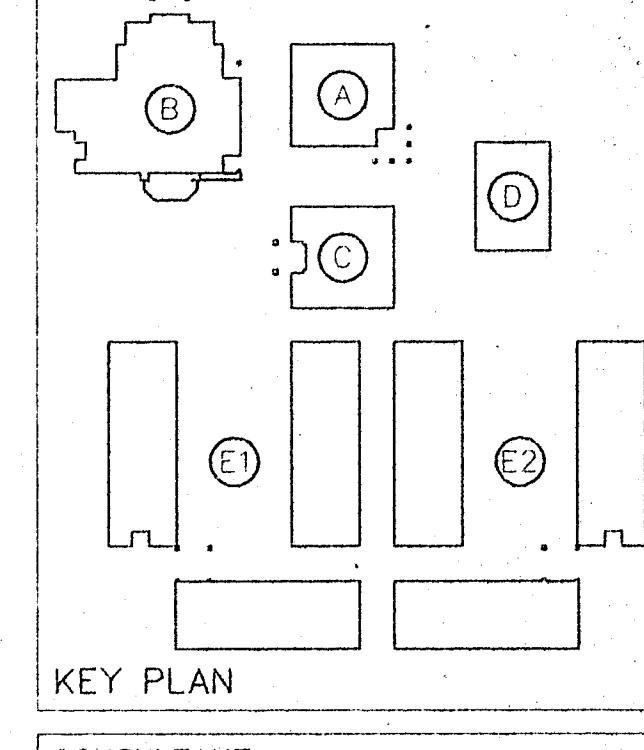

CONSULTANT

APPROVED

APPROVED

NO	DATE	BY	REMARKS


MECHANICAL DETAILS

DRAWN MFS
CHECKED RJ/SSM
DATE MAY 1997
SCALE 1/8"=1'-0"
JOB NO. 95113


M-31

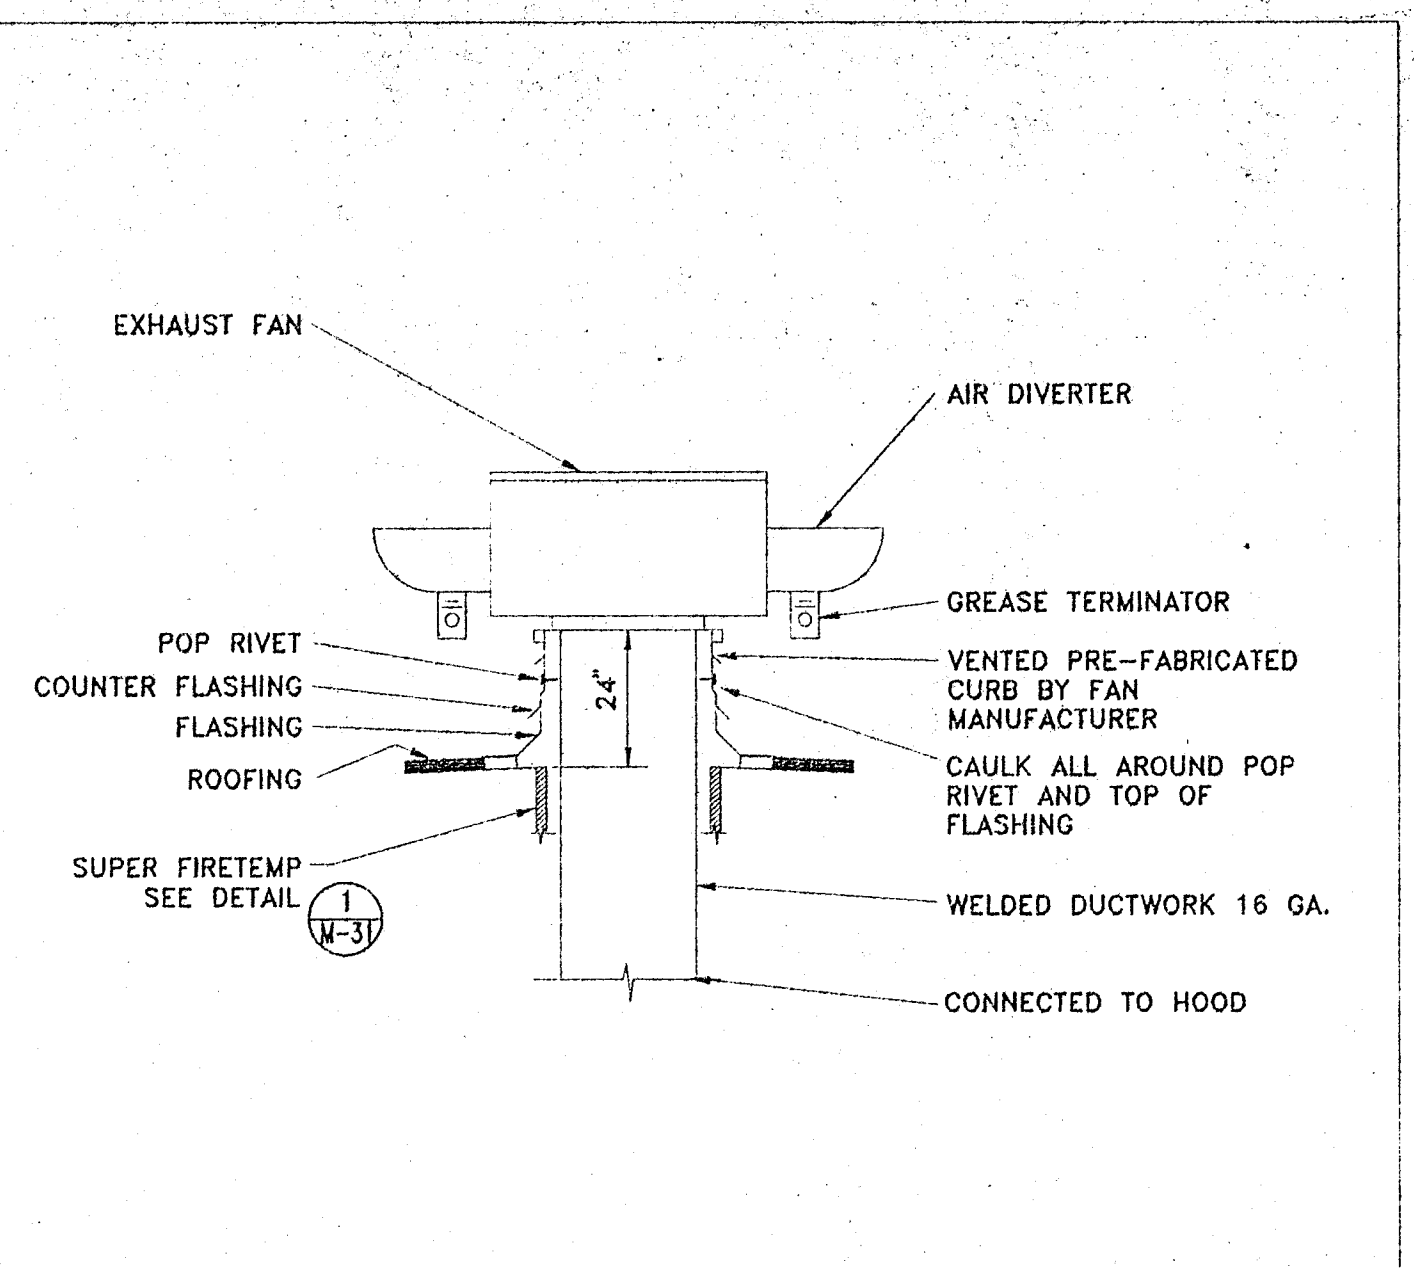


EXHAUST FAN DETAIL (EF-8B) SCALE NONE 3

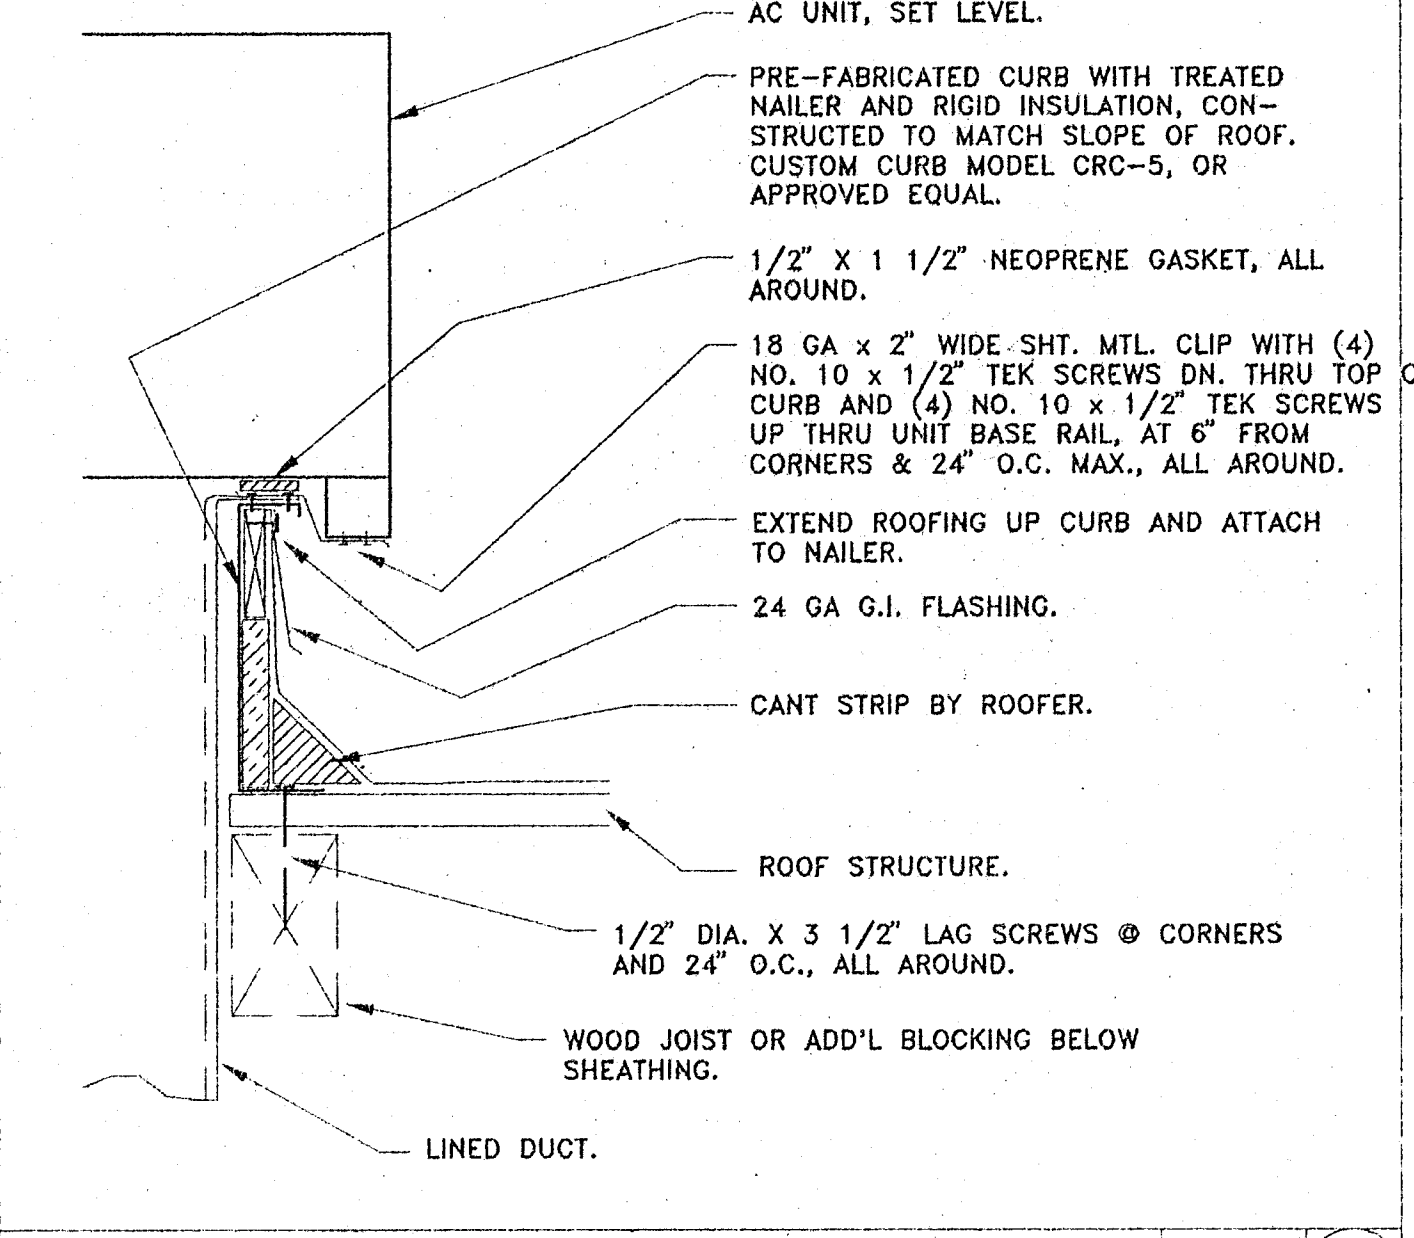


ROOF CURB DETAIL SCALE NONE 2

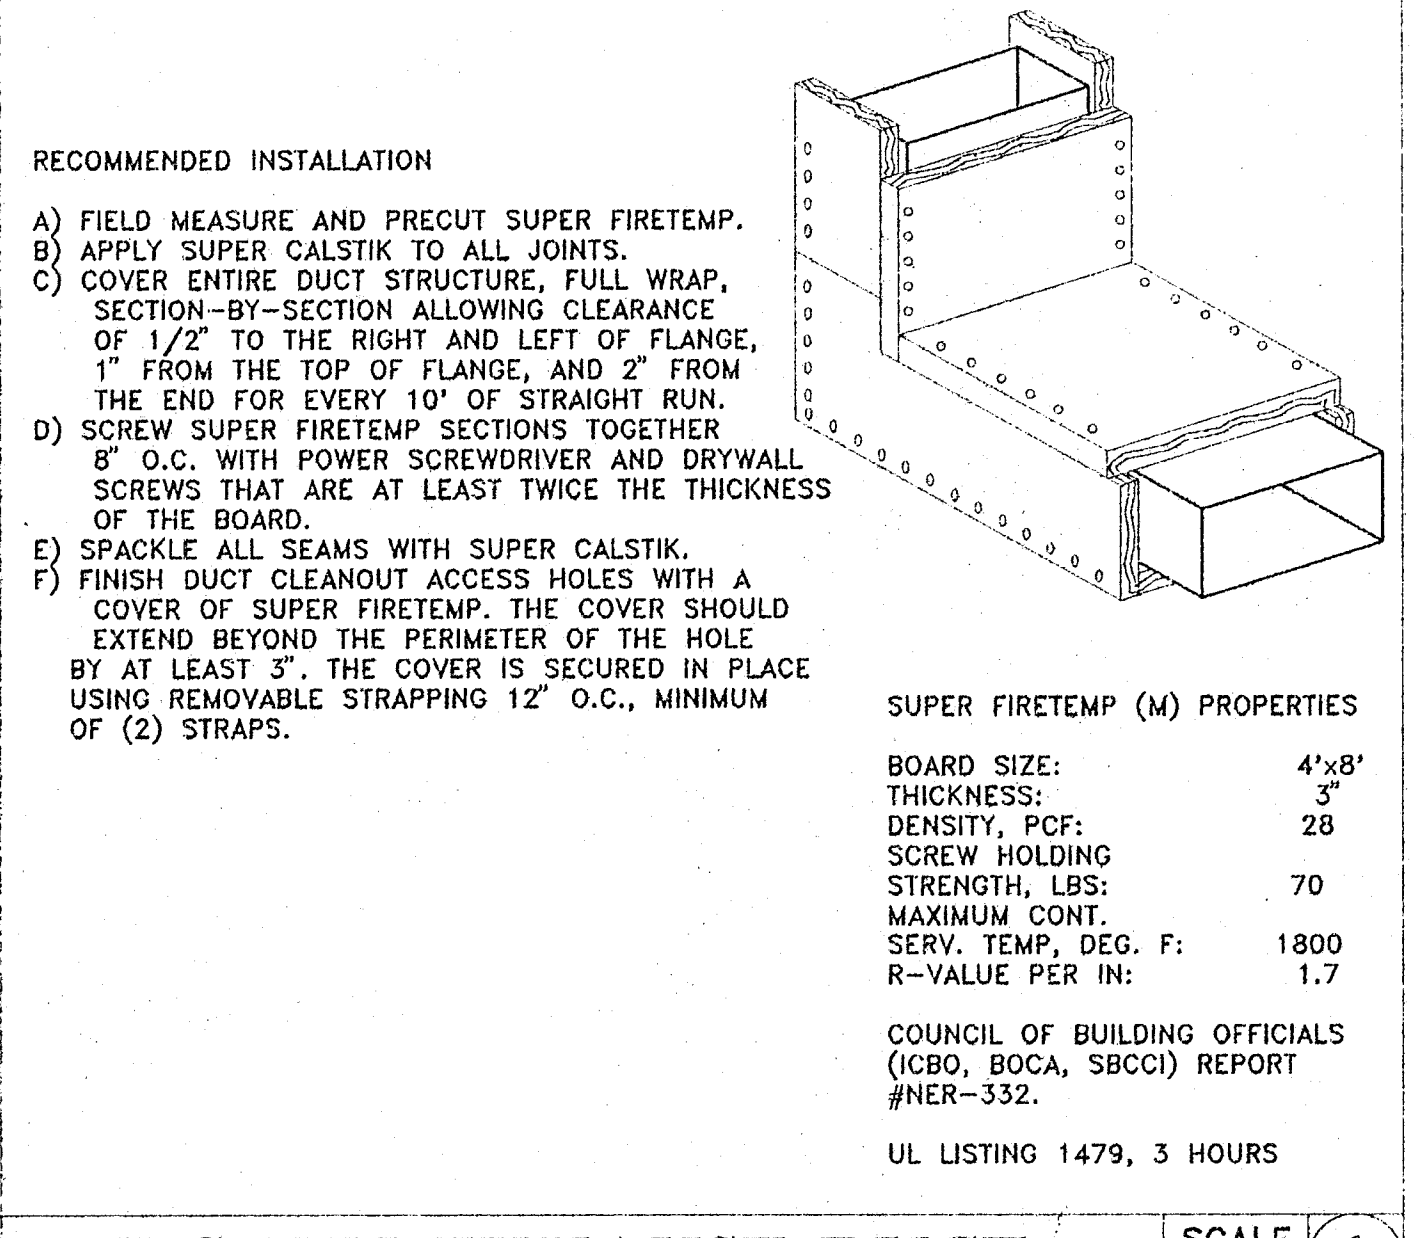


KITCHEN EXHAUST DUCT SCALE NONE 1

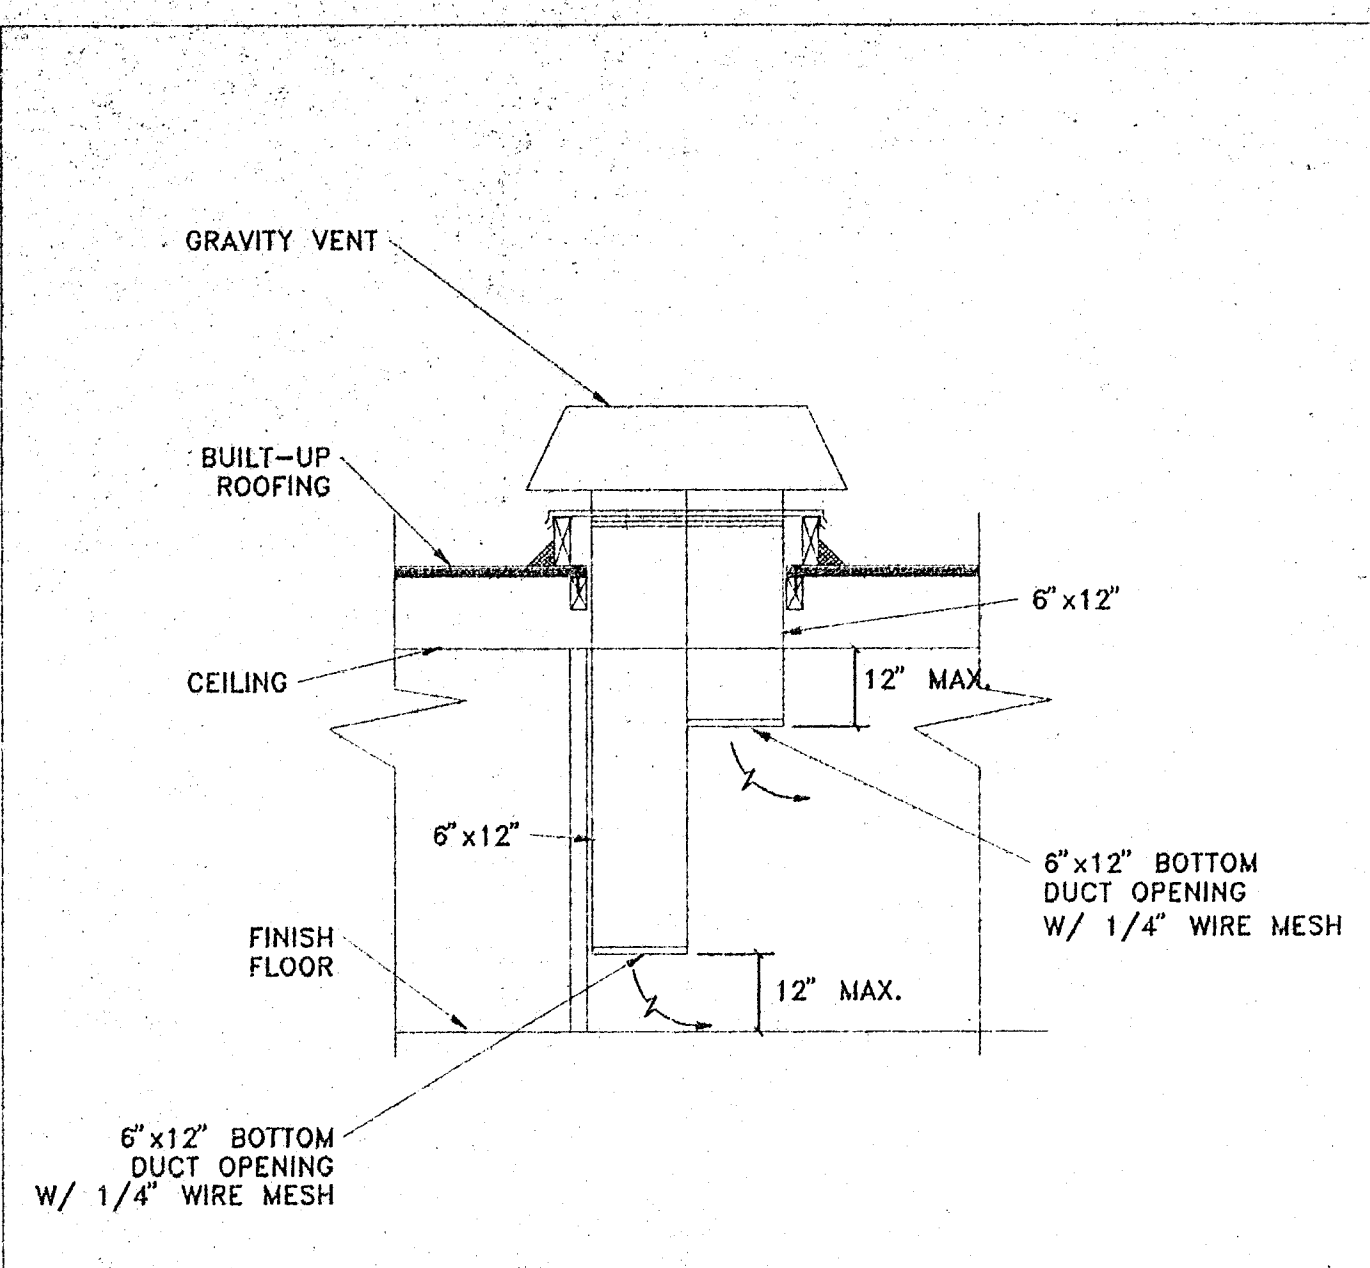


COMBUSTION AIR DUCT SCALE NONE 7

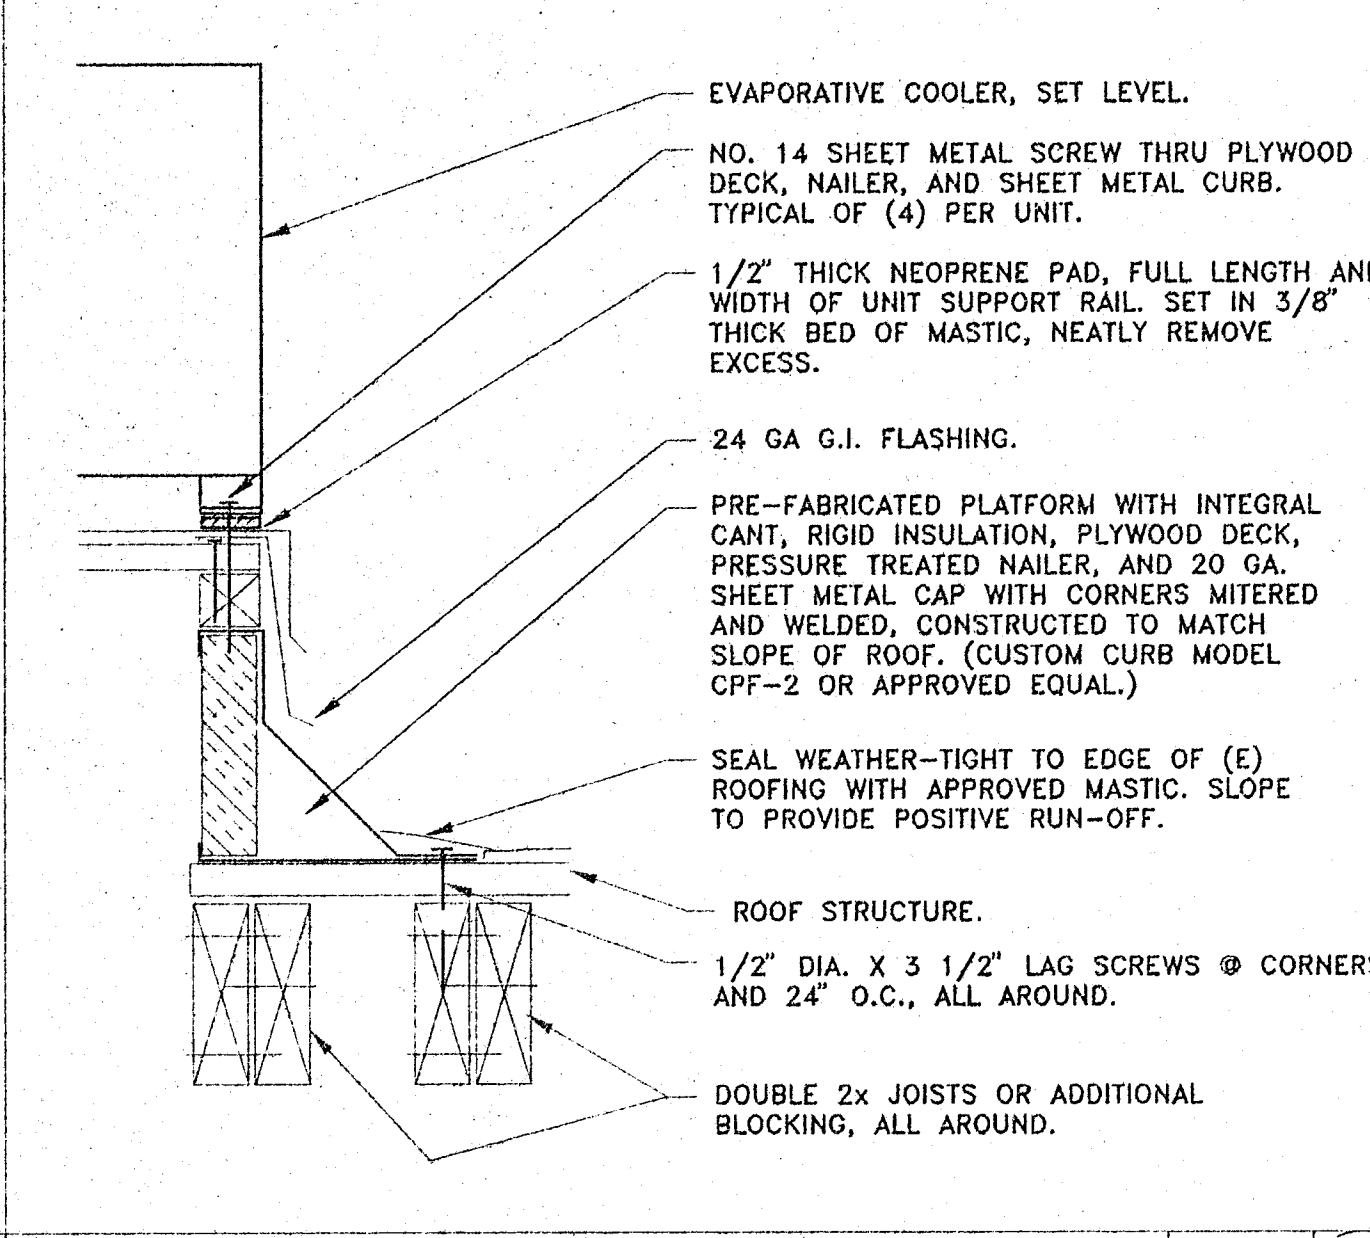


PLATFORM DETAIL (MU-1B) SCALE NONE 6

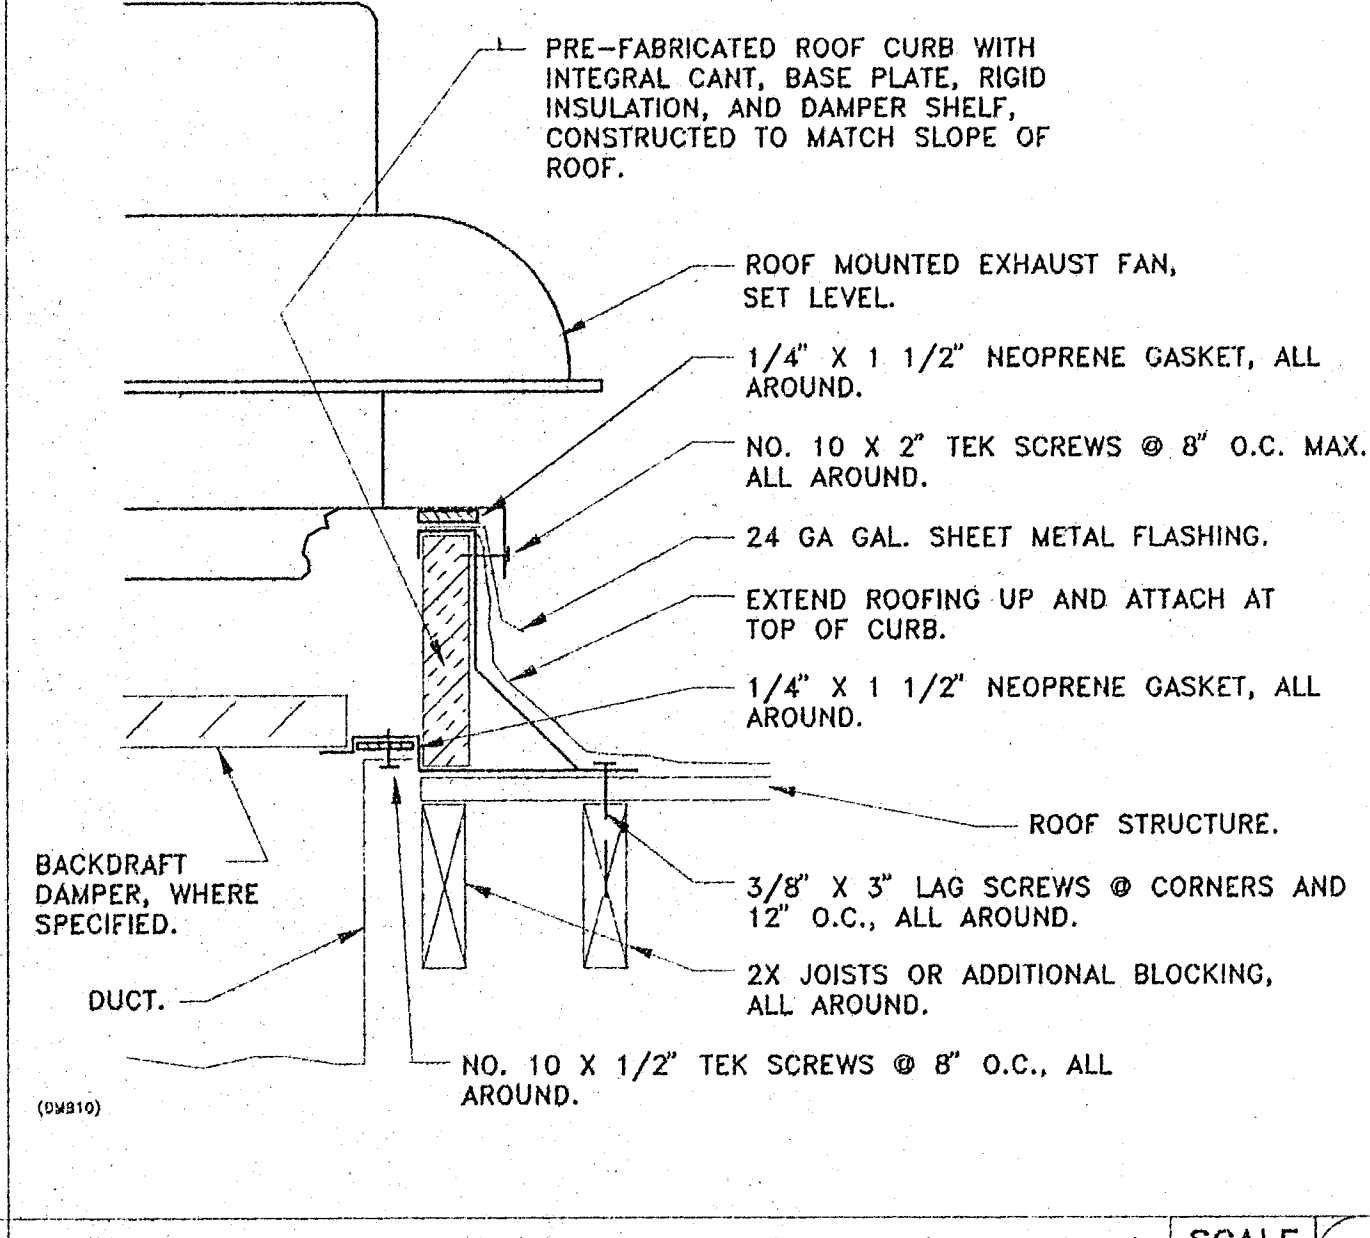


EXHAUST FAN DETAIL (EF-9B) SCALE NONE 5

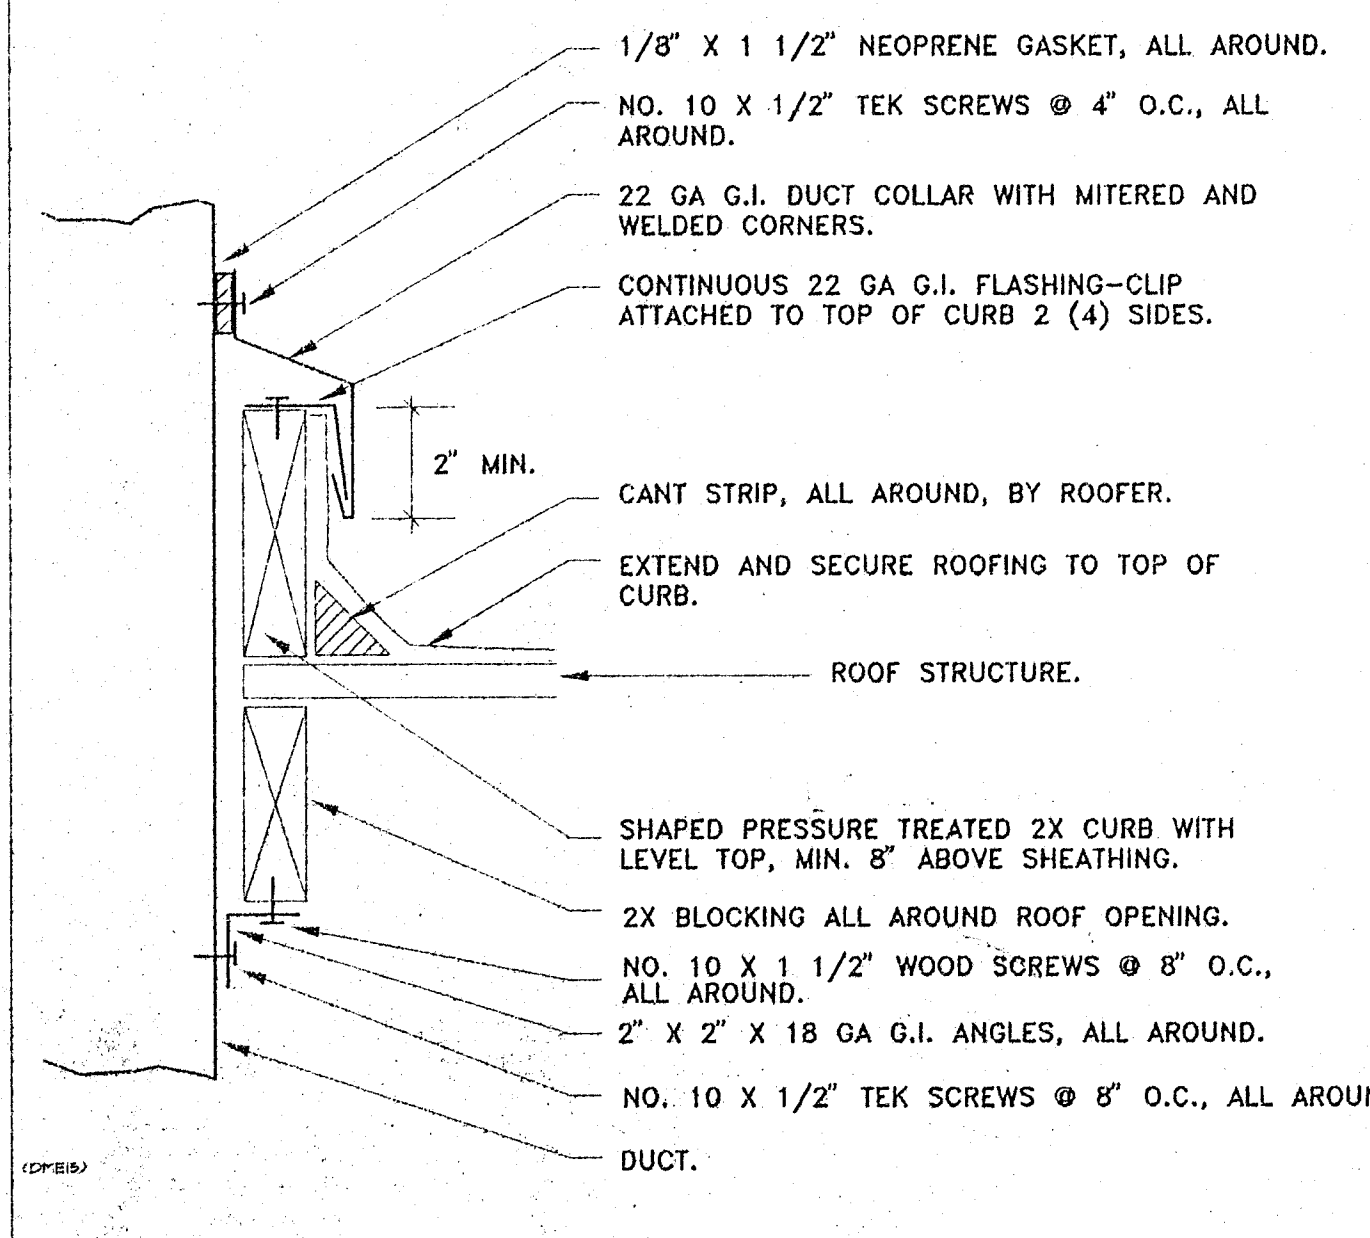


DUCT THRU ROOF DETAIL SCALE NONE 4

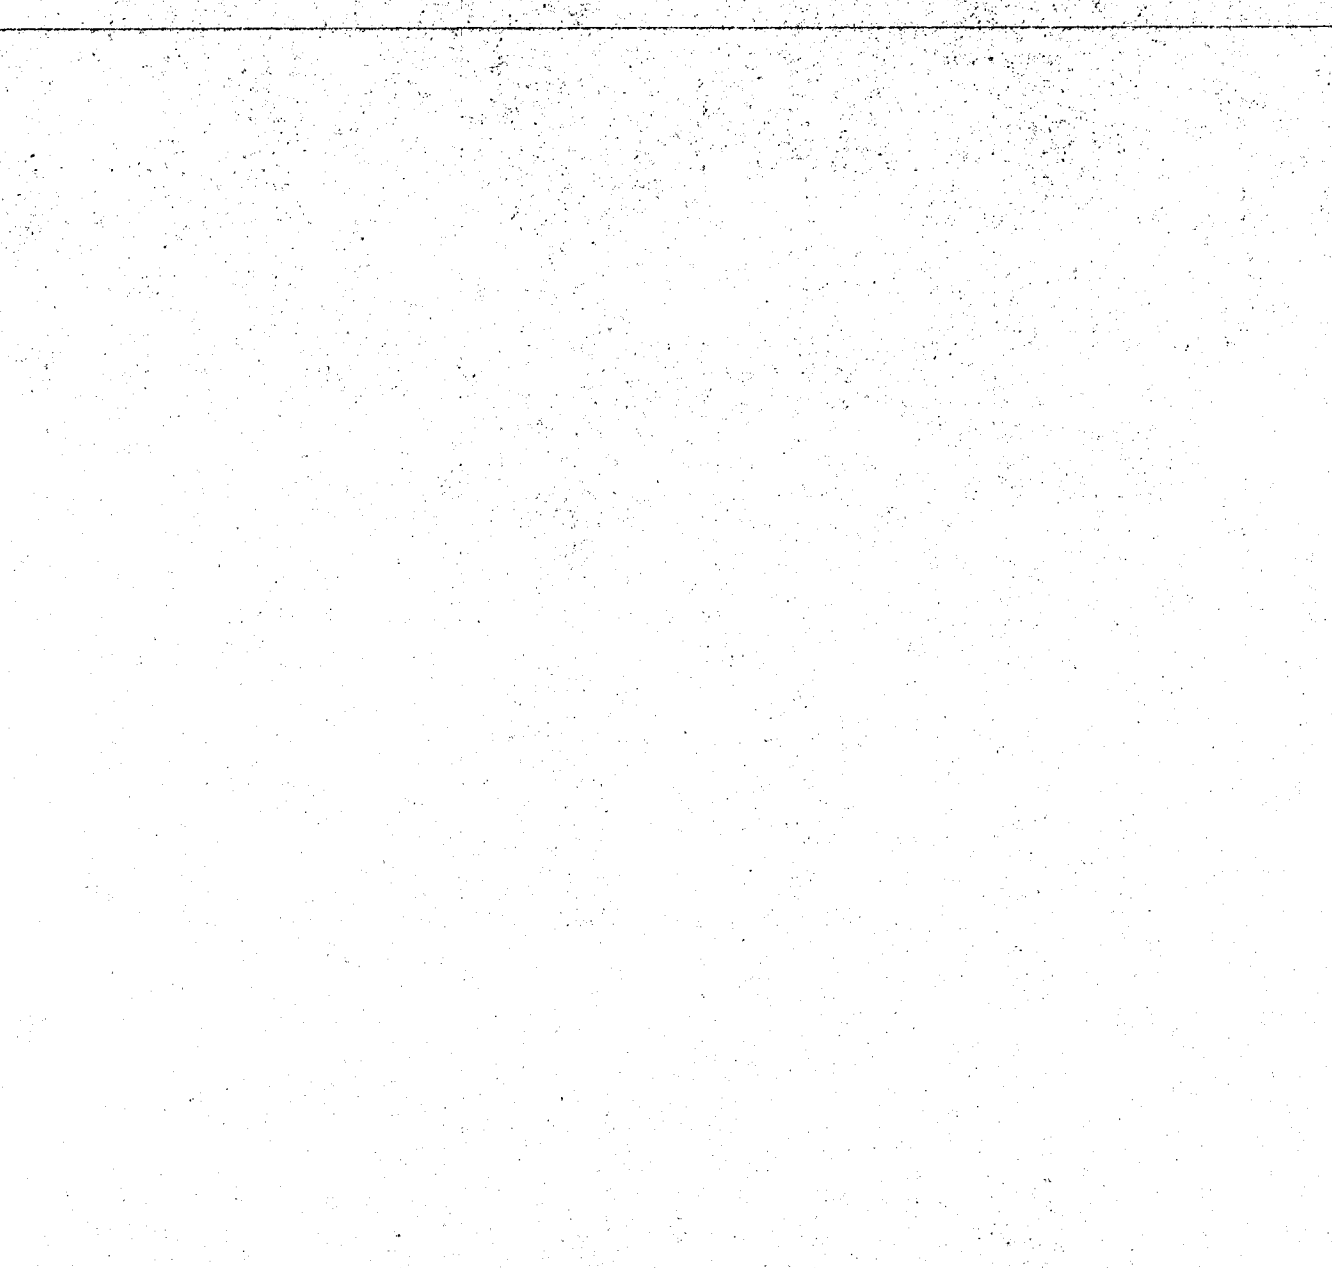


FIRE DAMPER ORATED WALL SCALE NONE 9

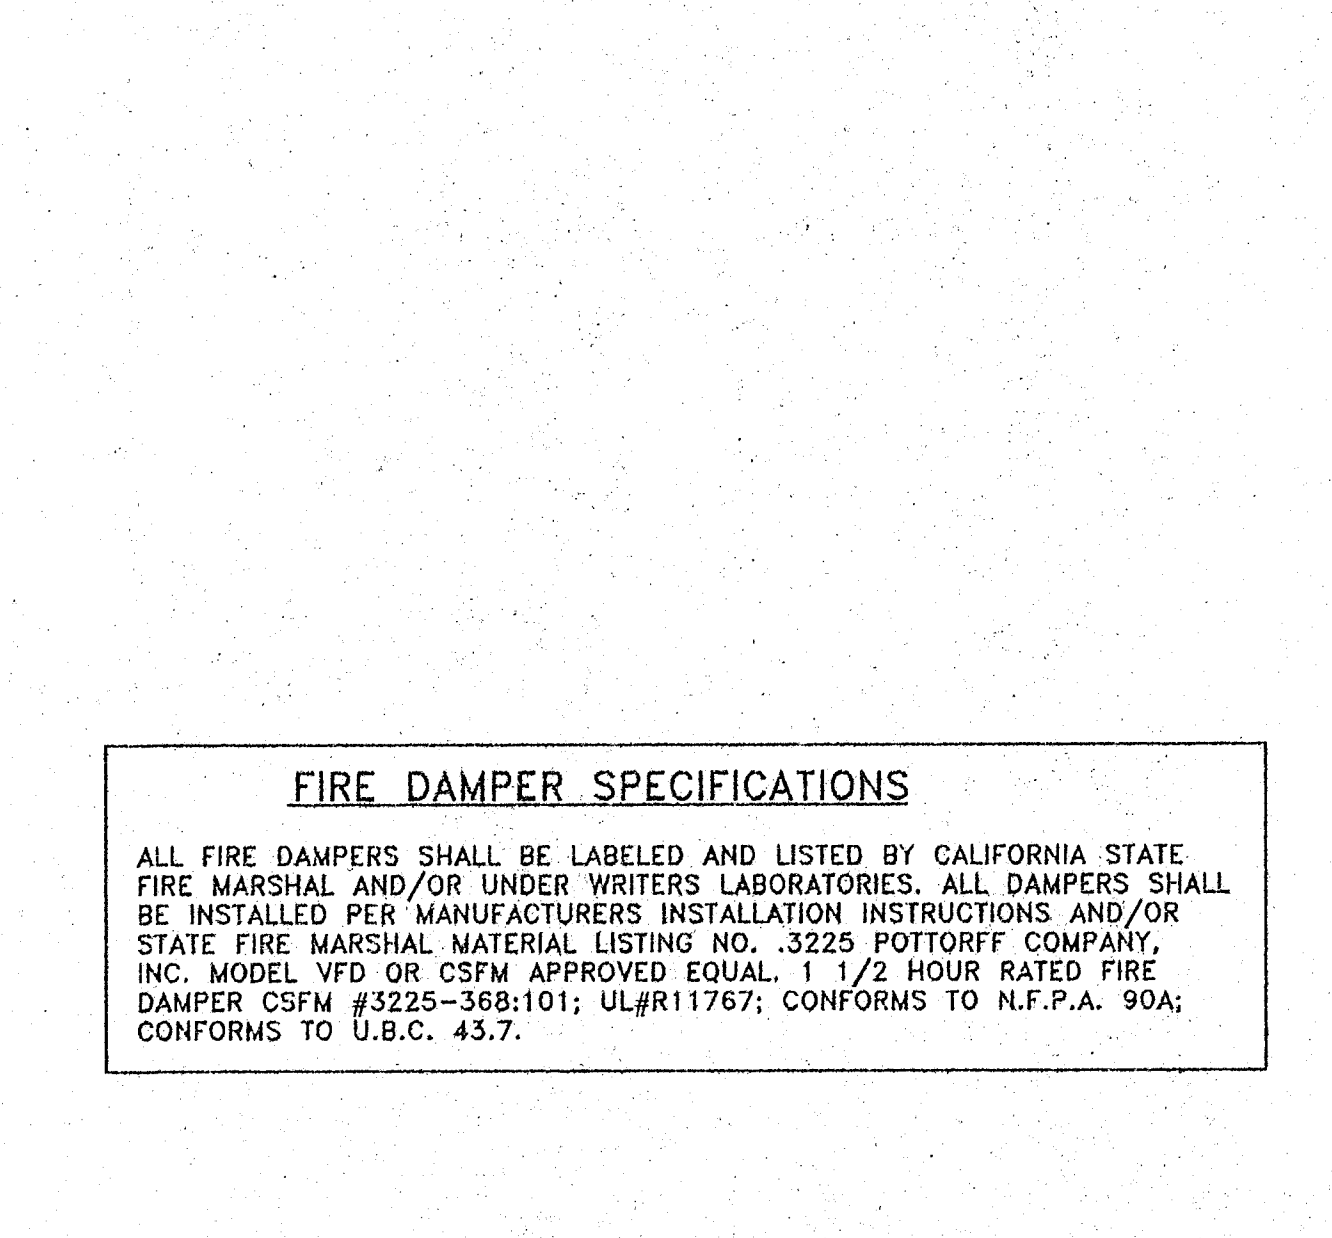


DUCT SUPPORT SCALE NONE 8

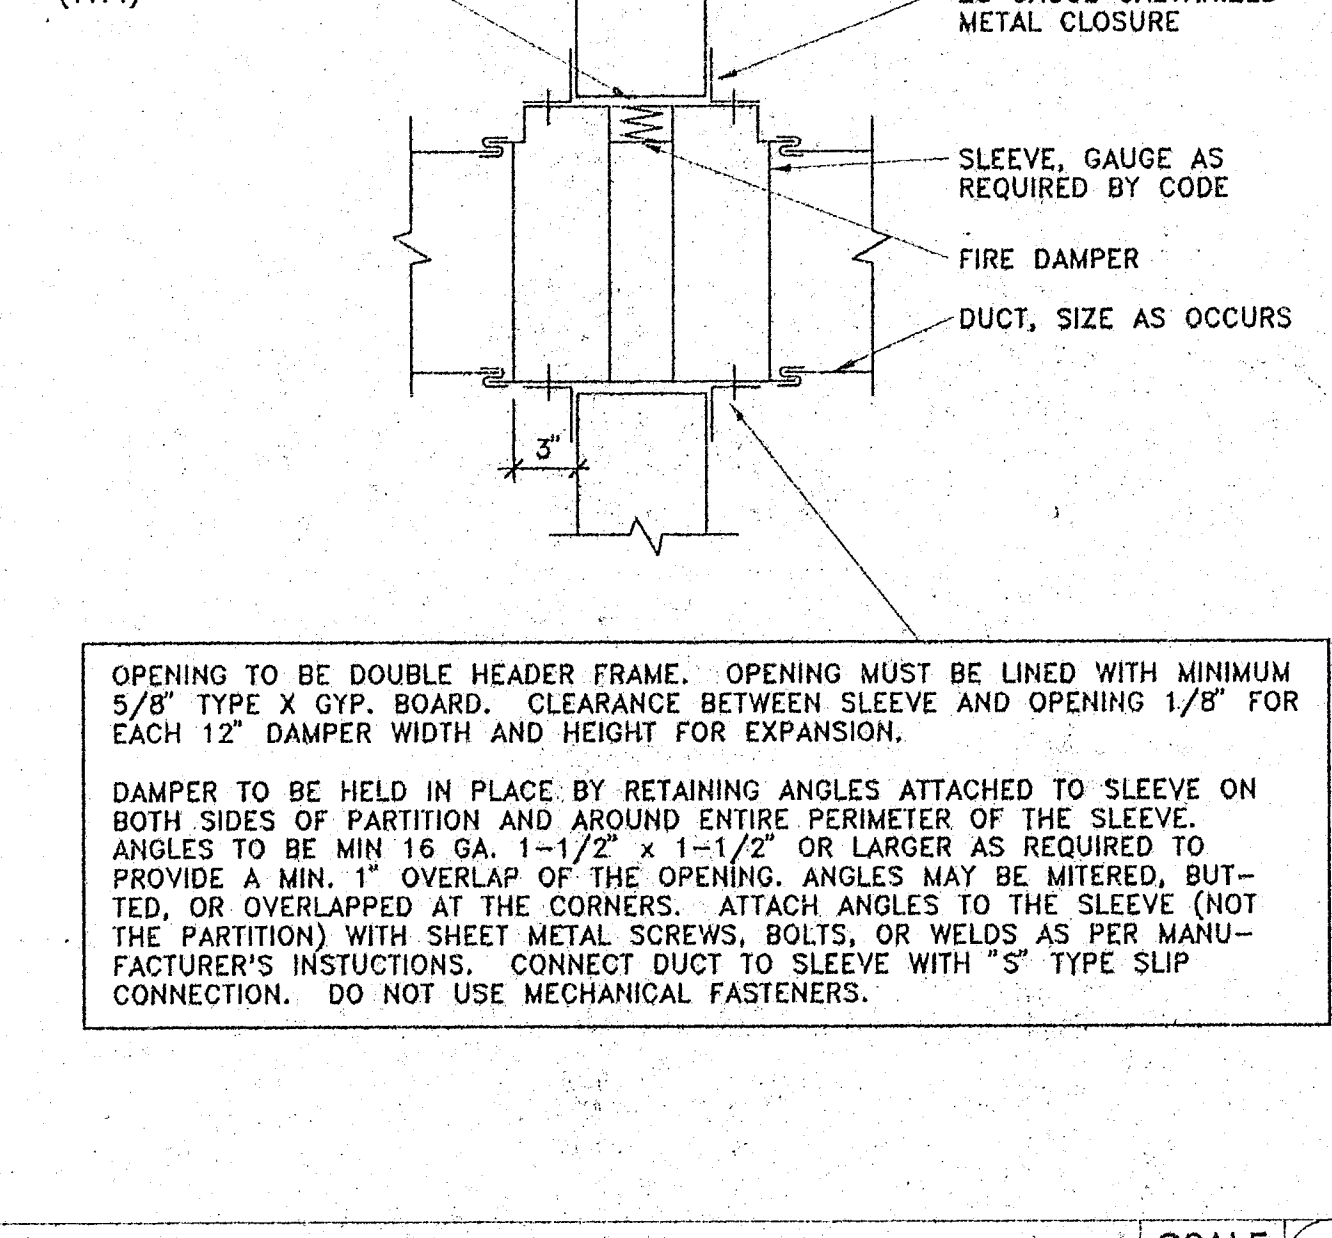


DUCT THRU ROOF DETAIL SCALE NONE 4

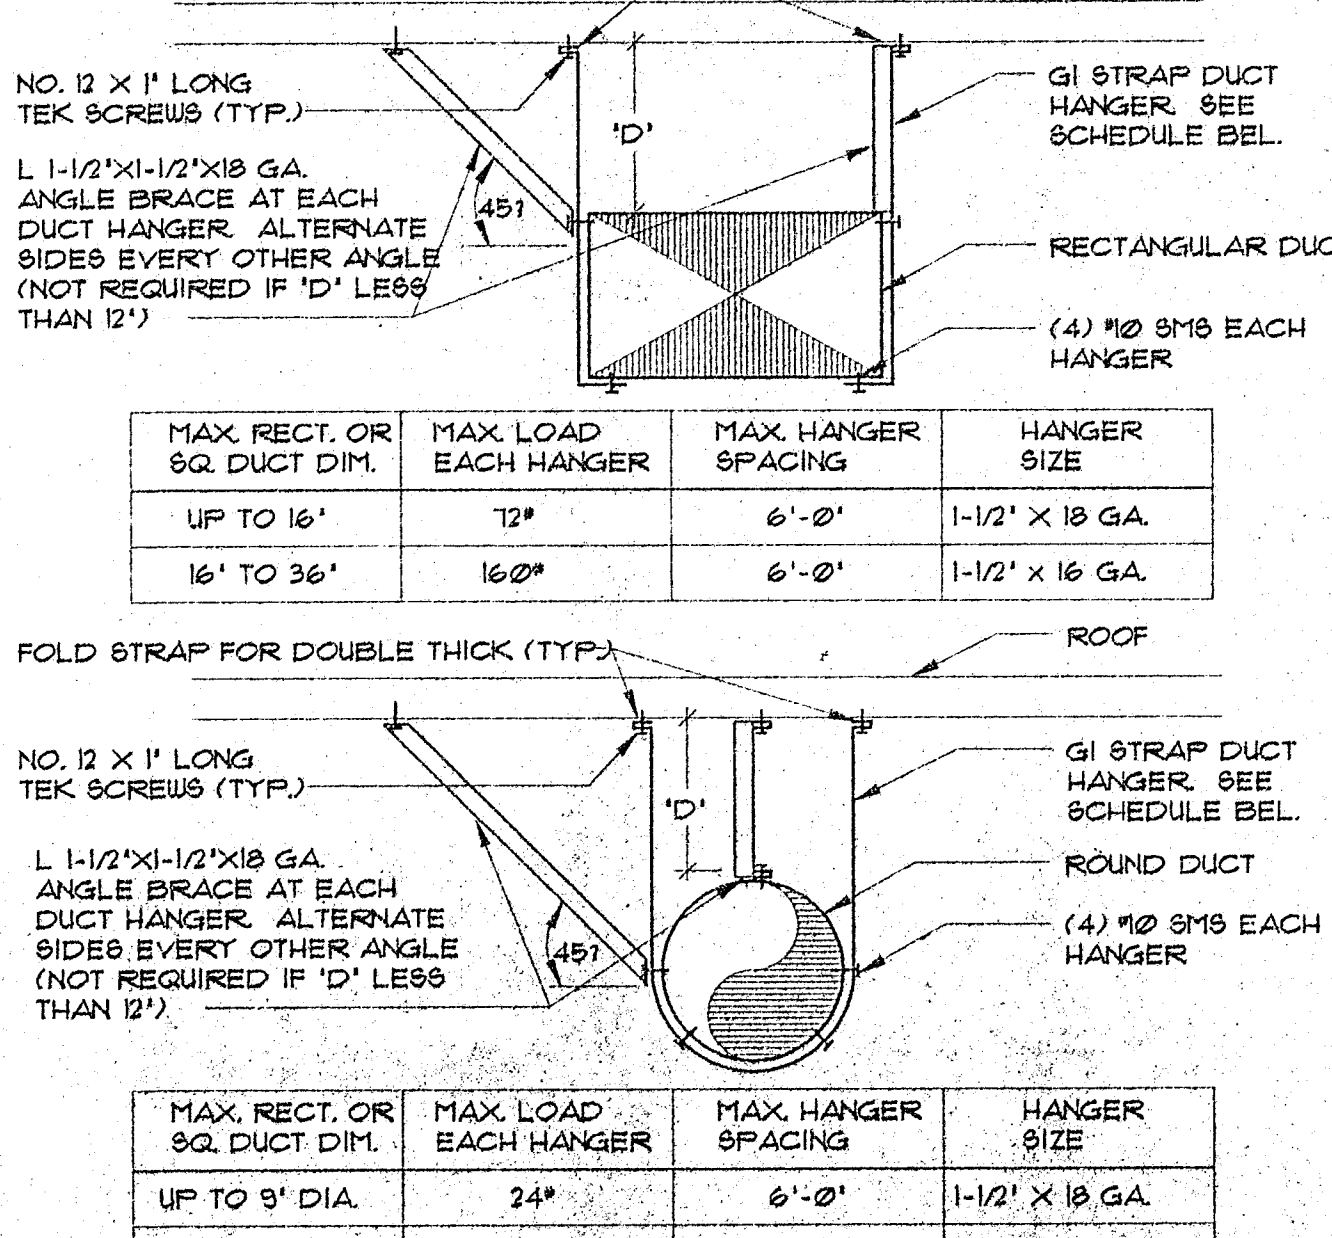


DUCT THRU ROOF DETAIL SCALE NONE 4

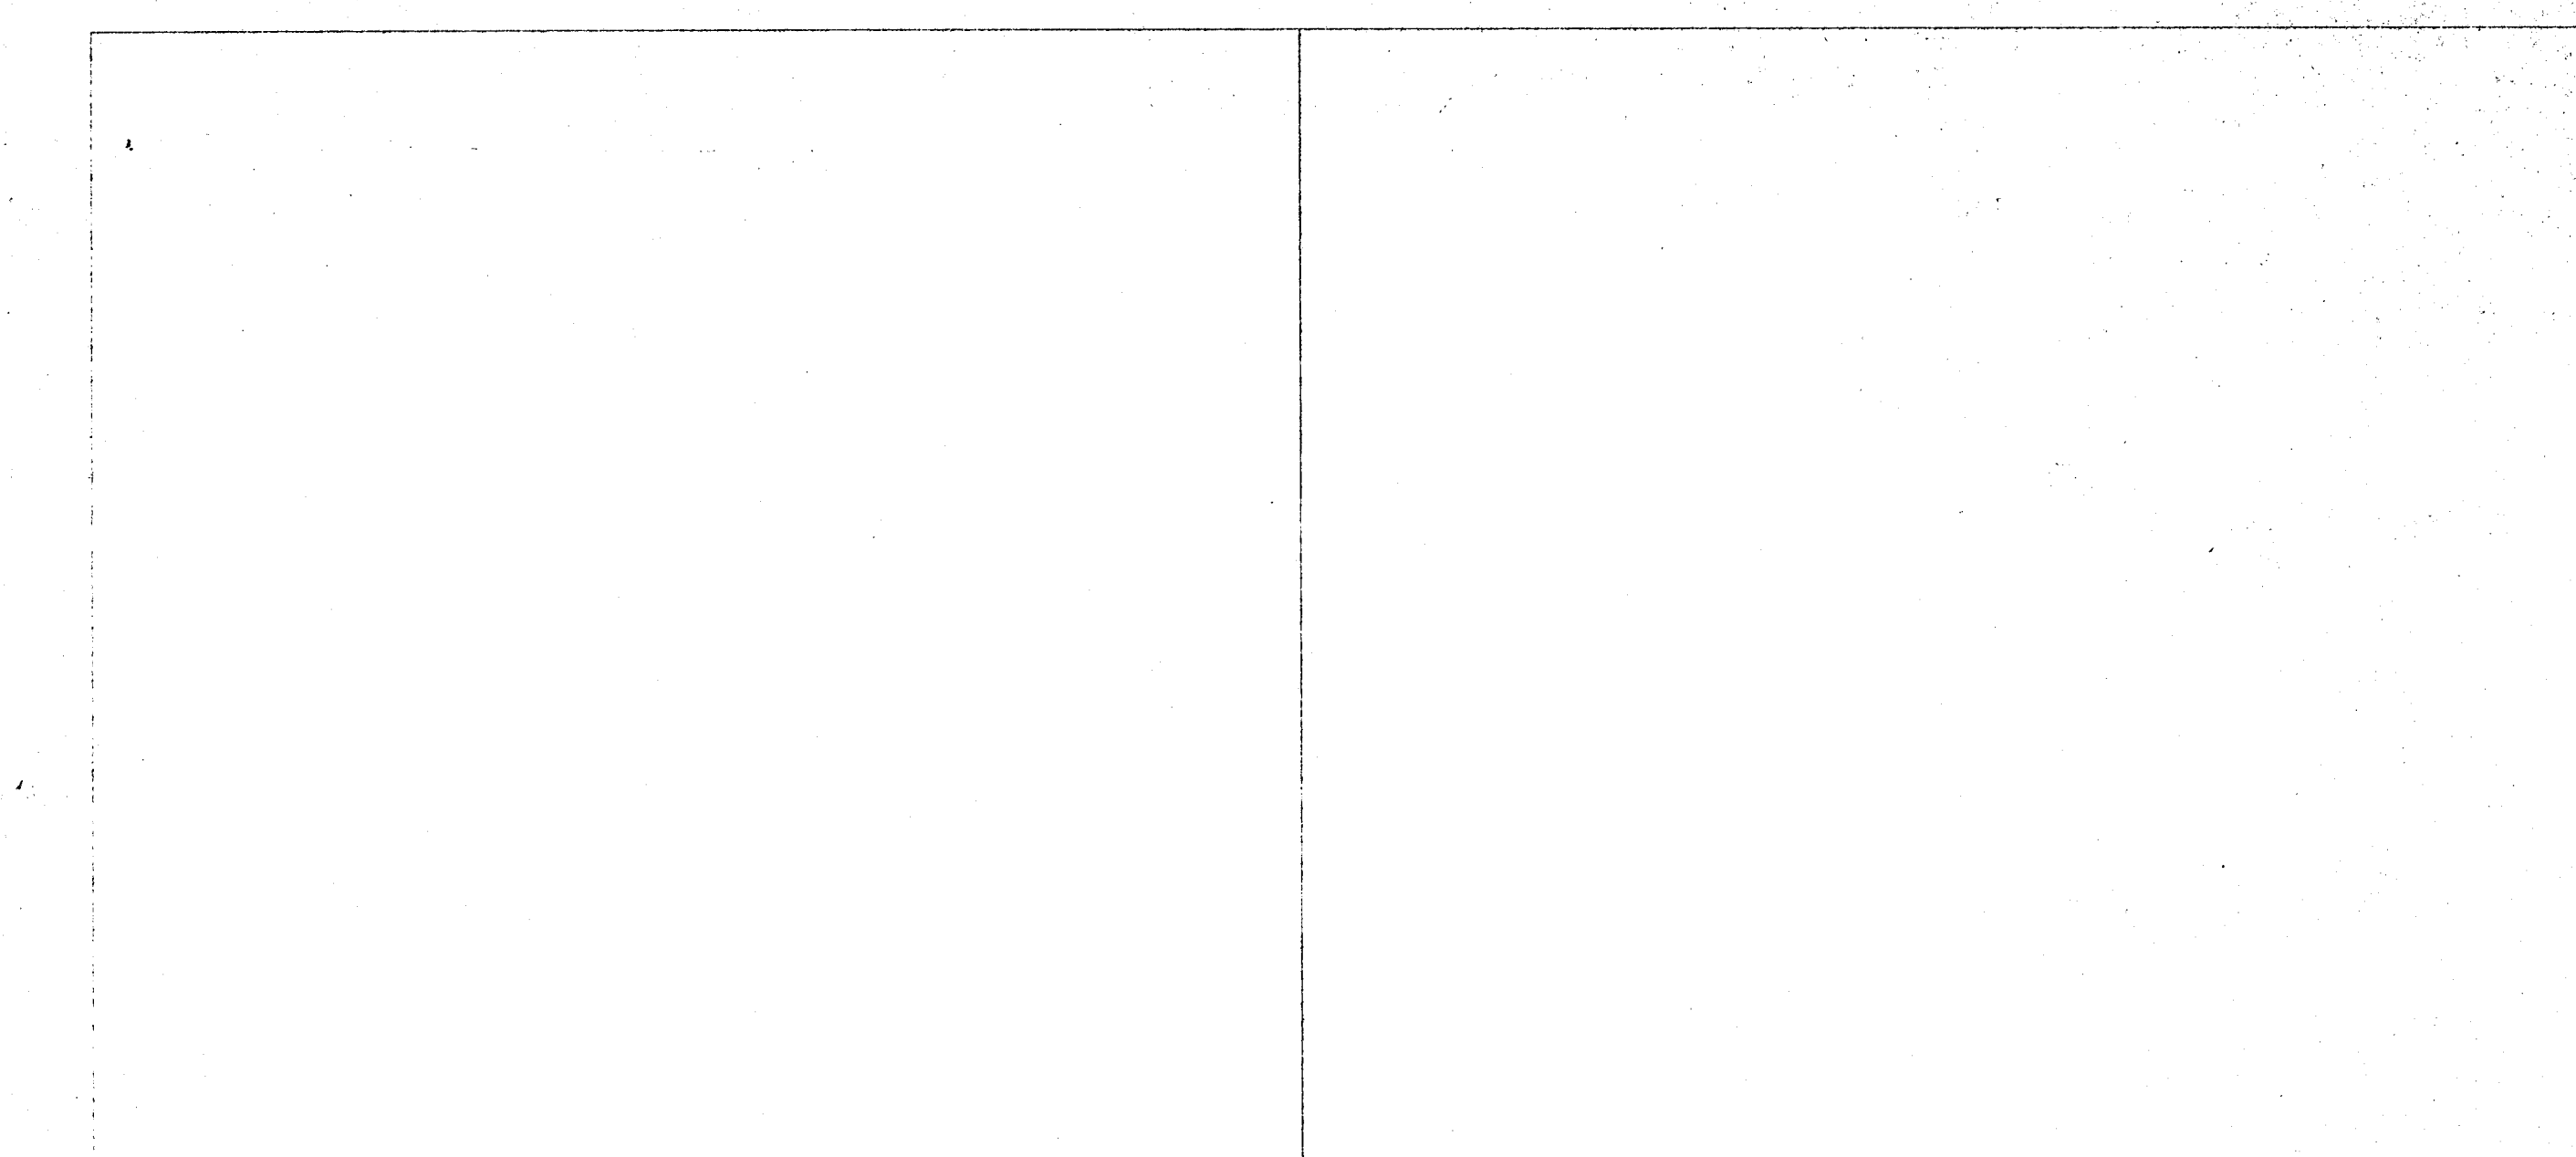


NOT USED SCALE NONE

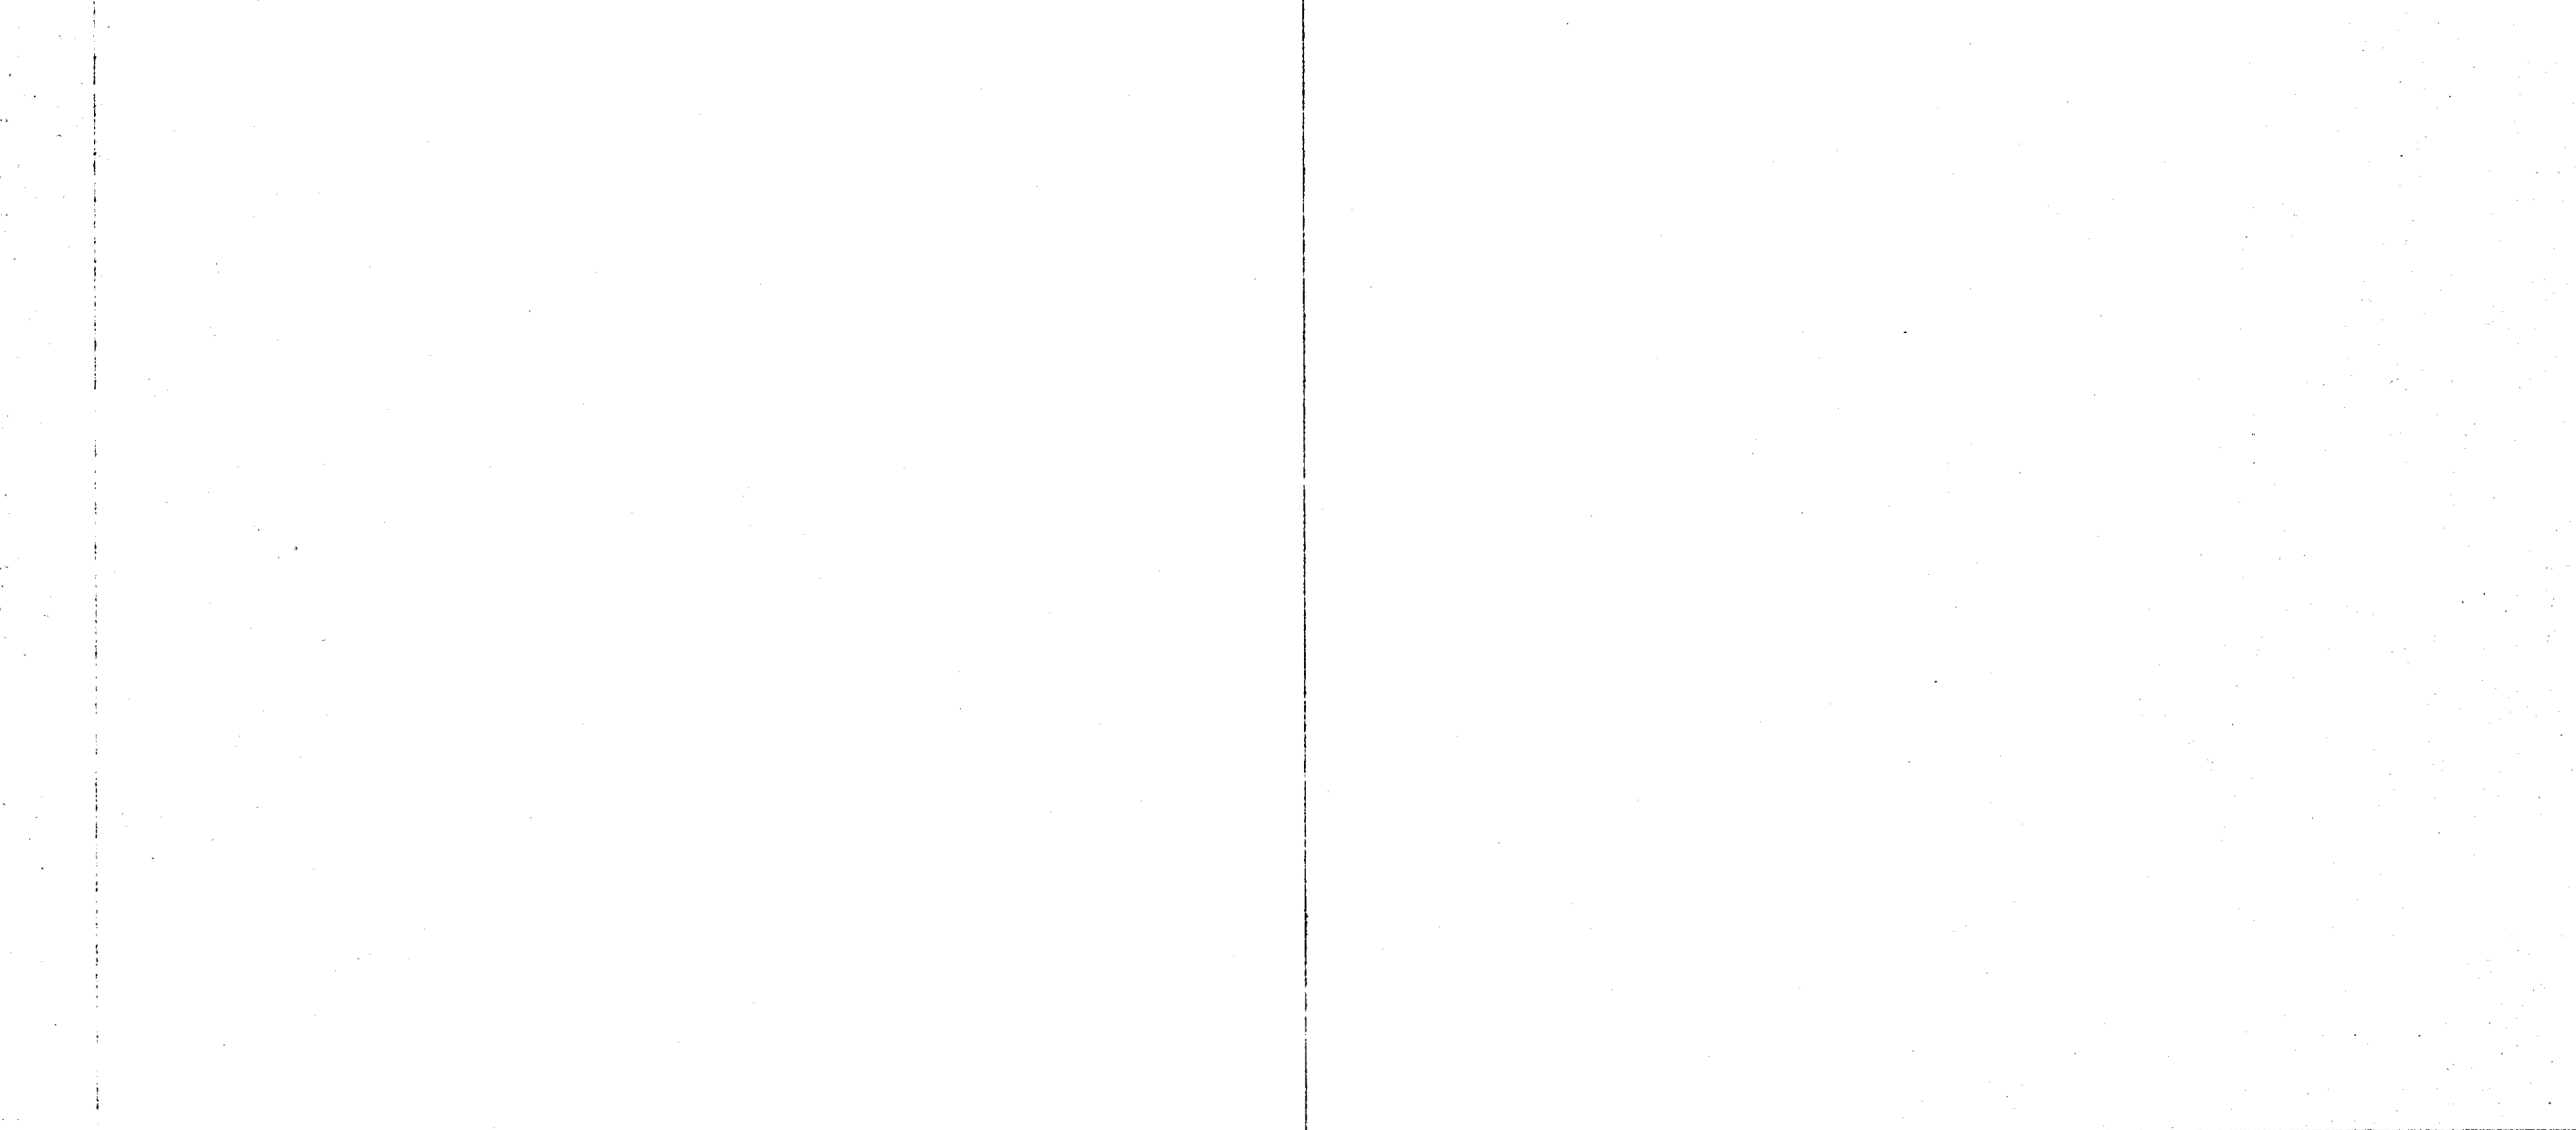

NOT USED SCALE NONE

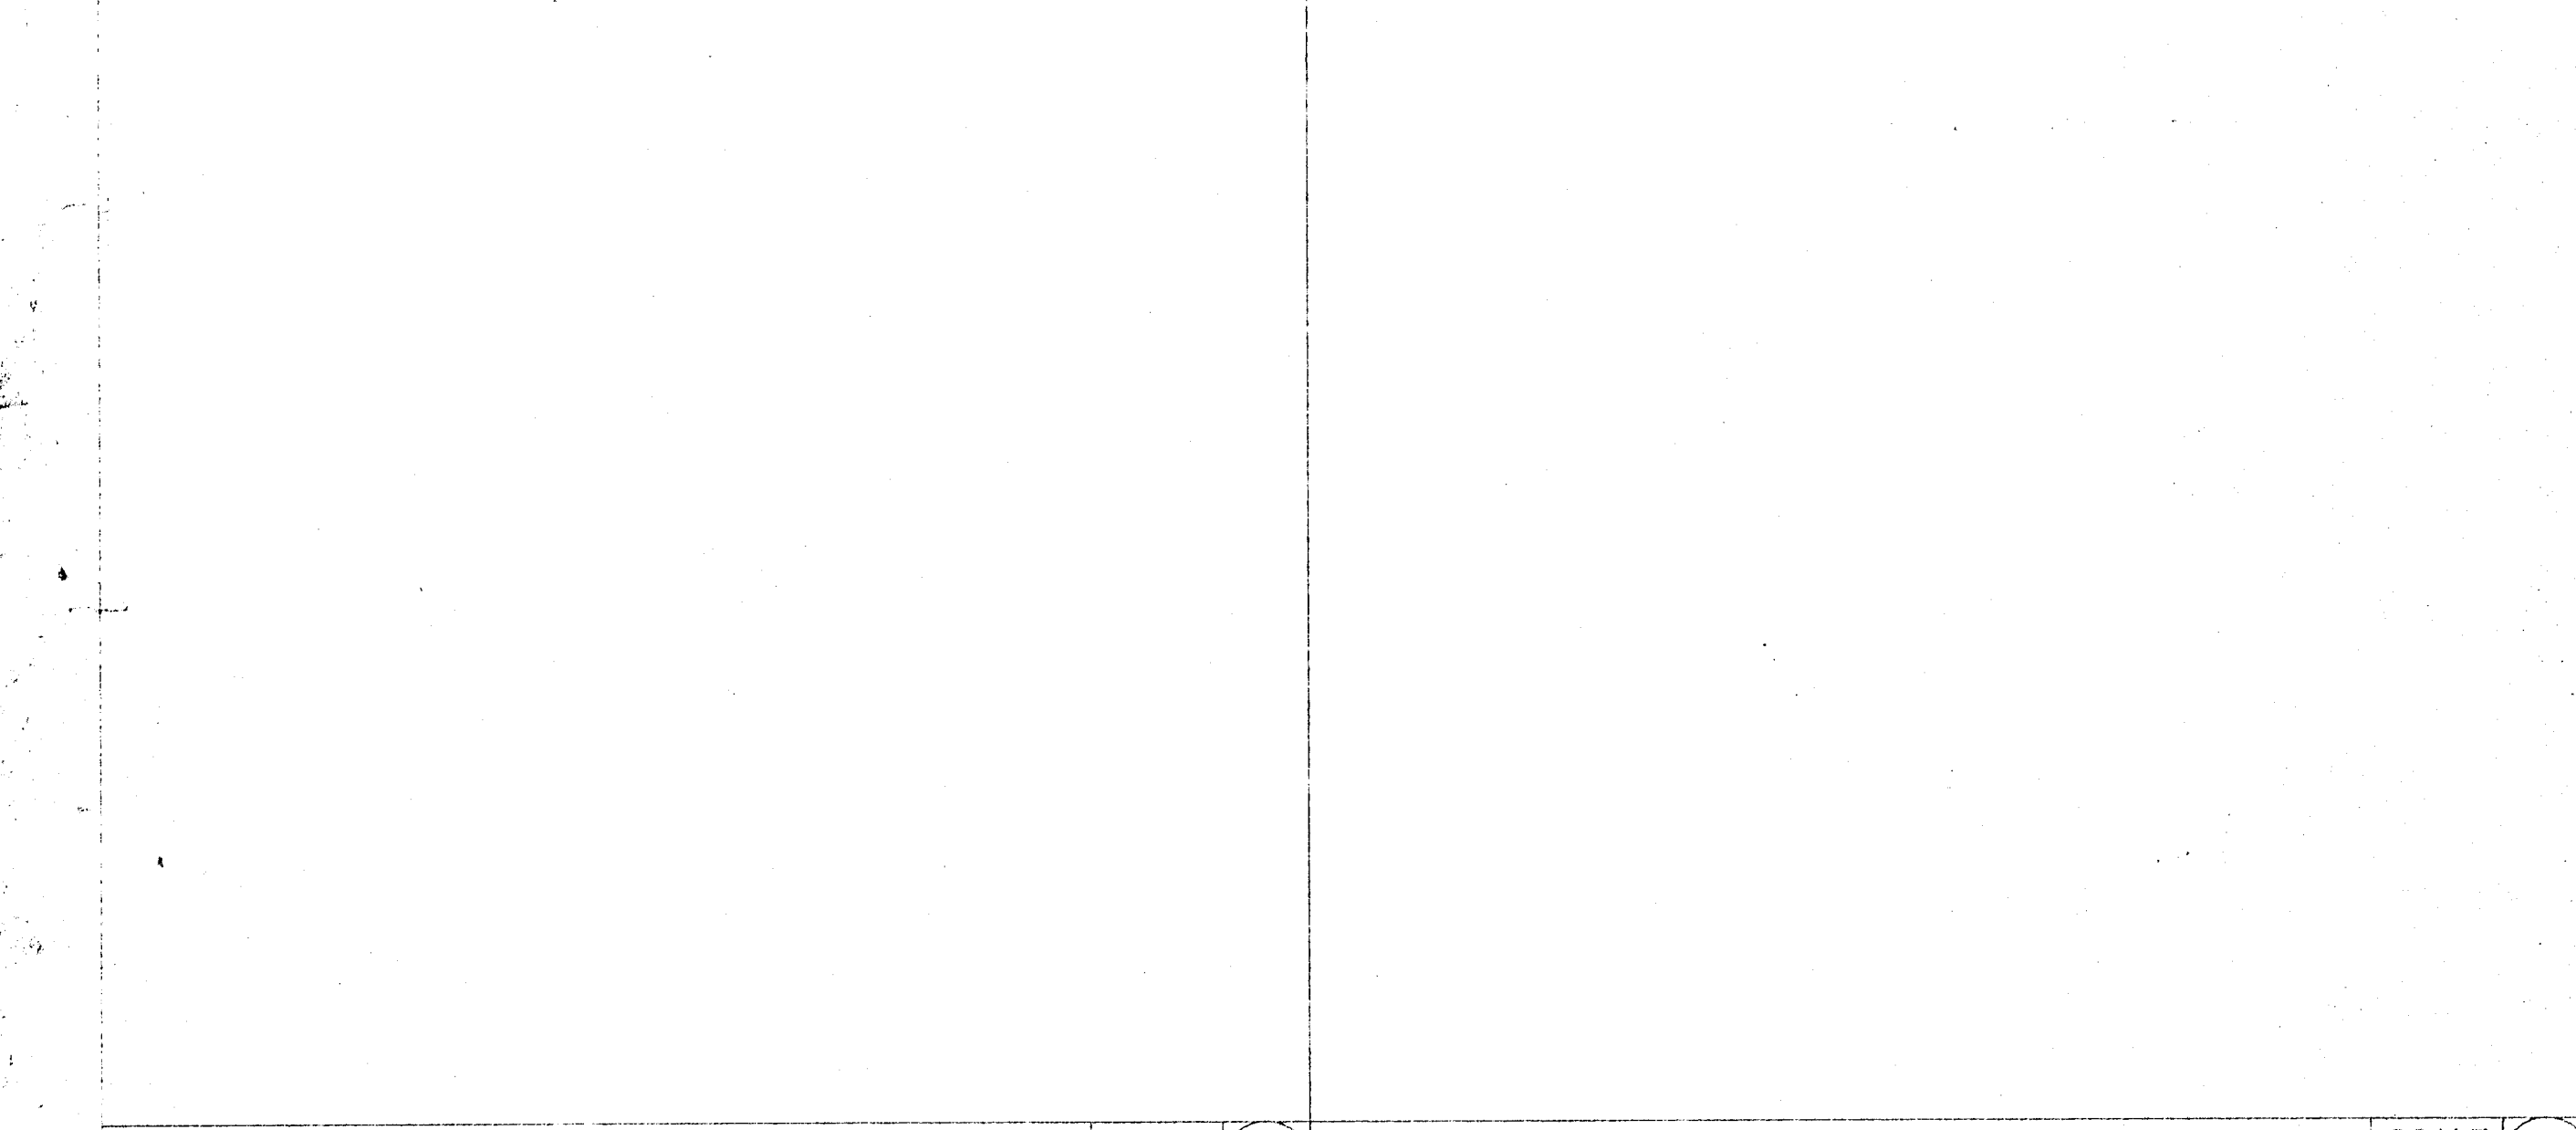

NOT USED SCALE NONE

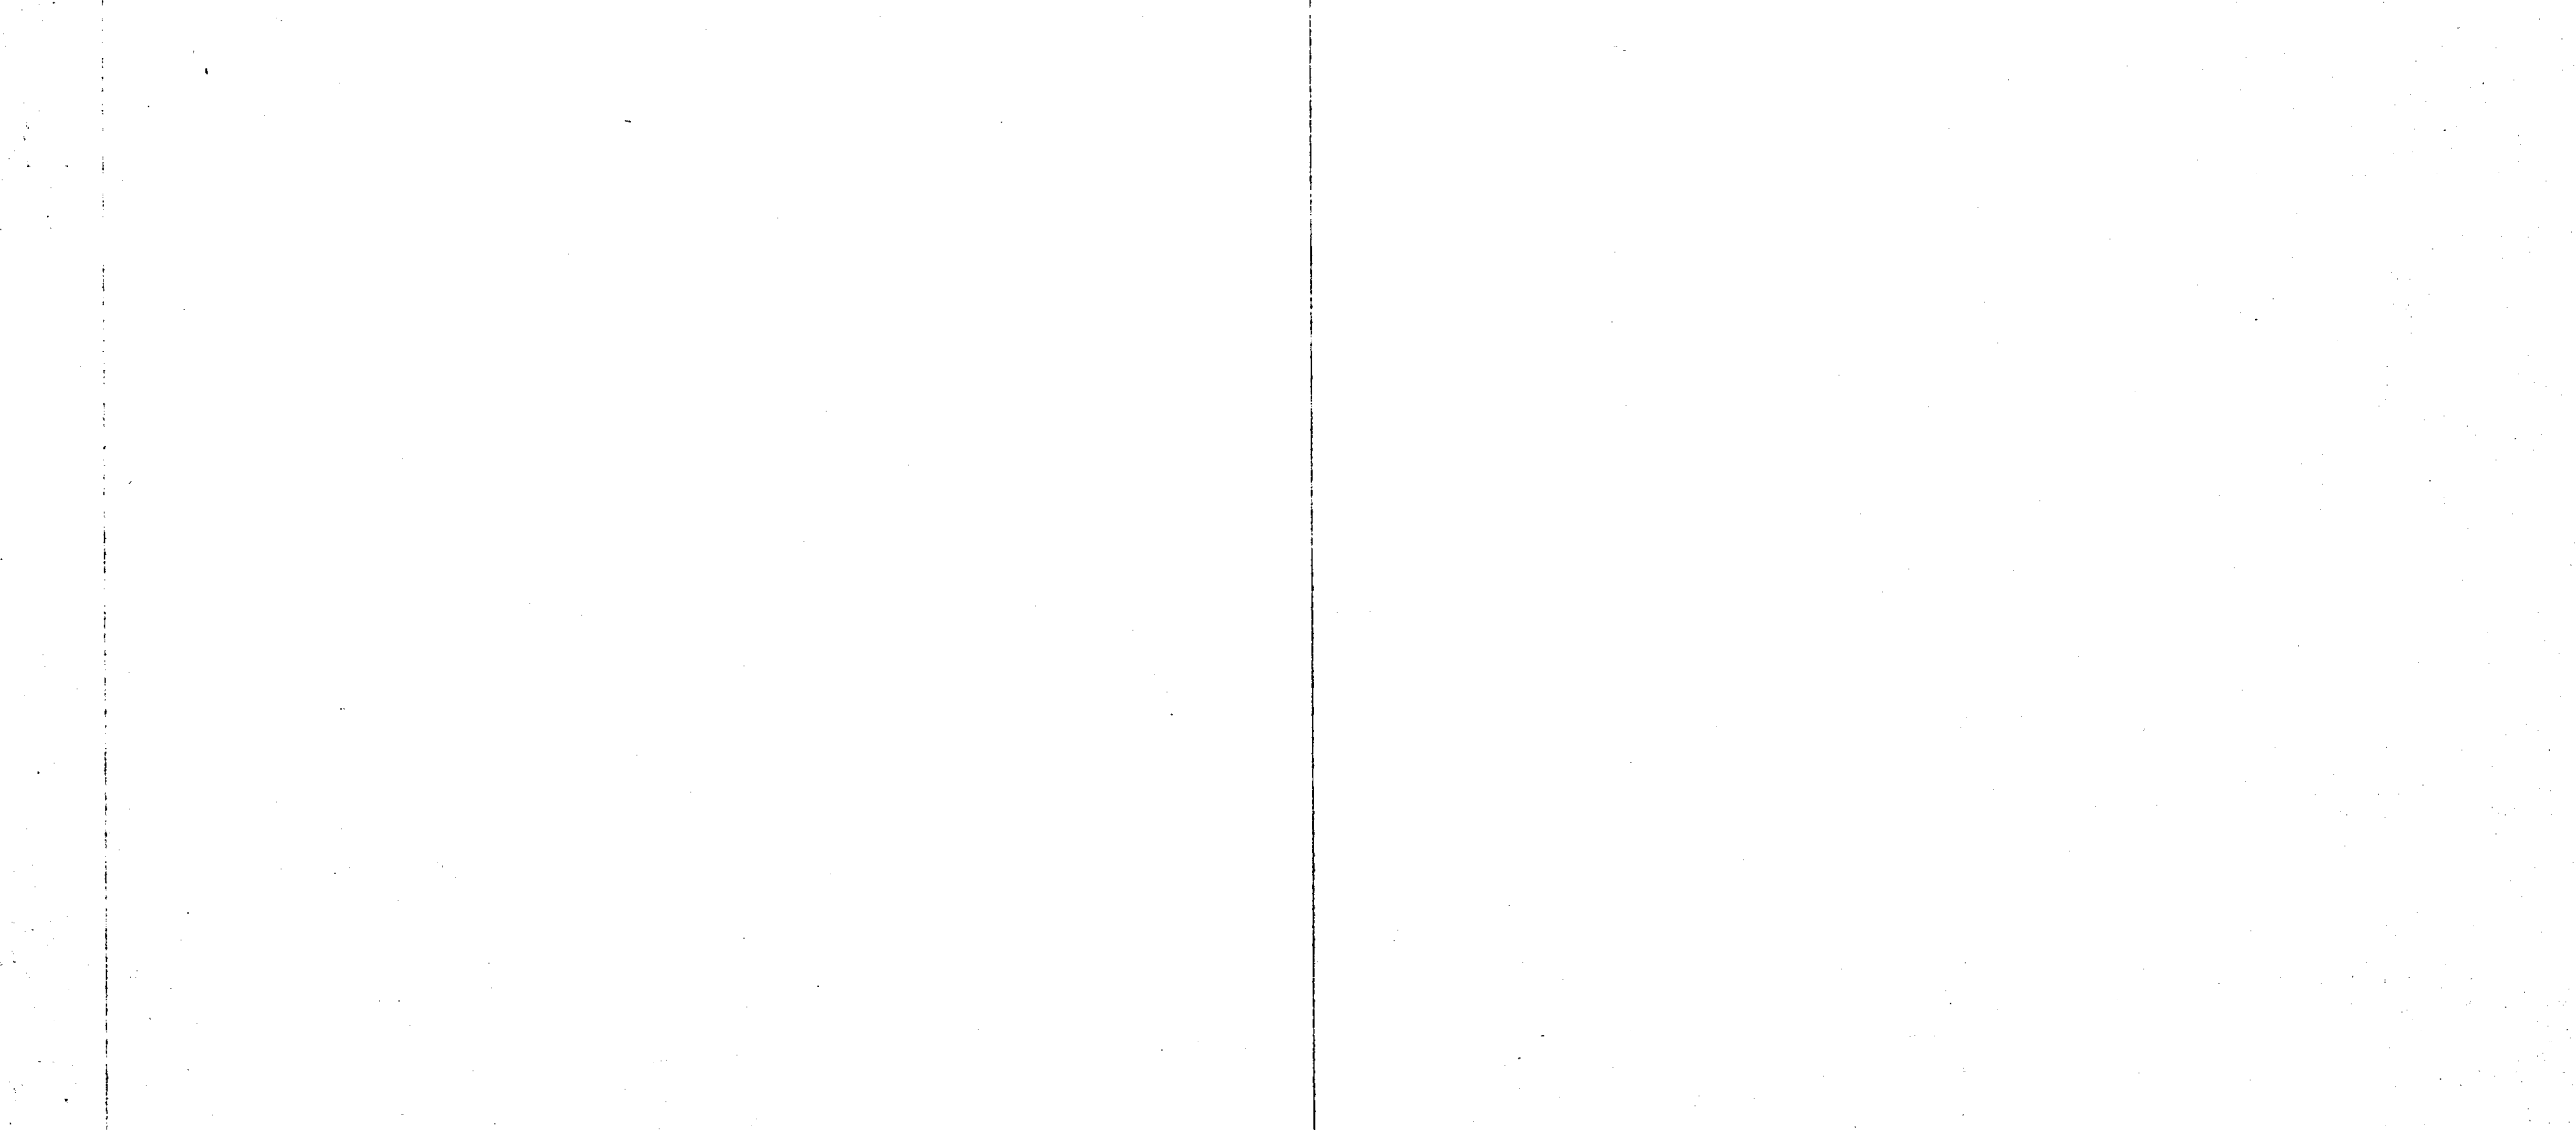

NOT USED SCALE NONE

NOT USED

SCALE NONE 17

NOT USED

SCALE NONE 13

AUTOMATIC SHUT OFF

SCALE NONE 10

POT WASHER HOOD EXHAUST

SCALE NONE 7

AC UNIT WIRING (WITH SMOKE DETECTOR/CO2 SENSOR)

SCALE NONE 3

NOT USED

SCALE NONE 16

NOT USED

SCALE NONE 12

EXHAUST FANS

SCALE NONE 9

EXHAUST FANS

SCALE NONE 6

TYPICAL ZONE DAMPER

SCALE NONE 2

NOT USED

SCALE NONE 15

EXHAUST FAN

SCALE NONE 11

KITCHEN HOOD EXHAUST AND MAKE-UP UNIT

SCALE NONE 8

PACKAGED GAS/ELEC. WIRING DIAGRAM

SCALE NONE 5

SUBZONED UNIT WITH BYPASS DAMPER

SCALE NONE 1

NOT USED













SCALE NONE 14

NOT USED

SCALE NONE 11

RISER DIAGRAMS

SCALE NONE 4

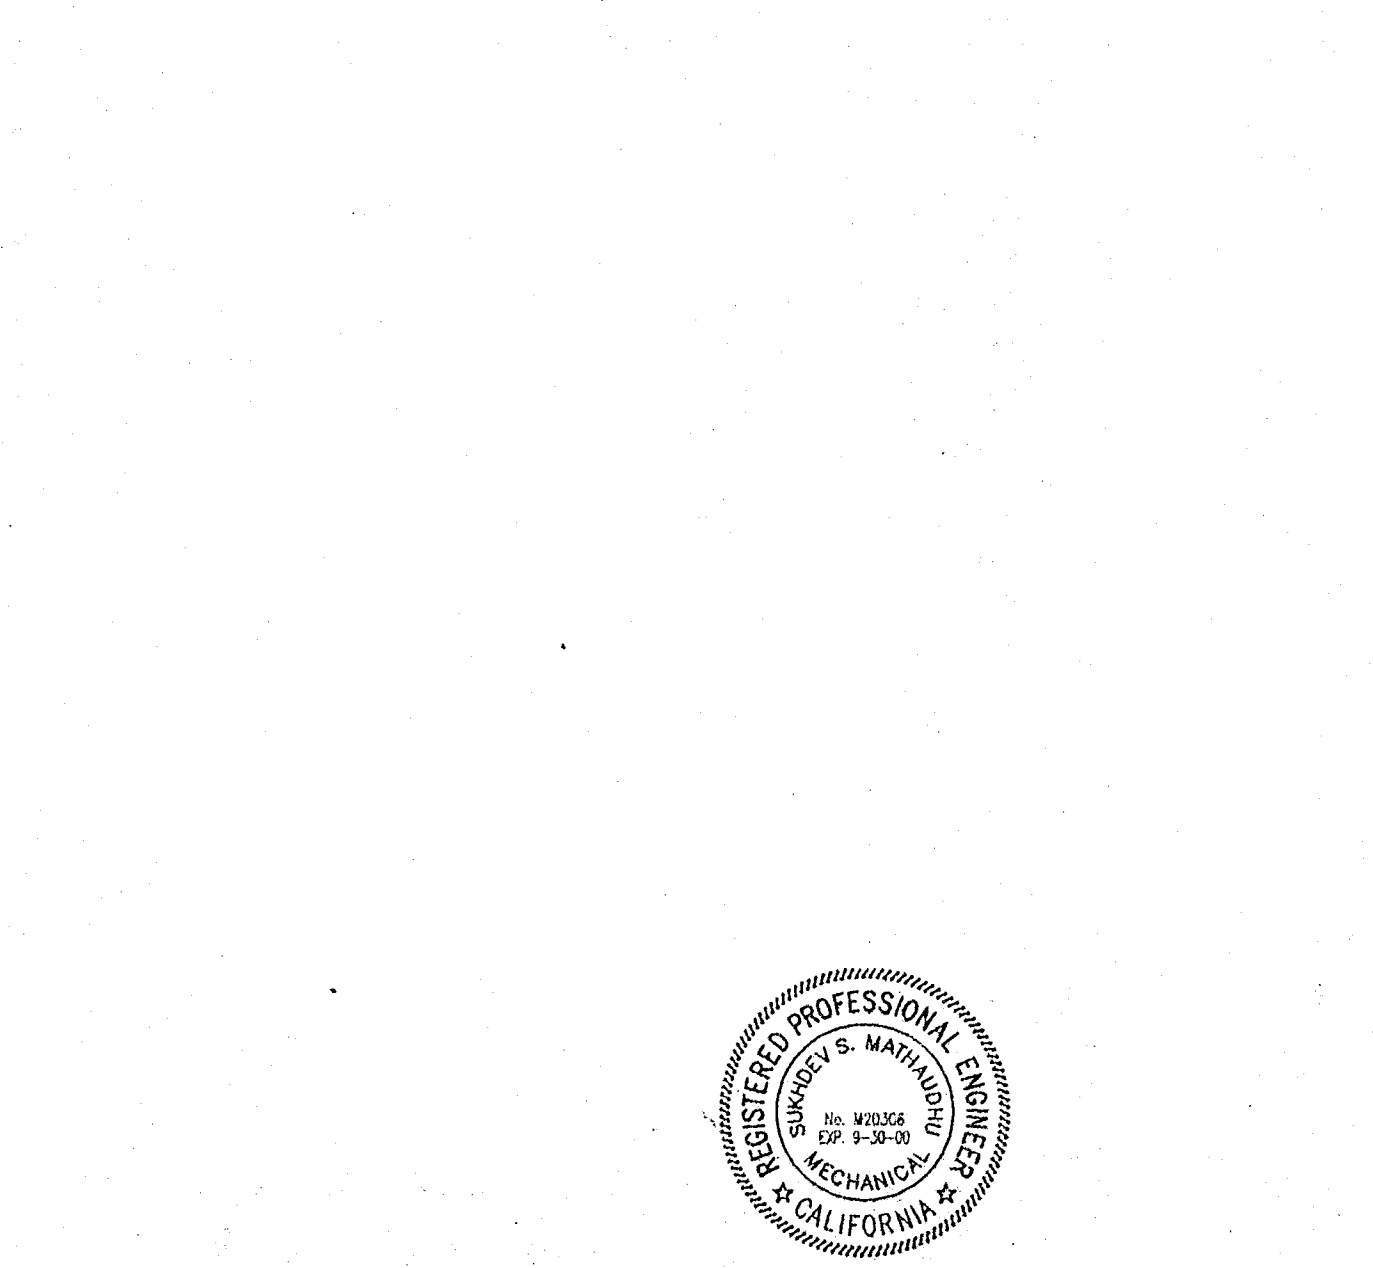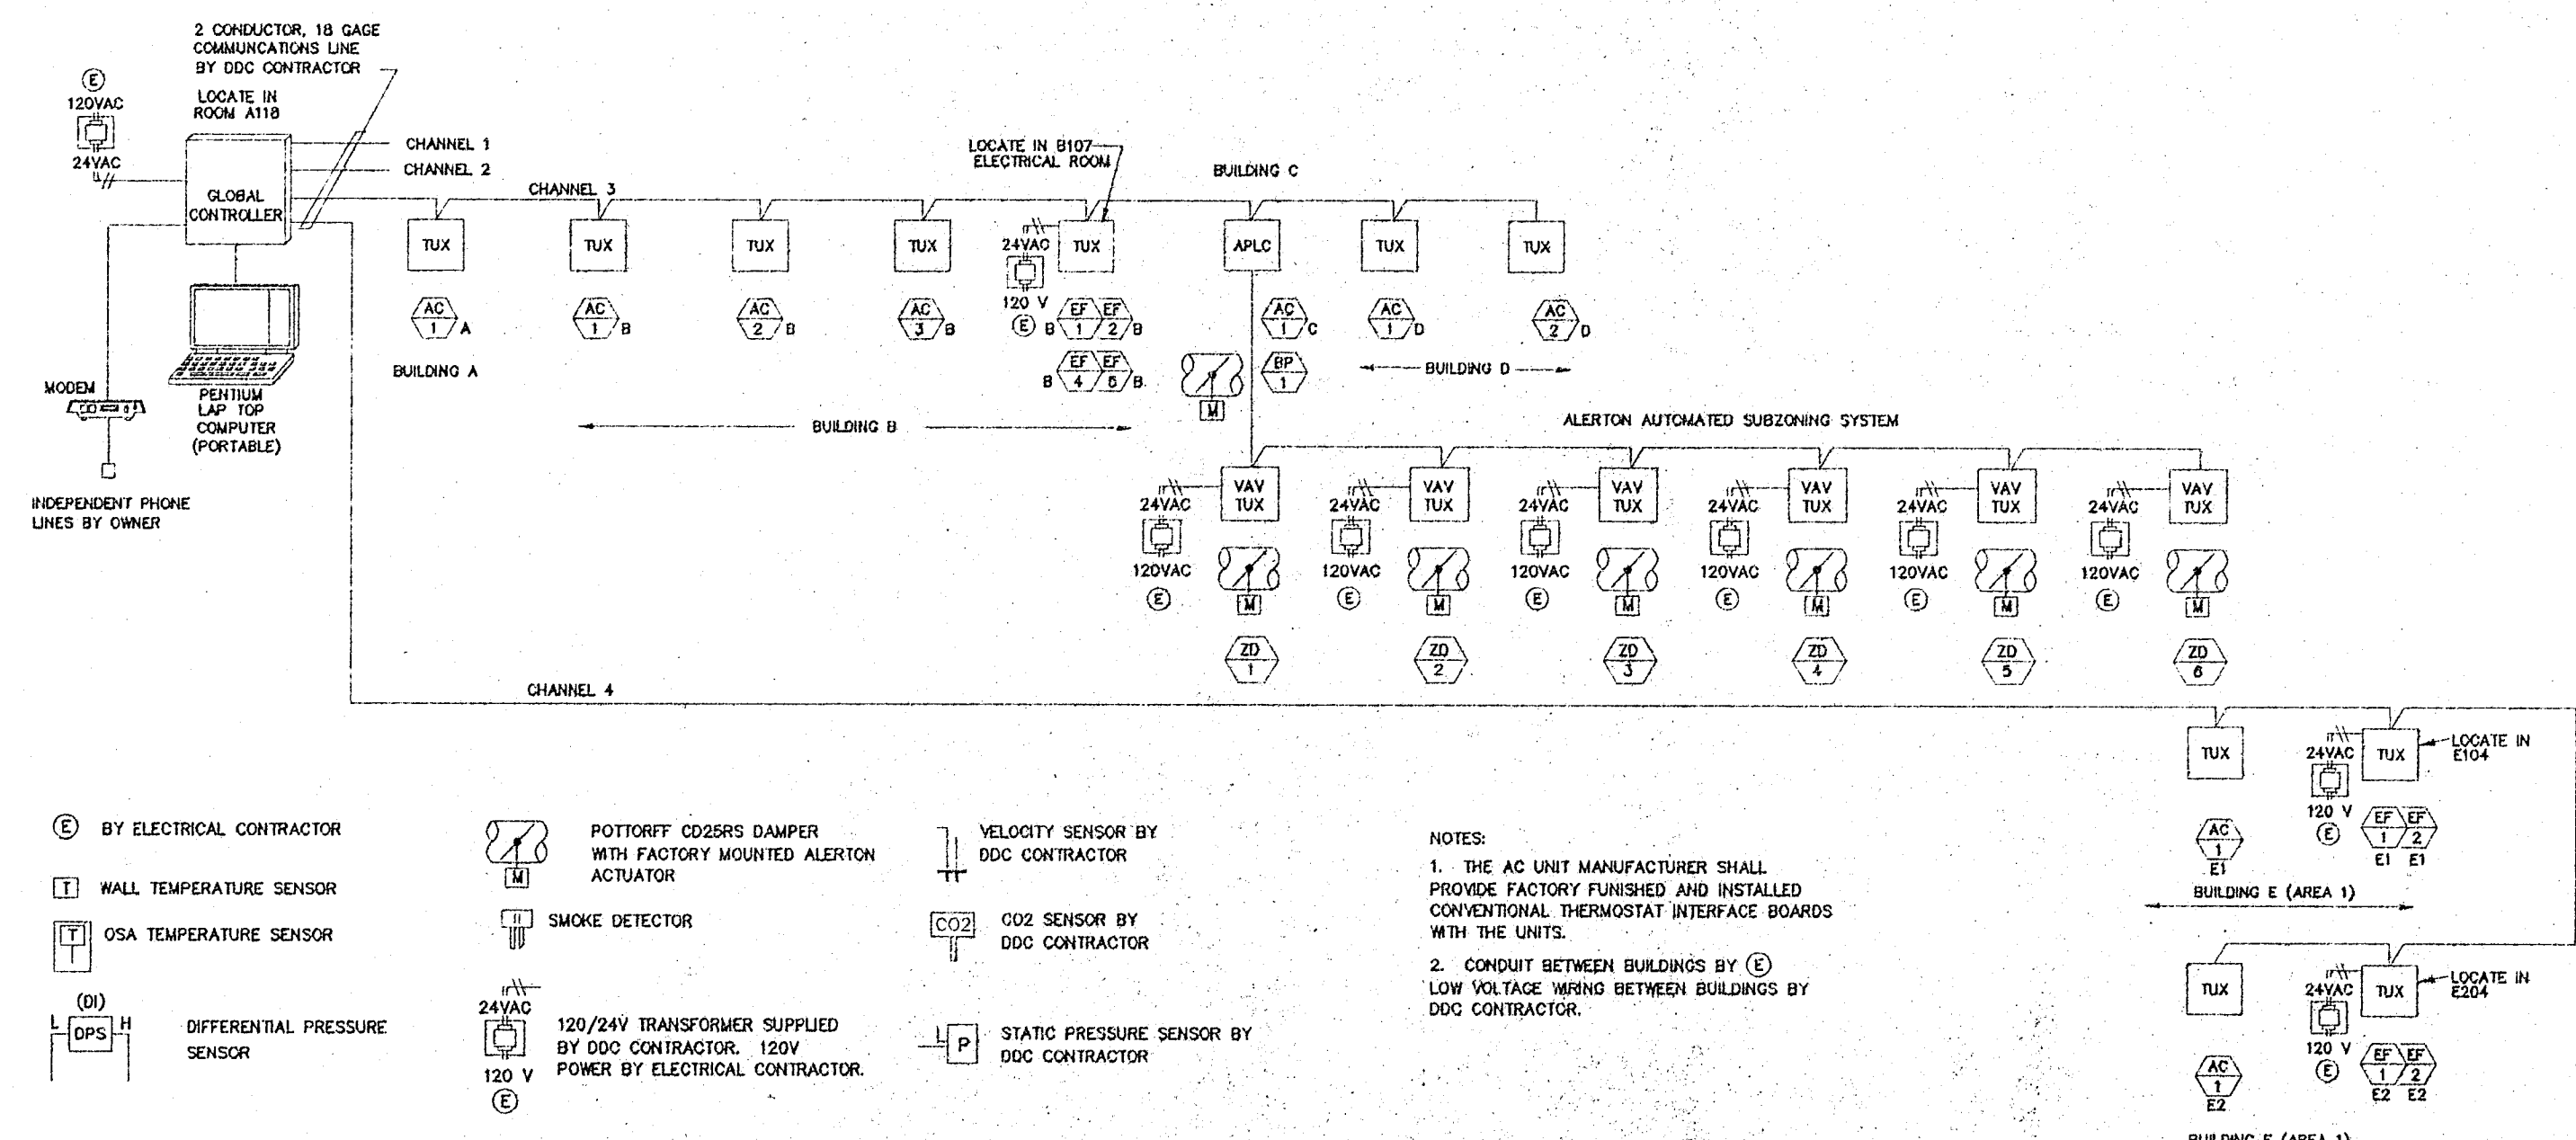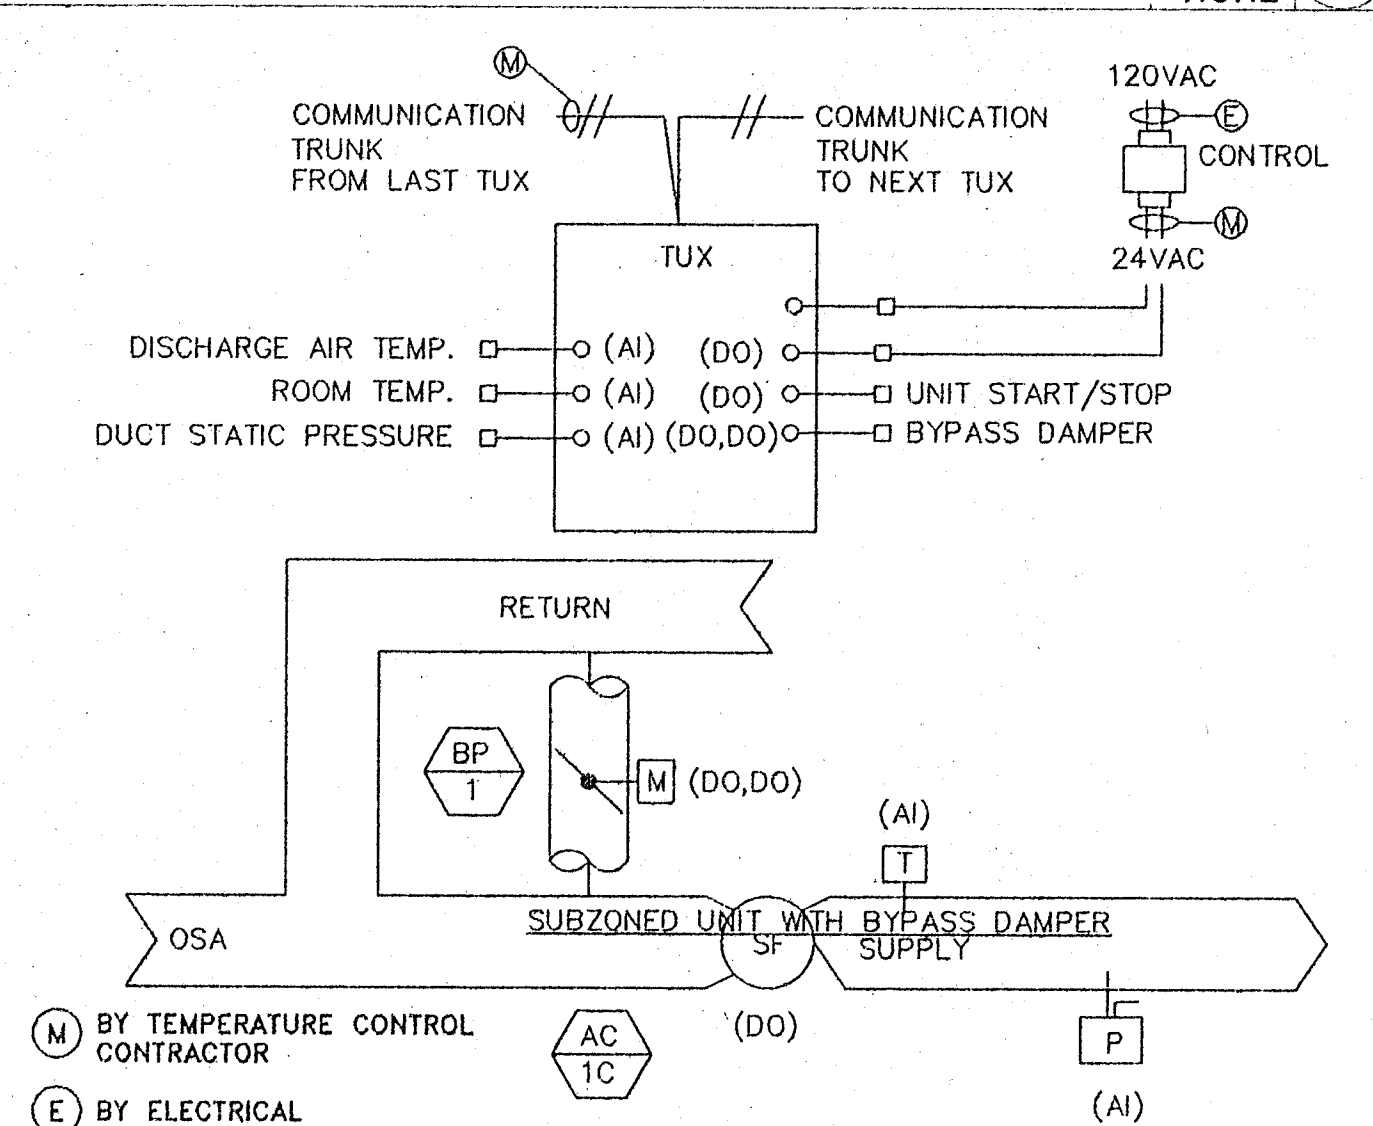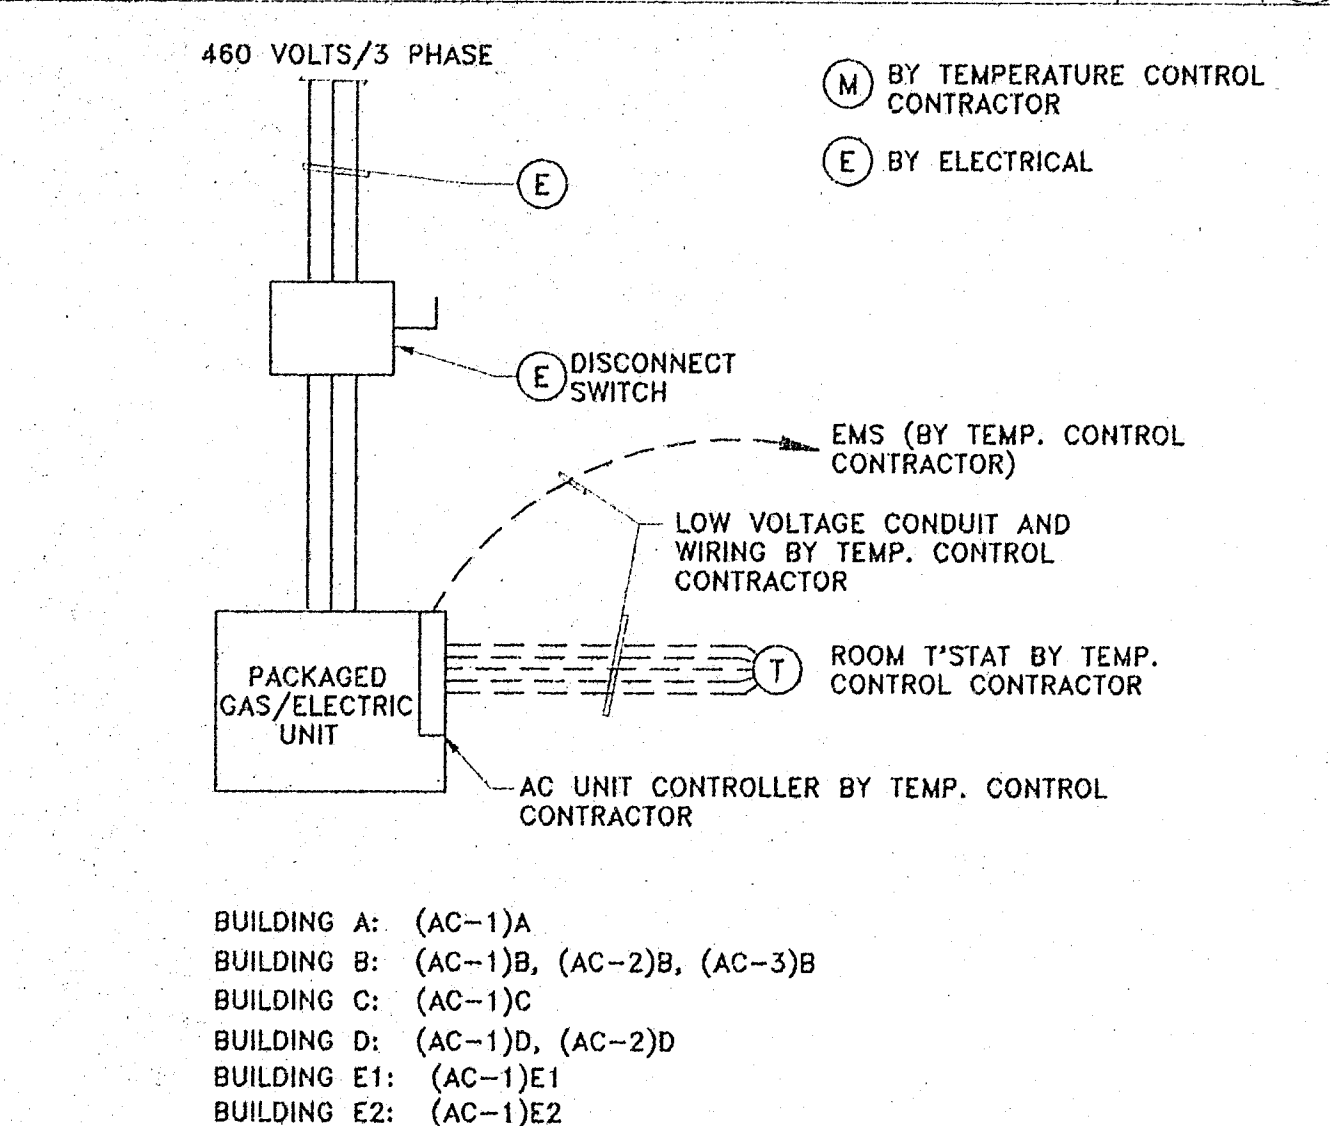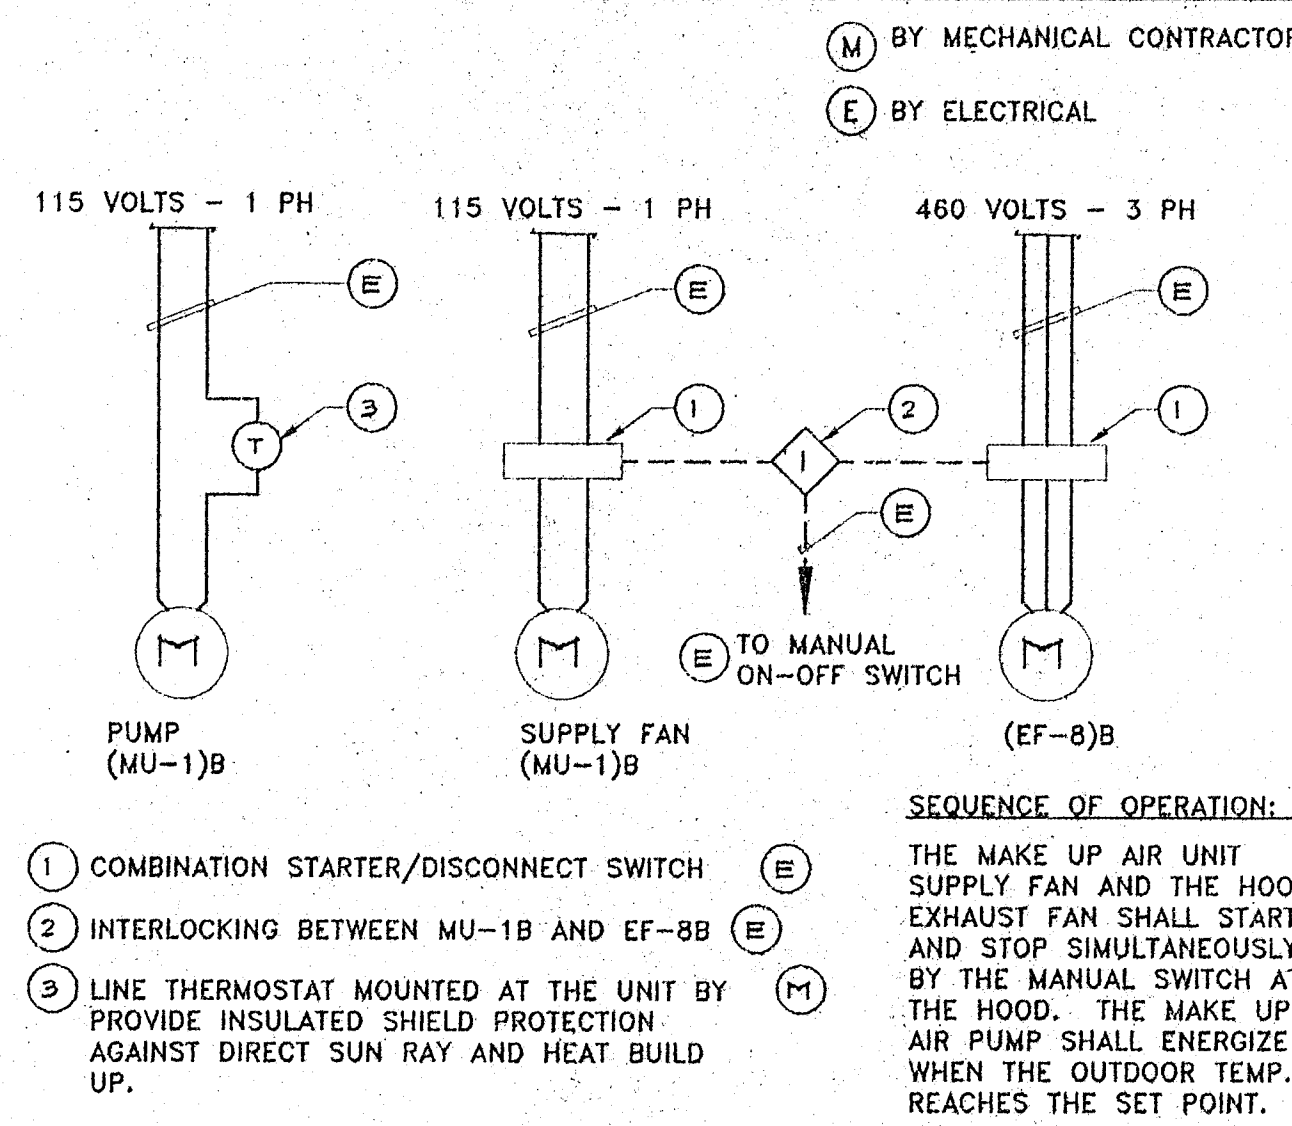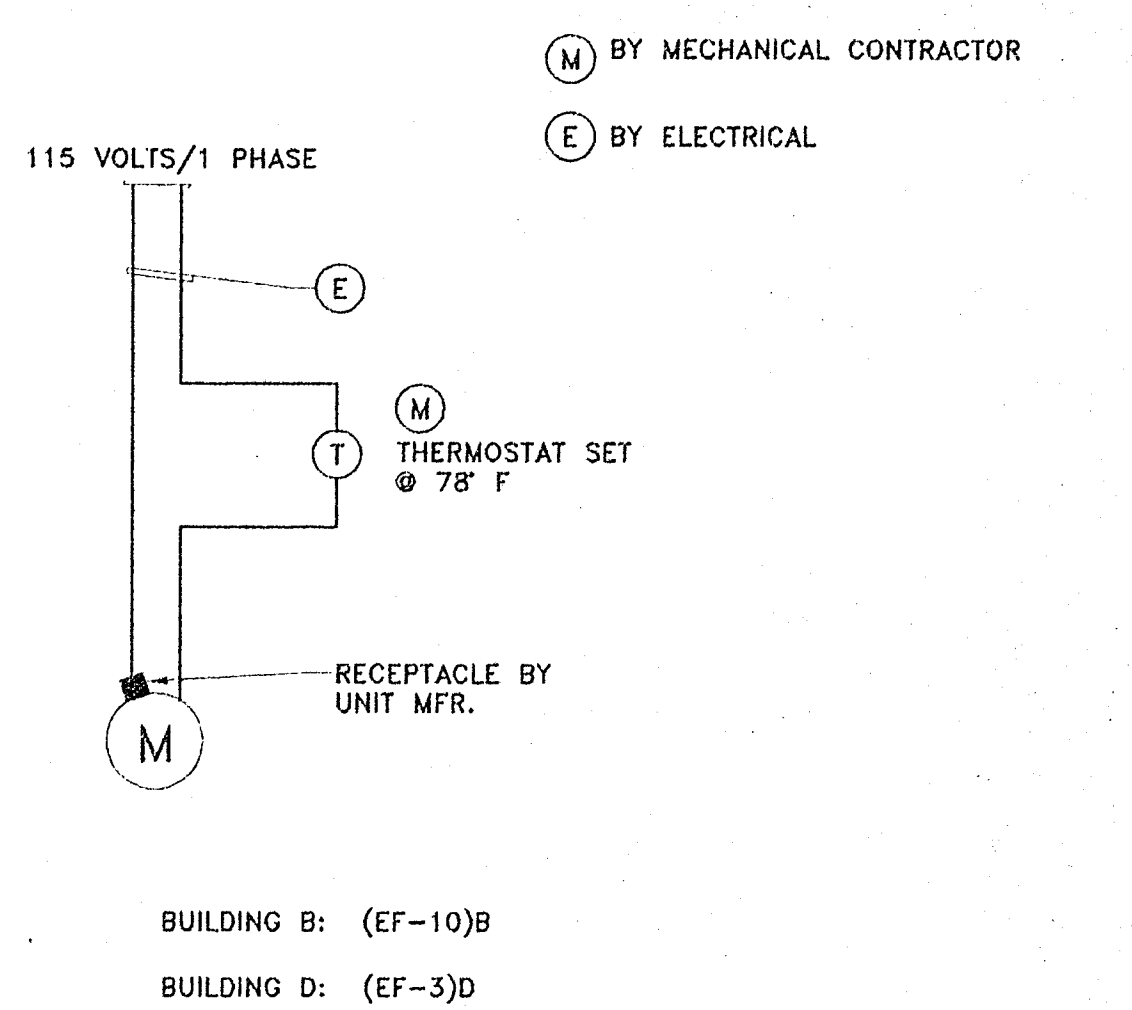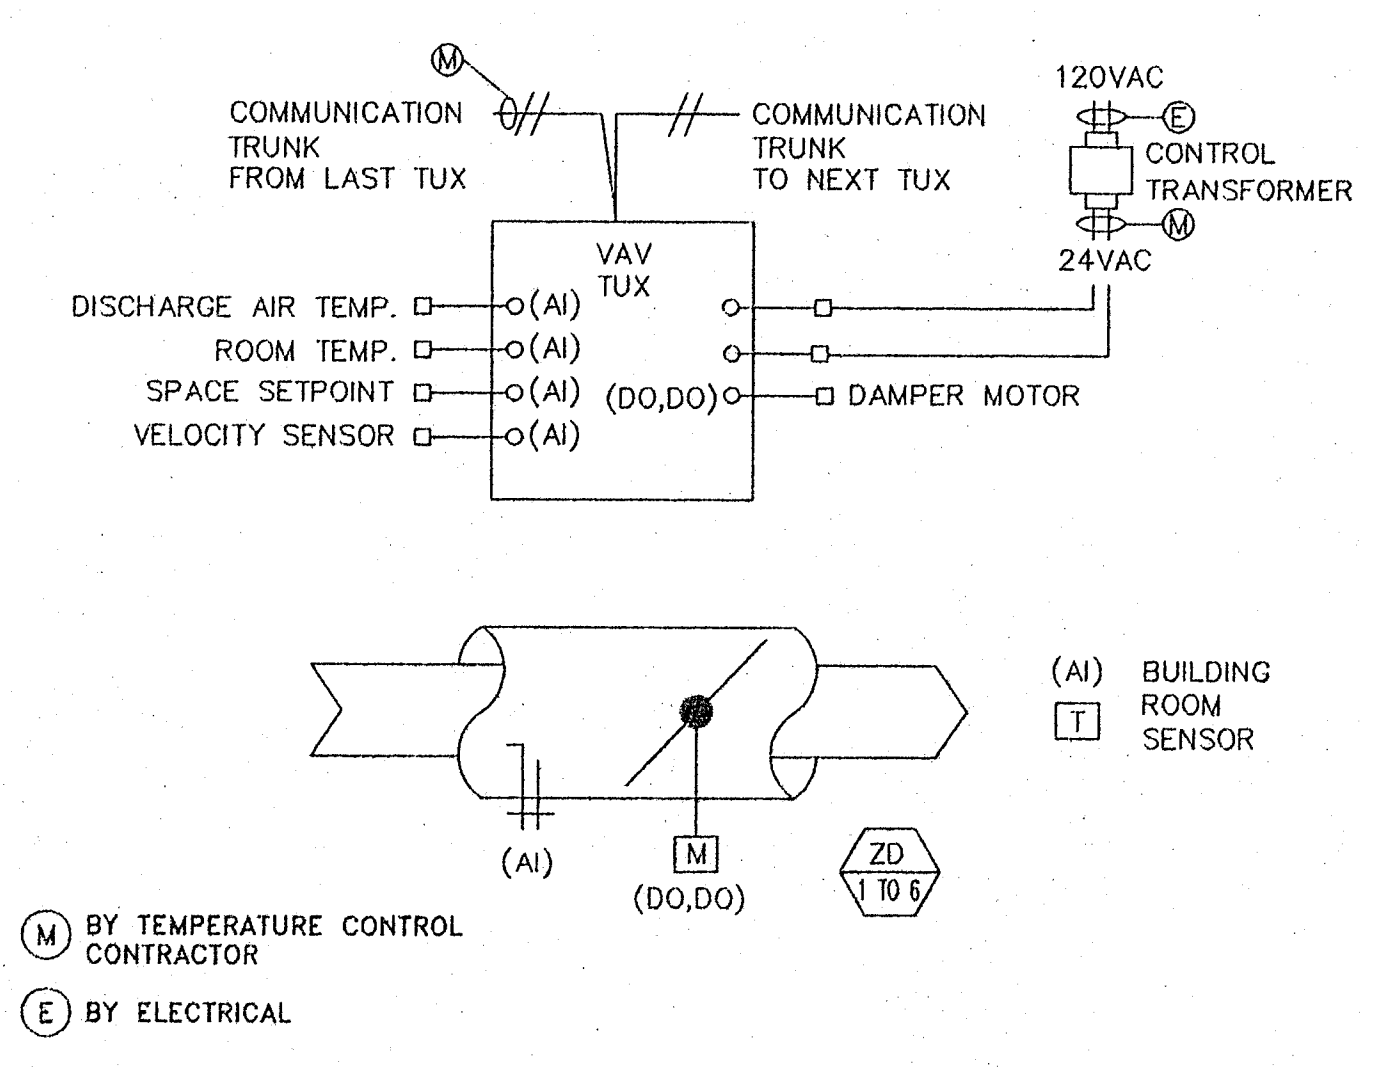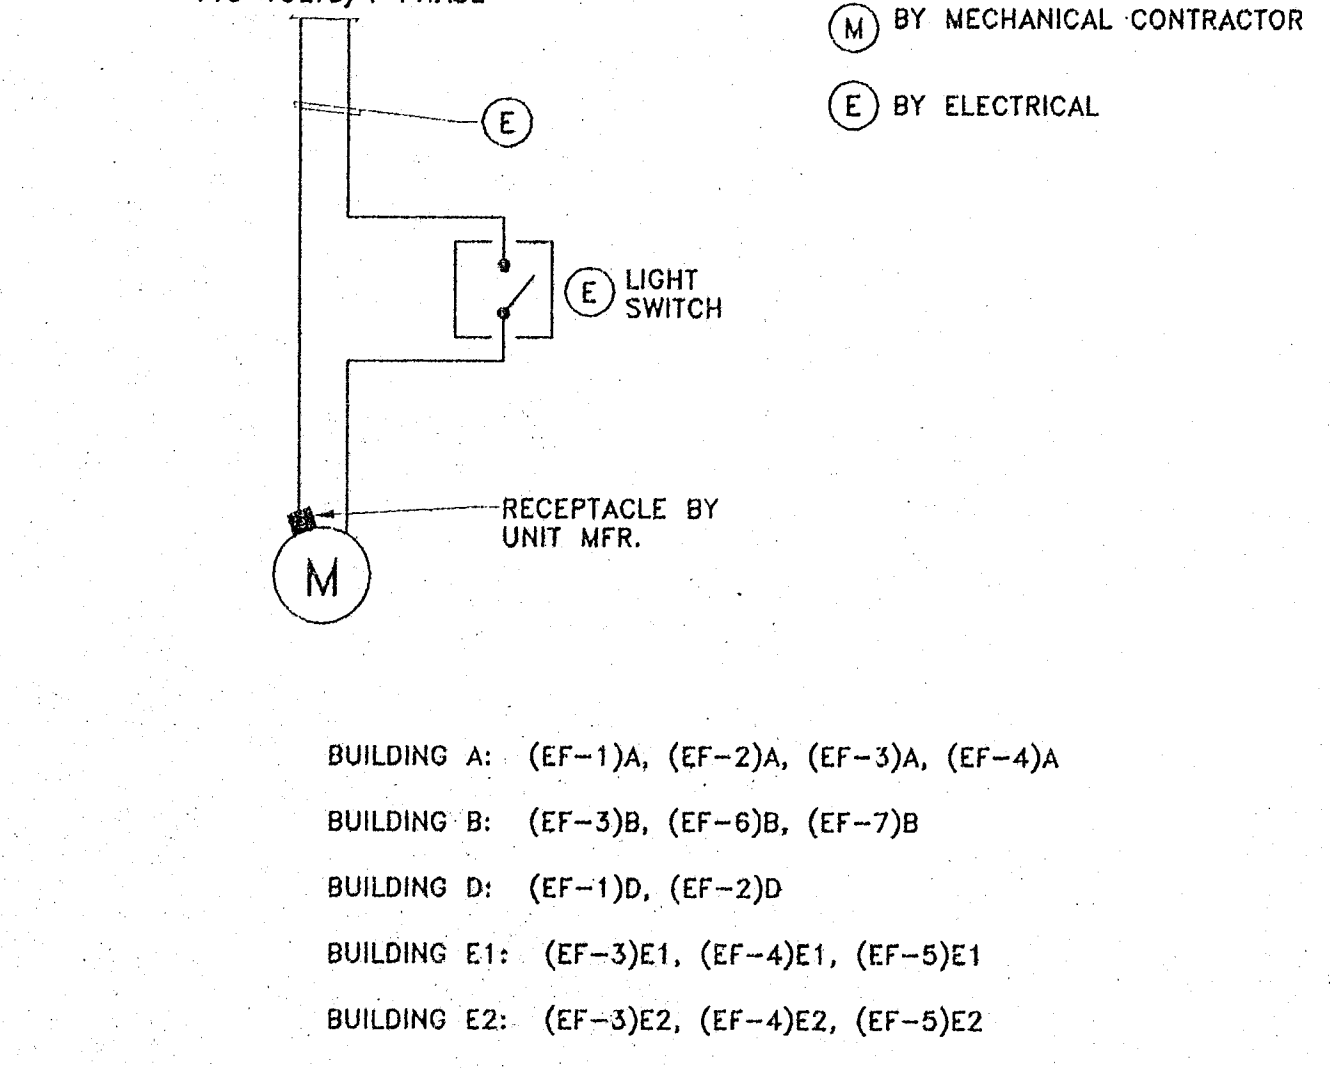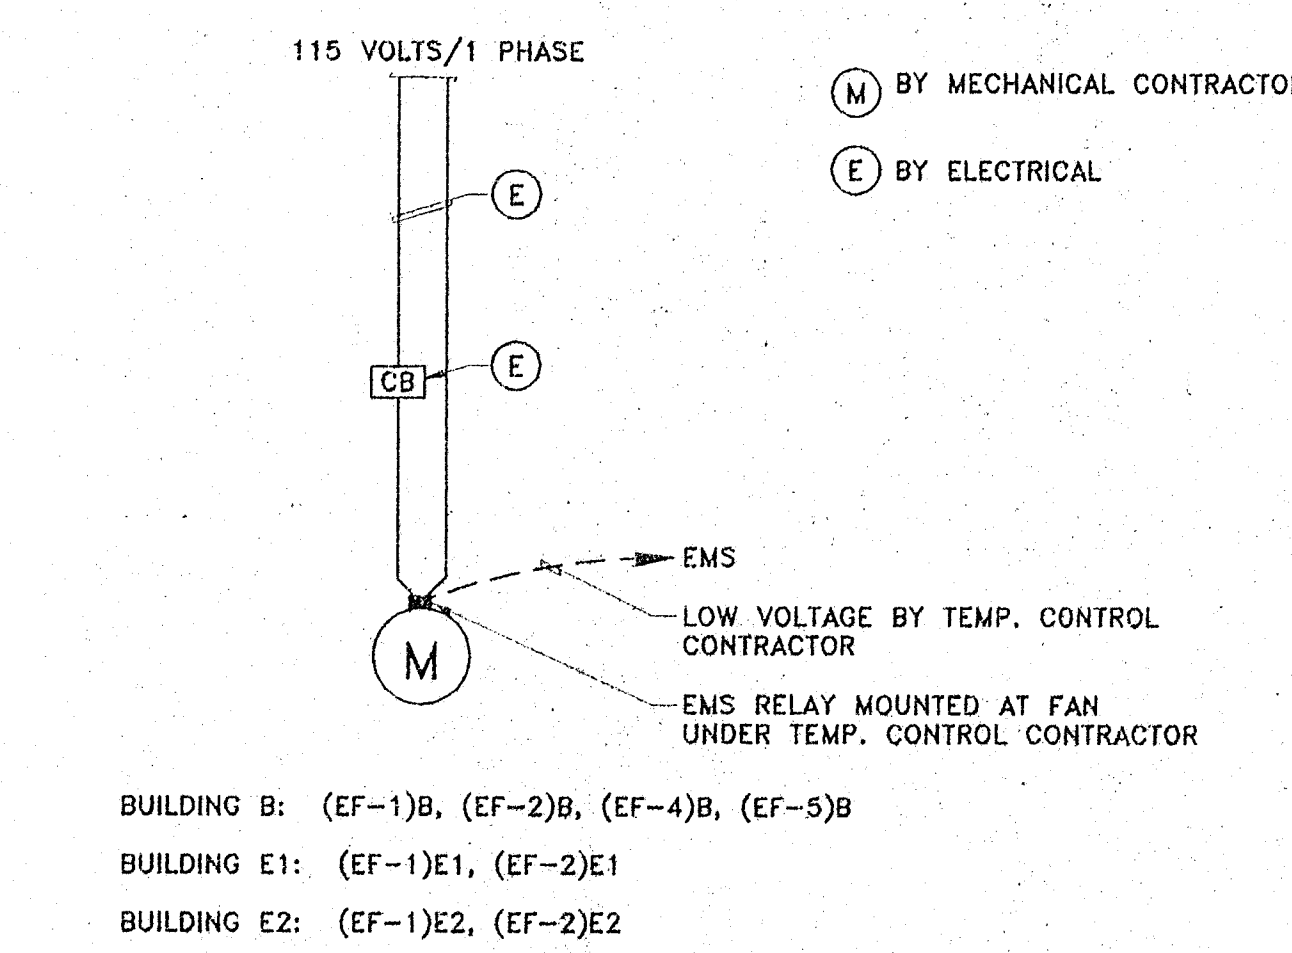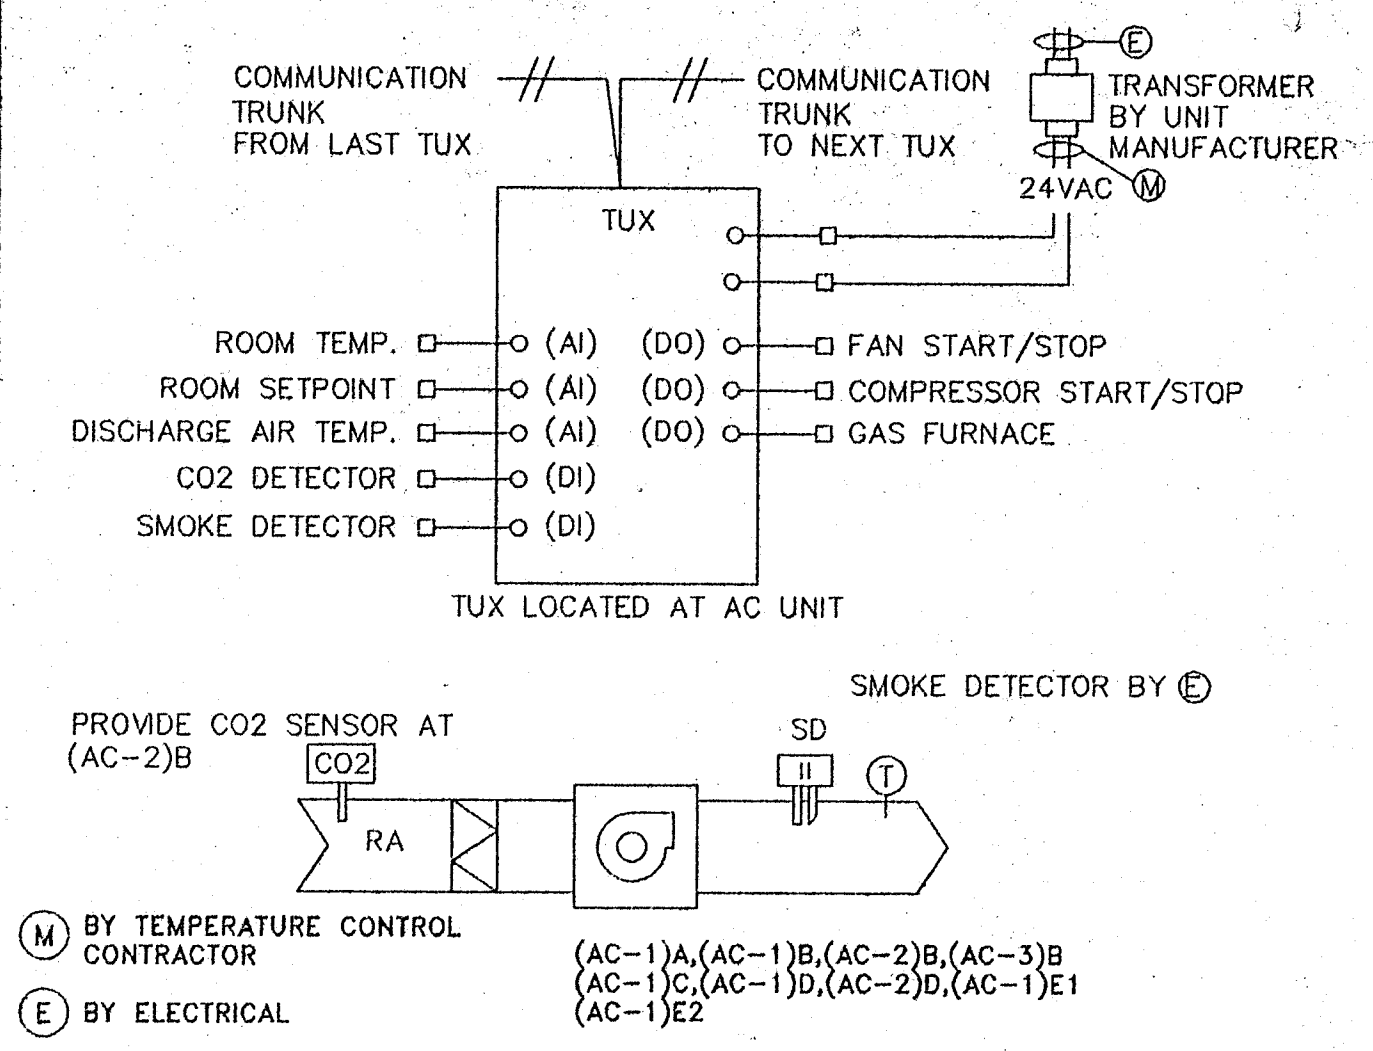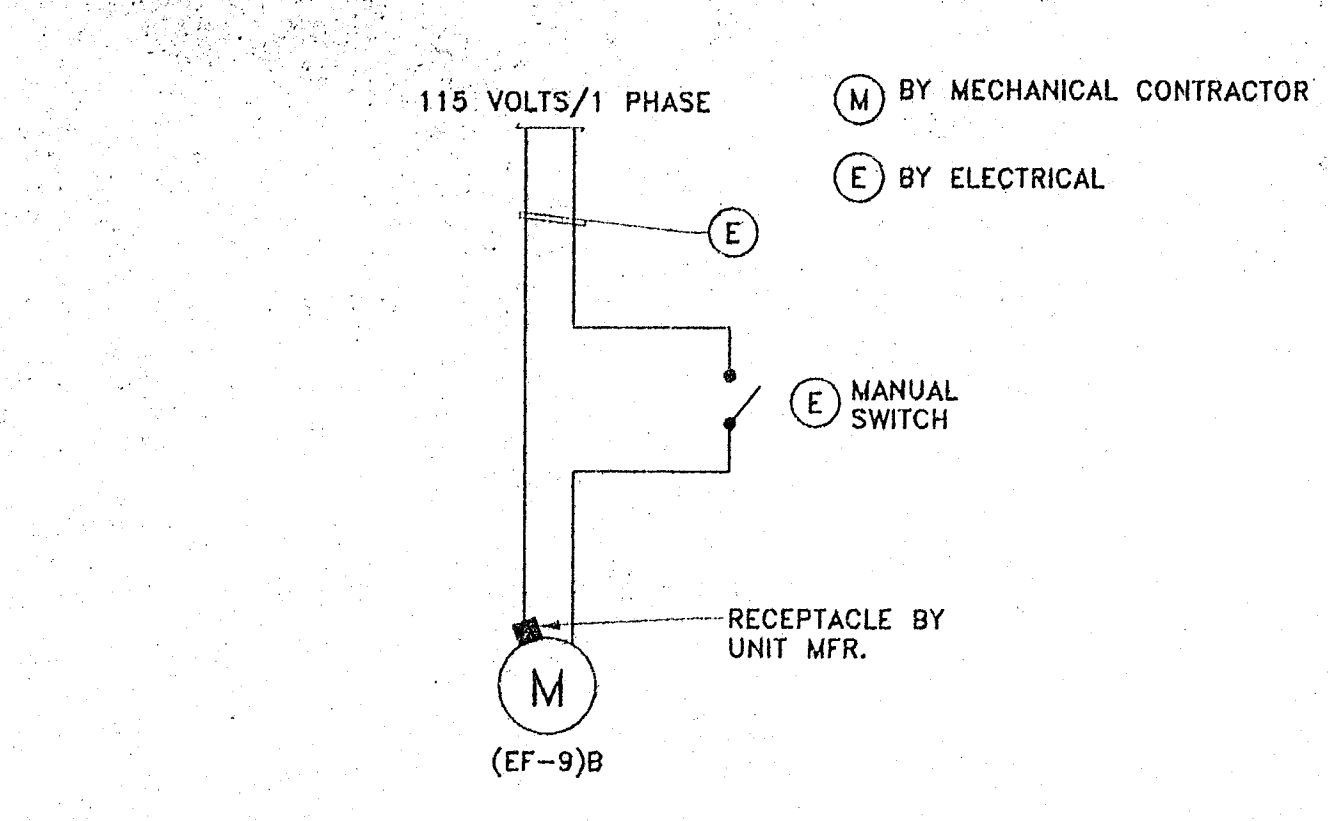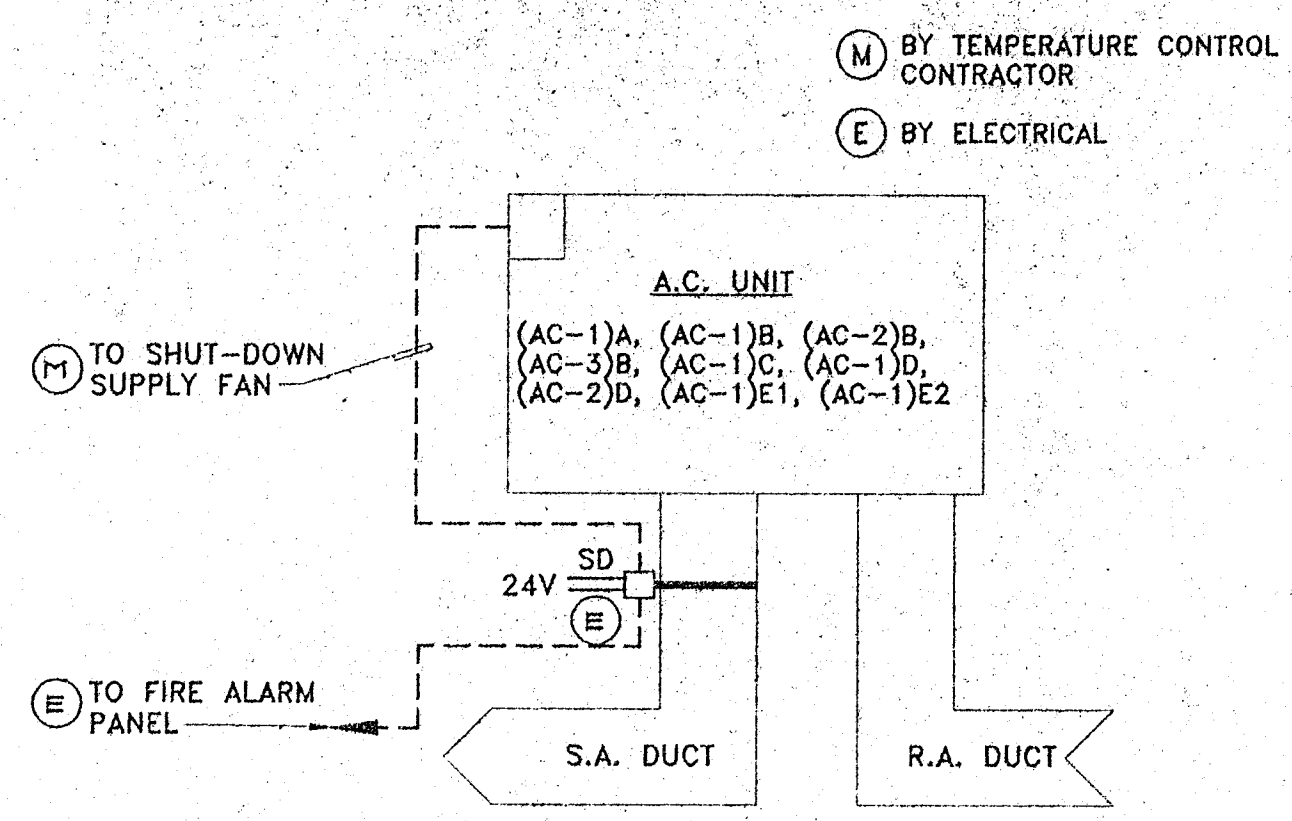

WLC
Architects

Virginia Dare Tower
10470 Foothill Blvd.
Roncho Cucamonga
California 91730-3754
tel: 909 987 0909
fax: 909 980 9960

Tovoshal Elementary School
Murrieta Valley
Unified School District

KEY PLAN

CONSULTANT

APPROVED

APPROVED

IDENTIFICATION STAMP
DIV. OF THE STATE ARCHITECT
OFFICE OF REGULATION SERVICES
APPL 5 B 3 4 4
AC FLS 24 SS 97

APPROVED

LICENSED ARCHITECT
GEORGE H. WEISS
C-14546
3028-31-97
STATE OF CALIFORNIA

NO DATE BY REMARKS

MECHANICAL CONTROLS AND DIAGRAMS

DRAWN
CHECKED
DATE MAY 1997
SCALE 1/8"=1'-0"
JOB NO. 95113

M-41

MATHAUDHU ENGINEERING, INC.
CONSULTING MECHANICAL ENGINEERS
3833 JURUPA AVENUE, RIVERSIDE, CALIFORNIA, 92504-2211
(909) 698-1776 FAX (909) 698-5081

CERTIFICATE OF COMPLIANCE Part 1 of 3 **MECH-1**

PROJECT NAME: THOMPSON MIDDLE SCHOOL
PROJECT ADDRESS: MURRIETA, CALIFORNIA
PRINCIPAL DESIGNER: SUKHDEV S. MATHAUDHU
DOCUMENTATION AUTHOR: BUN T. SO

GENERAL INFORMATION: DATE OF PLANS: JAN. 94
BUILDING CONDITIONED FLOOR AREA: 76,338 S.F. (TOTAL OF 5 BLDGS.)
BUILDING TYPE: NONRESIDENTIAL
PHASE OF CONSTRUCTION: NEW CONSTRUCTION

STATEMENT OF COMPLIANCE: The Certificate of Compliance lists the building features and performance specifications needed to comply with Title 24, Parts 1 and 6 of the California Code of Regulations.

Please check one:
I hereby affirm that I am eligible under the provisions of Division 3 of the Business and Professions Code to sign this document as the person responsible for its preparation; and that I am a civil engineer, mechanical engineer, or architect.

I affirm that I am eligible under the exemption to Division 3 of the Business and Professions Code by Section 5537.2 of the Business and Professions Code to sign this document as the person responsible for its preparation; and that I am a licensed contractor preparing documents for work that I have contracted to perform.

I affirm that I am eligible under the exemption to Division 3 of the Business and Professions Code by Section 5537.2 of the Business and Professions Code to sign this document as the person responsible for its preparation; and for the following reason:

MECHANICAL MANDATORY MEASURES: Indicate location on plans of Note Block for Mandatory Measures: NO. 1

INSTRUCTIONS TO APPLICANT: For detailed instructions on the use of this and all Energy Efficiency Standards compliance forms, please refer to the Nonresidential Manual published by the California Energy Commission.

MECHANICAL MANDATORY MEASURES: Indicate location on plans of Note Block for Mandatory Measures: NO. 1

MECHANICAL MANDATORY MEASURES: Indicate location on plans of Note Block for Mandatory Measures: NO. 1

MANDATORY MEASURES

- EQUIPMENT AND SYSTEMS EFFICIENCY
APPLIANCES FOR WHICH THERE IS A CALIFORNIA STANDARD ESTABLISHED BY THE APPLIANCE EFFICIENCY STANDARDS...
BUILDING SPACE CONDITIONING EQUIPMENT MAY BE INSTALLED ONLY IF THE MANUFACTURER HAS CERTIFIED THAT THE EQUIPMENT MEETS OR EXCEEDS ALL APPLICABLE EFFICIENCY REQUIREMENTS...
PIPEWORK, EXCEPT THOSE SERVING FLUIDS AT TEMPERATURES BETWEEN 80 DEGREES F AND 105 DEGREES F, OR WITHIN FLEX EQUIPMENT, SHALL BE INSULATED IN ACCORDANCE WITH STANDARDS P12.

GENERAL NOTES

- 1. ALL INSTALLATION TO CONFORM TO UNIFORM MECHANICAL CODE AND ALL OTHER LOCAL CODES AND ORDINANCES HAVING JURISDICTION.
2. THE MECHANICAL SUB-CONTRACTOR SHALL COORDINATE WITH ALL OTHER TRADES TO ELIMINATE ANY FIELD AND INSTALLATION PROBLEMS.
3. COORDINATE ALL CEILING DIFFUSERS WITH REFLECTED CEILING PLAN OR AS DIRECTED BY THE ARCHITECT.
4. THE MECHANICAL SUB-CONTRACTOR SHALL CONFIRM ELECTRICAL CHARACTERISTICS WITH ELECTRICAL CONTRACTOR PRIOR TO ORDERING EQUIPMENT AND CONTROLS.

ENERGY NOTES

- TITLE 24 HVAC MANDATORY MEASURES (PART 6)
THE CONTRACTOR SHALL BE RESPONSIBLE FOR ALL ITEMS TO BE INSTALLED IN COMPLIANCE WITH THE FOLLOWING MEASURES:
1. AUTOMATIC TEMPERATURE CONTROL DEVICE FOR REGULATION OF SPACE TEMPERATURE SHALL BE CAPABLE OF BEING SET FROM 55° F TO 95° F AND HAVE THE ABILITY TO OPERATE THE HEATING AND COOLING IN SEQUENCE, IF BOTH ARE PROVIDED.
2. ALL HVAC EQUIPMENT TO BE IN COMPLIANCE WITH TITLE 24, SECTION III.
3. ALL HVAC EQUIPMENT EFFICIENCIES SHALL COMPLY WITH TITLE 24, SECTION 112.
4. ALL HVAC CONTROLS TO BE IN COMPLIANCE WITH TITLE 24, SECTION 122.
5. VENTILATION REQUIREMENTS COMPLY WITH STATE MECHANICAL CODE TITLE 24, SECTION 121.
6. SUMMER & WINTER DESIGN TEMPERATURES SHALL COMPLY WITH C.C.R.-TITLE 24, PART 2, SECTION 144.
7. ALL PILOTLESS IGNITION OF GAS APPLIANCES SHALL COMPLY WITH SECTION 115.

SEISMIC BRACING NOTES

- ALL MECHANICAL EQUIPMENT SHALL BE BRACED OR ANCHORED TO RESIST A HORIZONTAL FORCE ACTING IN ANY DIRECTION USING THE FOLLOWING CRITERIA:
A. 1. FIXED EQUIPMENT ON GRADE 20% OF OPERATING WEIGHT.
2. FIXED EQUIPMENT ON STRUCTURE 50% OF OPERATING WEIGHT.
3. EMERGENCY POWER EQUIPMENT ON GRADE 50% OF OPERATING WEIGHT.
4. EMERGENCY POWER EQUIPMENT ON STRUCTURE 50% OF OPERATING WEIGHT.
B. FOR EQUIPMENT WEIGHING LESS THAN 400 POUNDS, THE FIELD INSTALLATION SHALL BE SUBJECT TO THE APPROVAL OF THE MECHANICAL ENGINEER AND THE FIELD REPRESENTATIVE OF STATE ARCHITECT.
C. FOR EQUIPMENT WEIGHING 400 POUNDS OR MORE AND ALL SUSPENDED EQUIPMENT, SEE RESPECTIVE DETAILS.
D. FOR FLEXIBLE MOUNTED EQUIPMENT USE FOUR THE ABOVE VALUES. SIMULTANEOUS VERTICAL FORCE-USE ONE-THIRD OF THE VALUE OF HORIZONTAL FORCE.

LEGEND

Diagrammatic symbols for LEGEND including: DUCTWORK WITH LINING, FLEXIBLE DUCT, FLEXIBLE CONNECTION (FC), FIRE DAMPER, VOLUME DAMPER, MOTORIZED DAMPER, SMOKE DETECTOR, CONDENSATE DRAIN, HALL LOUVER, ROUND DUCT RISER, RECTANGULAR SUPPLY AIR RISER, CEILING DIFFUSER TYPE / CFM SHOWN, CEILING RETURN / EXHAUST TYPE / CFM SHOWN, RETURN / EXHAUST GRILLE TYPE, TYPE OF EQUIPMENT EQUIPMENT NO., AIR CONDITIONING UNIT, EXHAUST FAN, DETAIL NO. SHEET NO., ROOM THERMOSTAT WITH LOCK-COVER, REMOTE TEMPERATURE SENSOR, INDEXED DIAL CONTROLLER, REFERENCE NOTES, ROUND DUCT, UNDERCUT DOOR (BY GENERAL CONTRACTOR), DOOR LOUVER (BY GENERAL CONTRACTOR)

ABBREVIATIONS:

Table of abbreviations: AFF ABOVE FINISH FLOOR, AH AIR HANDLER, ARCH ARCHITECTURE, AMP AMPERE, BTU BRITISH THERMAL UNIT, BFP BACKFLOW PREVENTER, BOP BULKHEAD OVERHEAD PANEL, CD CEILING DIFFUSER, CR CEILING RETURN, CH CHILLER, COP COEFFICIENT OF PERFORMANCE, CONT CONTINUATION, CFM CUBIC FEET PER MINUTE, DEG DEGREE FAHRENHEIT, DPS DIFFERENTIAL PRESSURE SWITCH, DWS DRAWING, EA ELECTRICAL, ELEC ELECTRICAL, ENT ENTERING AIR TEMPERATURE, ETR ENTERING WATER TEMPERATURE, EFF ENERGY EFFICIENCY RATIO, ES EXHAUST GRILLE, ER EXHAUST REGISTER, ESP EXTERNAL STATIC PRESSURE, EXIST EXISTING, ET EXPANSION TANK, FEET FEET, FLA FULL LOADS AMPS, FPM FEET PER MINUTE, FC FLEXIBLE CONNECTOR, GPM GALLONS PER MINUTE, HB HEATING BOILER, HP HORSE POWER, HR HOUR, HZ HERTZ (FREQUENCY), IN INCHES, LAT LEAVING AIR TEMPERATURE, LWT LEAVING WATER TEMPERATURE, LL LIQUID LINE, LES LINEAR, LIN LINEAR DIFFUSER, LF LINEAR FEET, LRF LIQUID REFRIGERATION, LR LINEAR REFRIGERATION, MAX MAXIMUM, MBH THOUSAND BTU/HR, MCA MINIMUM CIRCUIT AMPACITY, MECH MECHANICAL, MIN MINIMUM, NC NORMALLY CLOSE, NO NORMALLY OPEN, OJA OUTSIDE AIR, PH PHASE, PLUMB PLUMBING, PDP PRESSURE DROP, POUNDS PER SQUARE INCH GAGE, P PUMP, RA RETURN AIR, RGS RETURN GRILLE, RR RETURN REGISTER, RPM REVOLUTION PER MINUTE, STD STANDARD, SOV SHUT-OFF VALVE, SP STATIC PRESSURE, SA SUPPLY AIR, SR SUCTION REFRIGERATION, SUCT SUCTIION LINE, TEMP TEMPERATURE, TP TOTAL PRESSURE, TG TRANSFER GRILLE, TYP TYPICAL, V VOLT, W.G. WATER GAGE

Woff Lang/Christopher Architects, Incorporated
10470 Pechanga Blvd, Murrieta, California CA 92562
(951) 801-0600

Murrieta Valley Unified School District

Thompson Phase 2 Middle School

CONSULTANT
MATHAUDHU ENGINEERING, INC.
CONSULTING MECHANICAL ENGINEERS
3803 BRACKTON AVE., SUITE 8, RIVERSIDE, CA 92501
(951) 506-1776 FAX (951) 506-1081

APPROVED


APPROVED
Professional Engineer Seal: SUKHDEV S. MATHAUDHU, No. 14546, Exp. 06/31/95, STATE OF CALIFORNIA

APPROVED
IDENTIFICATION STAMP
DIV. OF THE STATE ARCHITECT
OFFICE OF REGULATION SERVICES
APPL 1167
AC FLS 11/10 SS JWS
DATE 1/23/94

Table with 3 columns: NO, DATE, BY, REMARKS


GENERAL NOTES LEGEND, SYMBOLS

DRAWN DLB
CHECKED SSM
DATE JAN. 94
SCALE NONE
JOB NO. 9216900

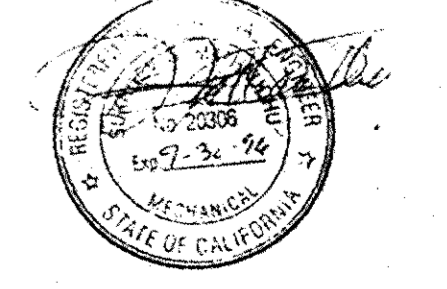

EXHAUST FAN CONTROLS


11

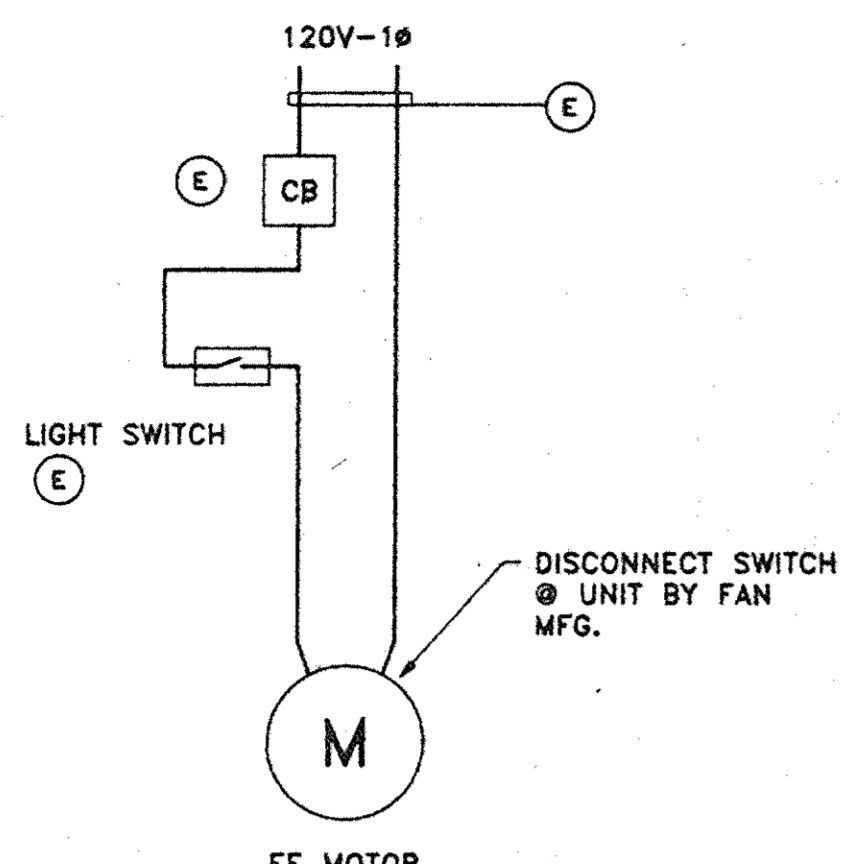

TYPICAL FOR: BUILDING - 'A' = EF-1 AND EF-4
 BUILDING - 'B' = EF-5 AND EF-6
 BUILDING - 'C' = EF-3 AND EF-4
 BUILDING - 'D' = EF-1, EF-2, EF-3
 EF-5, EF-6, AND EF-8
 BUILDING - 'E' = EF-3 AND EF-4

EXHAUST FAN CONTROLS


9

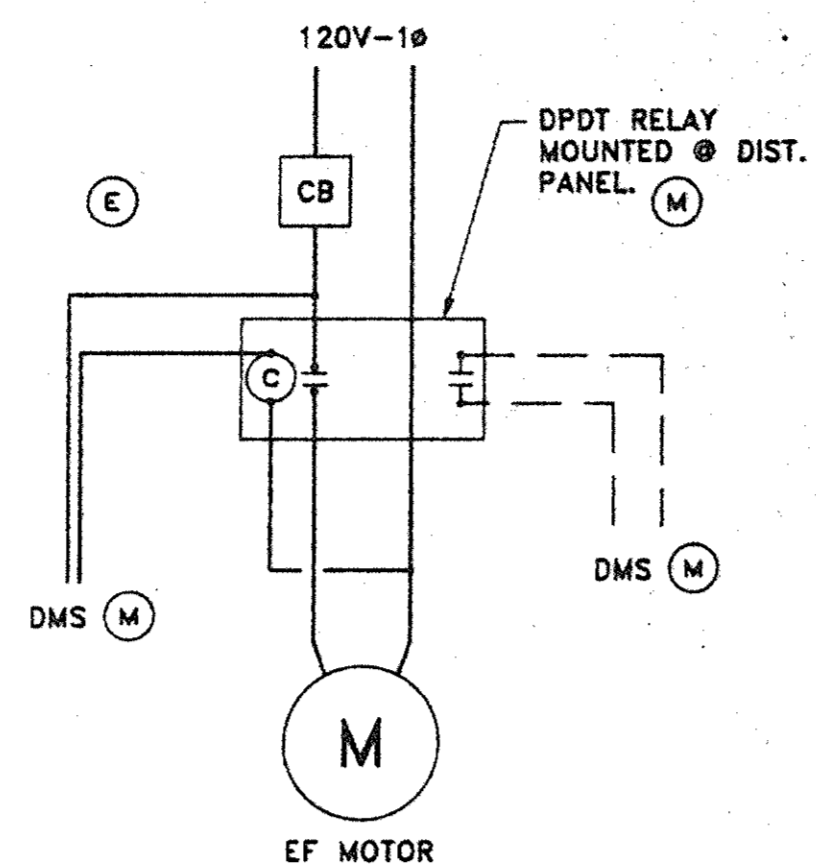

TYPICAL FOR: BUILDING - 'A' = EF-2 AND EF-3
 BUILDING - 'B' = EF-1, EF-2, EF-3
 AND EF-4
 BUILDING - 'C' = EF-1 AND EF-2
 BUILDING - 'D' = EF-4 AND EF-7
 BUILDING - 'E' = EF-1 AND EF-2


EMS - ARCHITECTURE FOR BUILDINGS 'A', 'B', AND 'C'

5

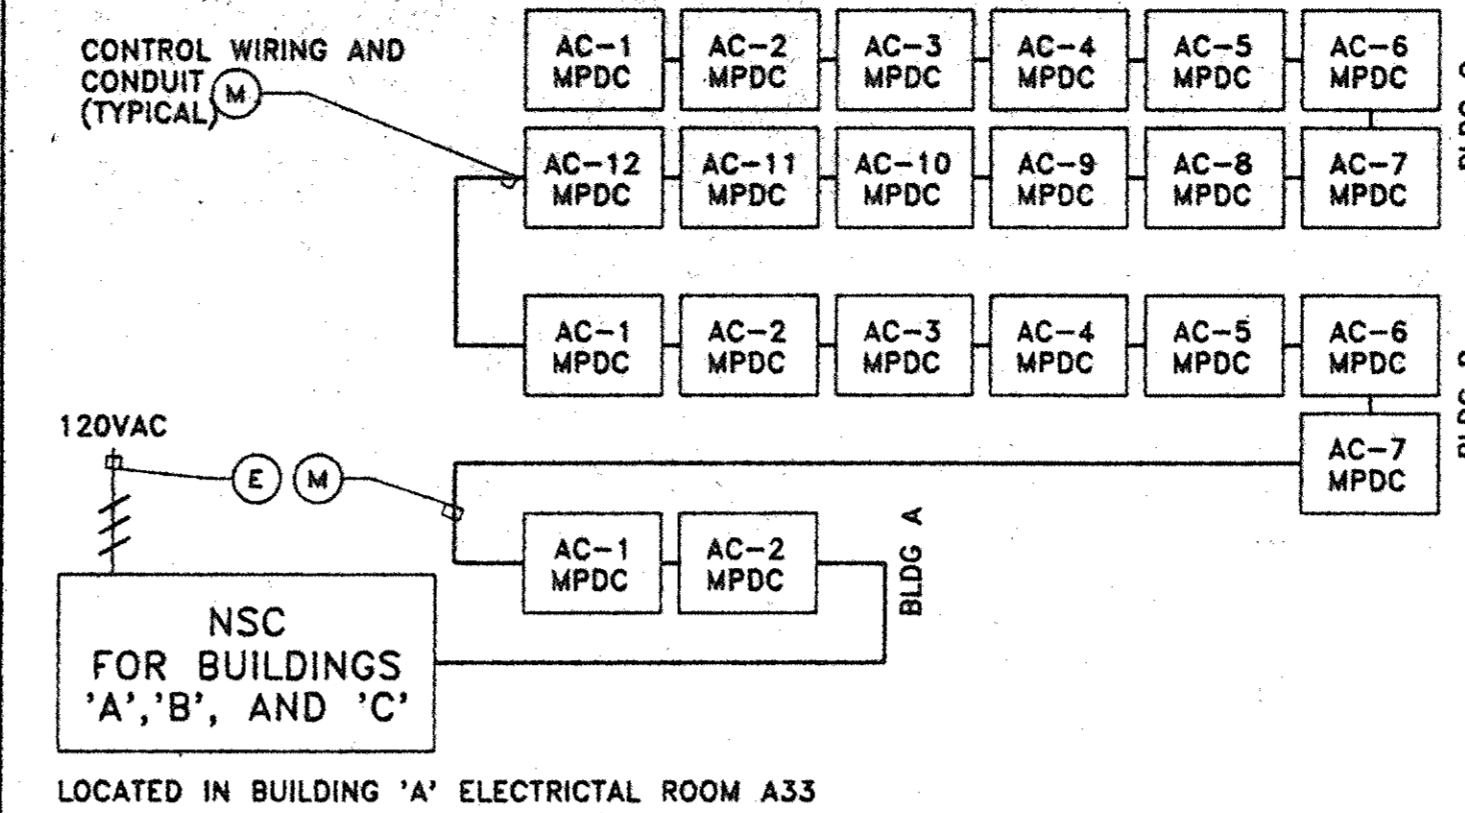

EMS - ARCHITECTURE FOR BUILDINGS 'D' AND 'E'

6

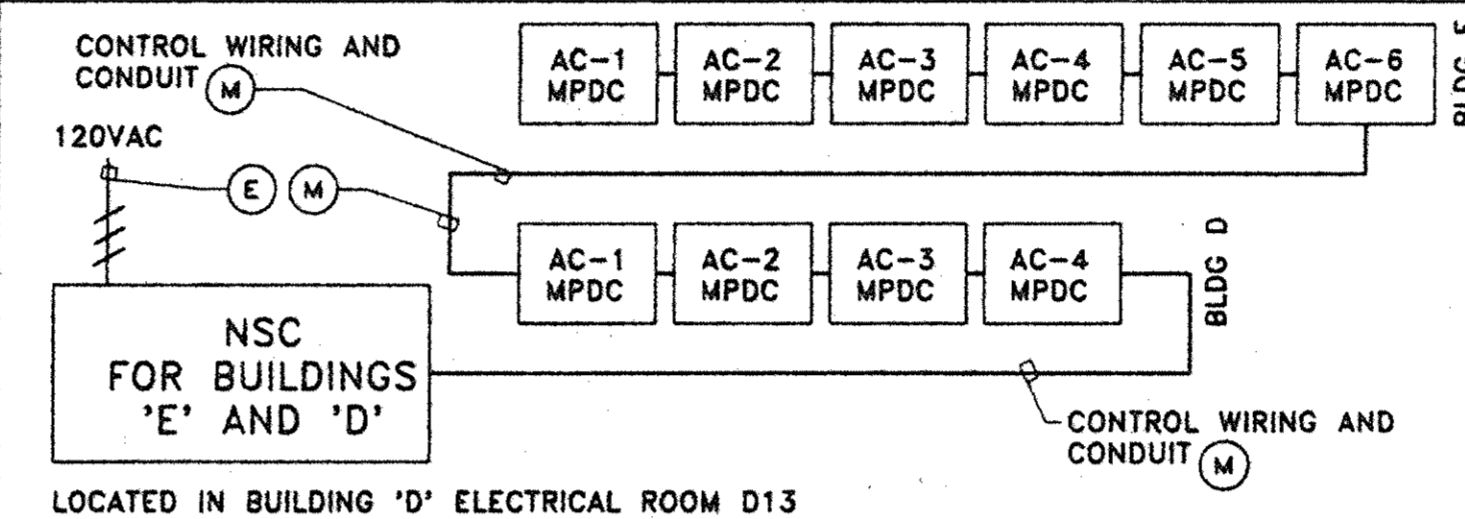


LEGEND

1

- ESM ENERGY MANAGEMENT SYSTEM
- MPDC MICRO PROCESSOR DIGITAL CONTROLLER
- CB CIRCUIT BREAKER
- DS DISCONNECT SWITCH
- (M) MECHANICAL
- (E) ELECTRICAL

EMS-ARCHITECTURE INTER-CONNECTION

2

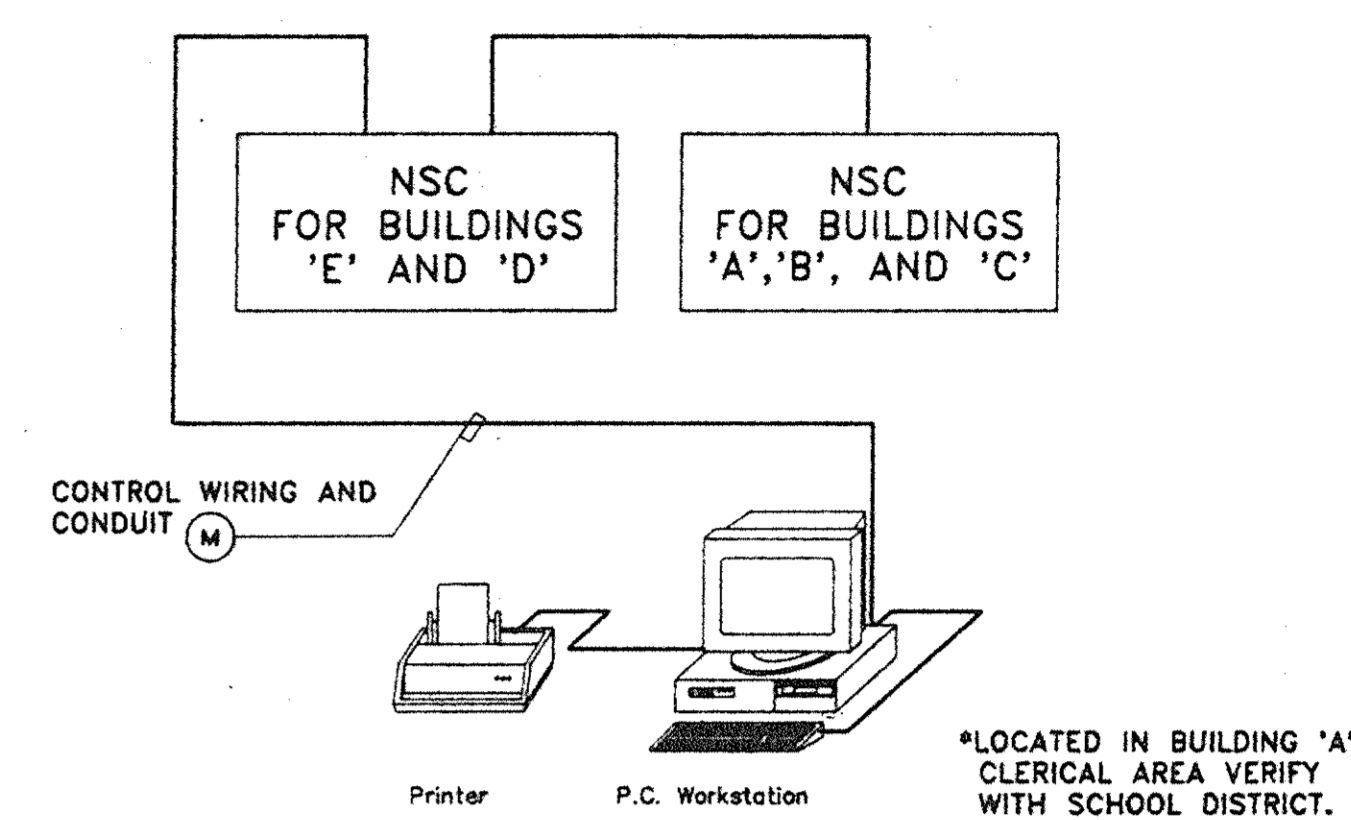

AUTOMATIC SHUT-OFF


12

SEQUENCE OF OPERATIONS
 THE SMOKE DETECTORS LOCATED IN SUPPLY AND RETURN AIR DUCT OF AC UNITS SHALL DEACTIVATE THE SUPPLY FAN AND EXHAUST FANS (IF SPECIFIED) UPON SMOKE DETECTION AND SHALL ACTIVATE THE FIRE ALARM SYSTEM FER CMC 1009.

- BUILDING - 'A': AC-1 AND AC-2
- BUILDING - 'B': AC-1, AC-2, AC-4 AC-6 AND AC-7
- BUILDING - 'C': AC-1, AC-2, AC-10 AC-11 AND AC-12
- BUILDING - 'D': AC-1, AC-2, AC-3 AND AC-4
- BUILDING - 'E': AC-1 AND AC-2


NOTES:

- 1.- ELECTRICAL TO PROVIDE SMOKE DETECTOR AND 115V-1Ø POWER TO EA. SMOKE DETECTOR, CONNECT ALL SMOKE DETECTOR TO FIRE ALARM PANEL.
- 2.- MECHANICAL TO PROVIDE INTERLOCKING FROM SMOKE DETECTOR TO UNITS EMS PANEL FOR SUPPLY AND EXHAUST FAN SHUT DOWN.

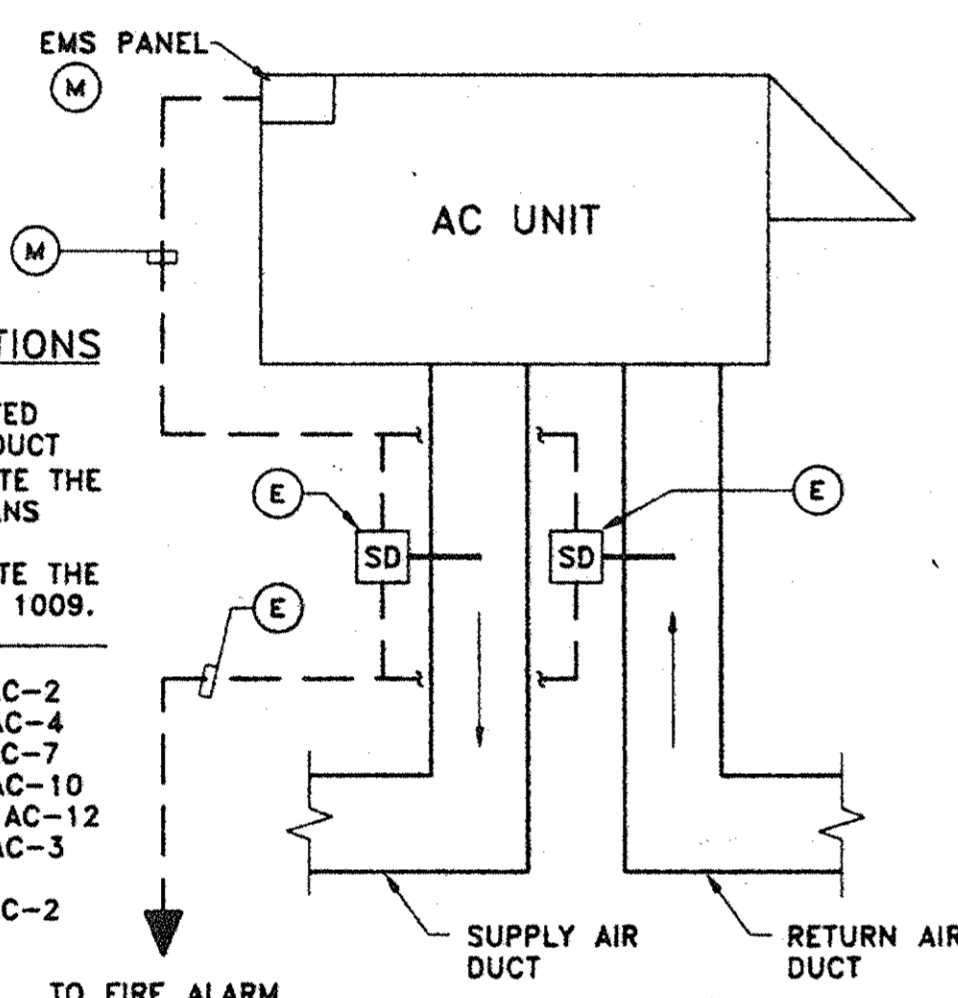


TYPICAL A/C UNIT CONTROL DIAGRAM

10

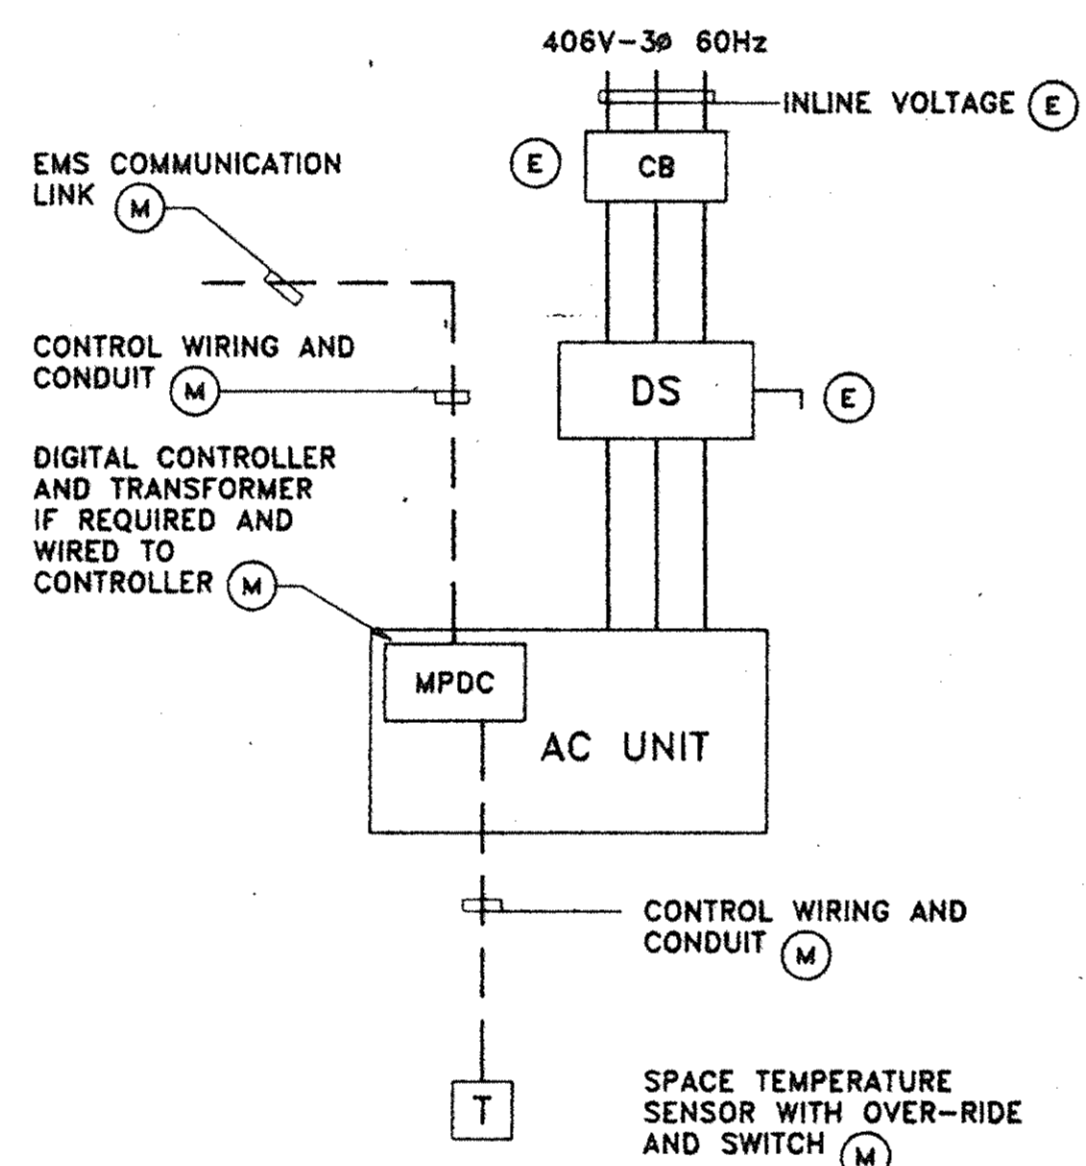

EXHAUST FAN CONTROLS


7

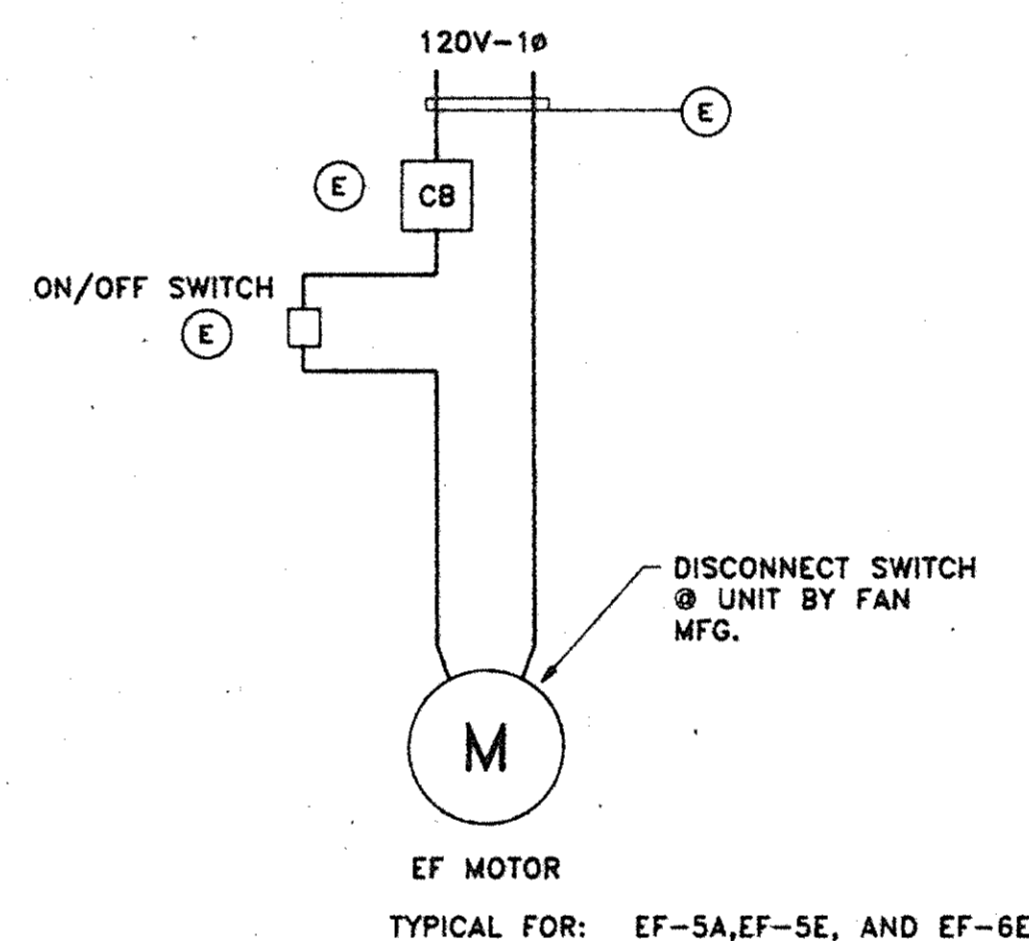

TYPICAL FOR: EF-5A, EF-5E, AND EF-6E

EXHAUST FAN CONTROL

3

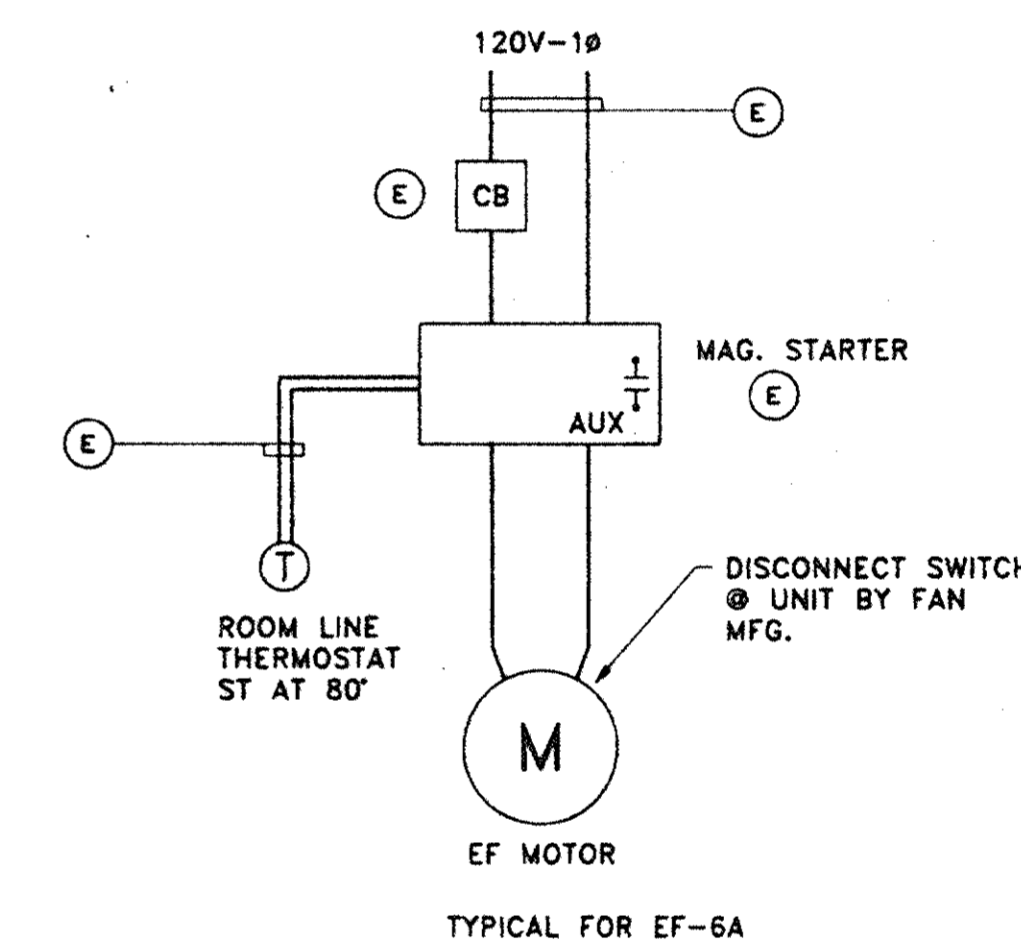

TYPICAL FOR EF-6A



POINTS DESCRIPTION

8

SYSTEM APPARATUS OR POINT DESCRIPTION	ANALOG OUTPUT		ANALOG INPUT		CONTACT OUTPUT		CONTACT INPUT		ALARMS		DMS FUNCTIONS	
	4-20mA	0-5VDC	TEMPERATURE	PRESSURE	TEMPERATURE	CURRENT (AMPS)	STATUS	ALARM	CHRONICAL	MANUAL	START/STOP	TEMP CONTROL
1 BUILDING - 'A'												
2 AC NO. 1												
3 SUPPLY AIR TEMP			X							X	X	X
4 SPACE TEMP			X							X	X	X
5 DIRTY FILTER												X
6 HEATING CONTROL												X
7 COOLING CONTROL												X
8 CO ₂ SENSOR						X						X
9 SMOKE DETECTOR (SEE DETAIL 11)										X		X
10 (SEE DETAIL 11)												
11 EXHAUST FAN NO. (SEE DETAIL 9)											X	
12												
13												
KITCHEN MUA/EF WIRING DIAGRAM

4

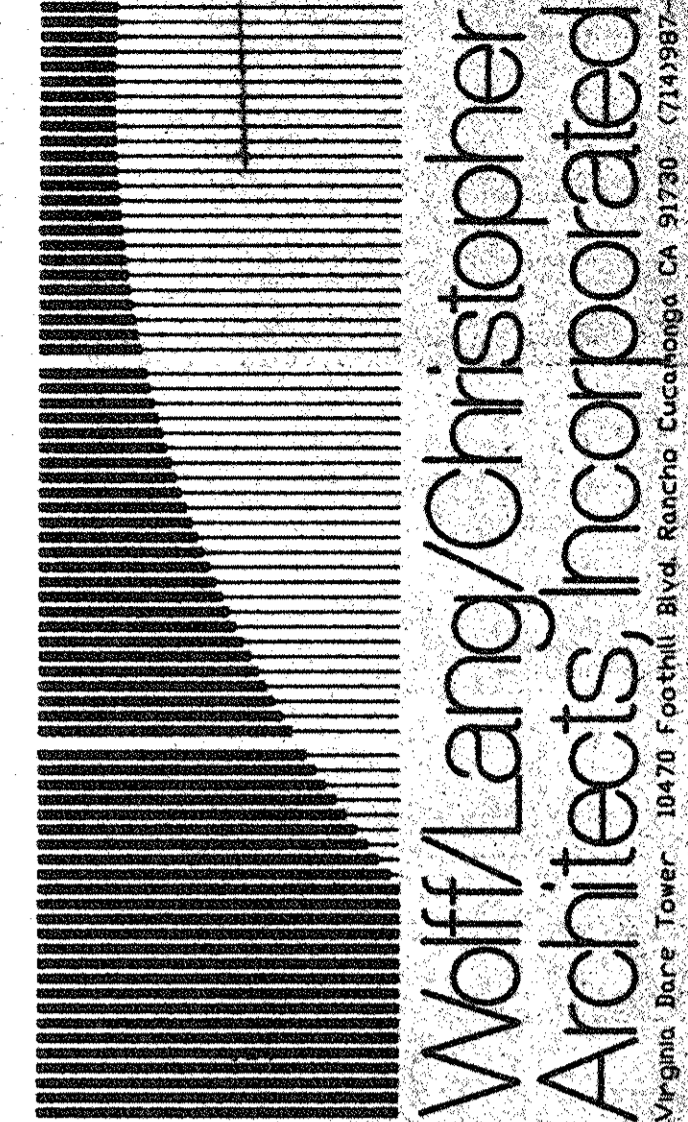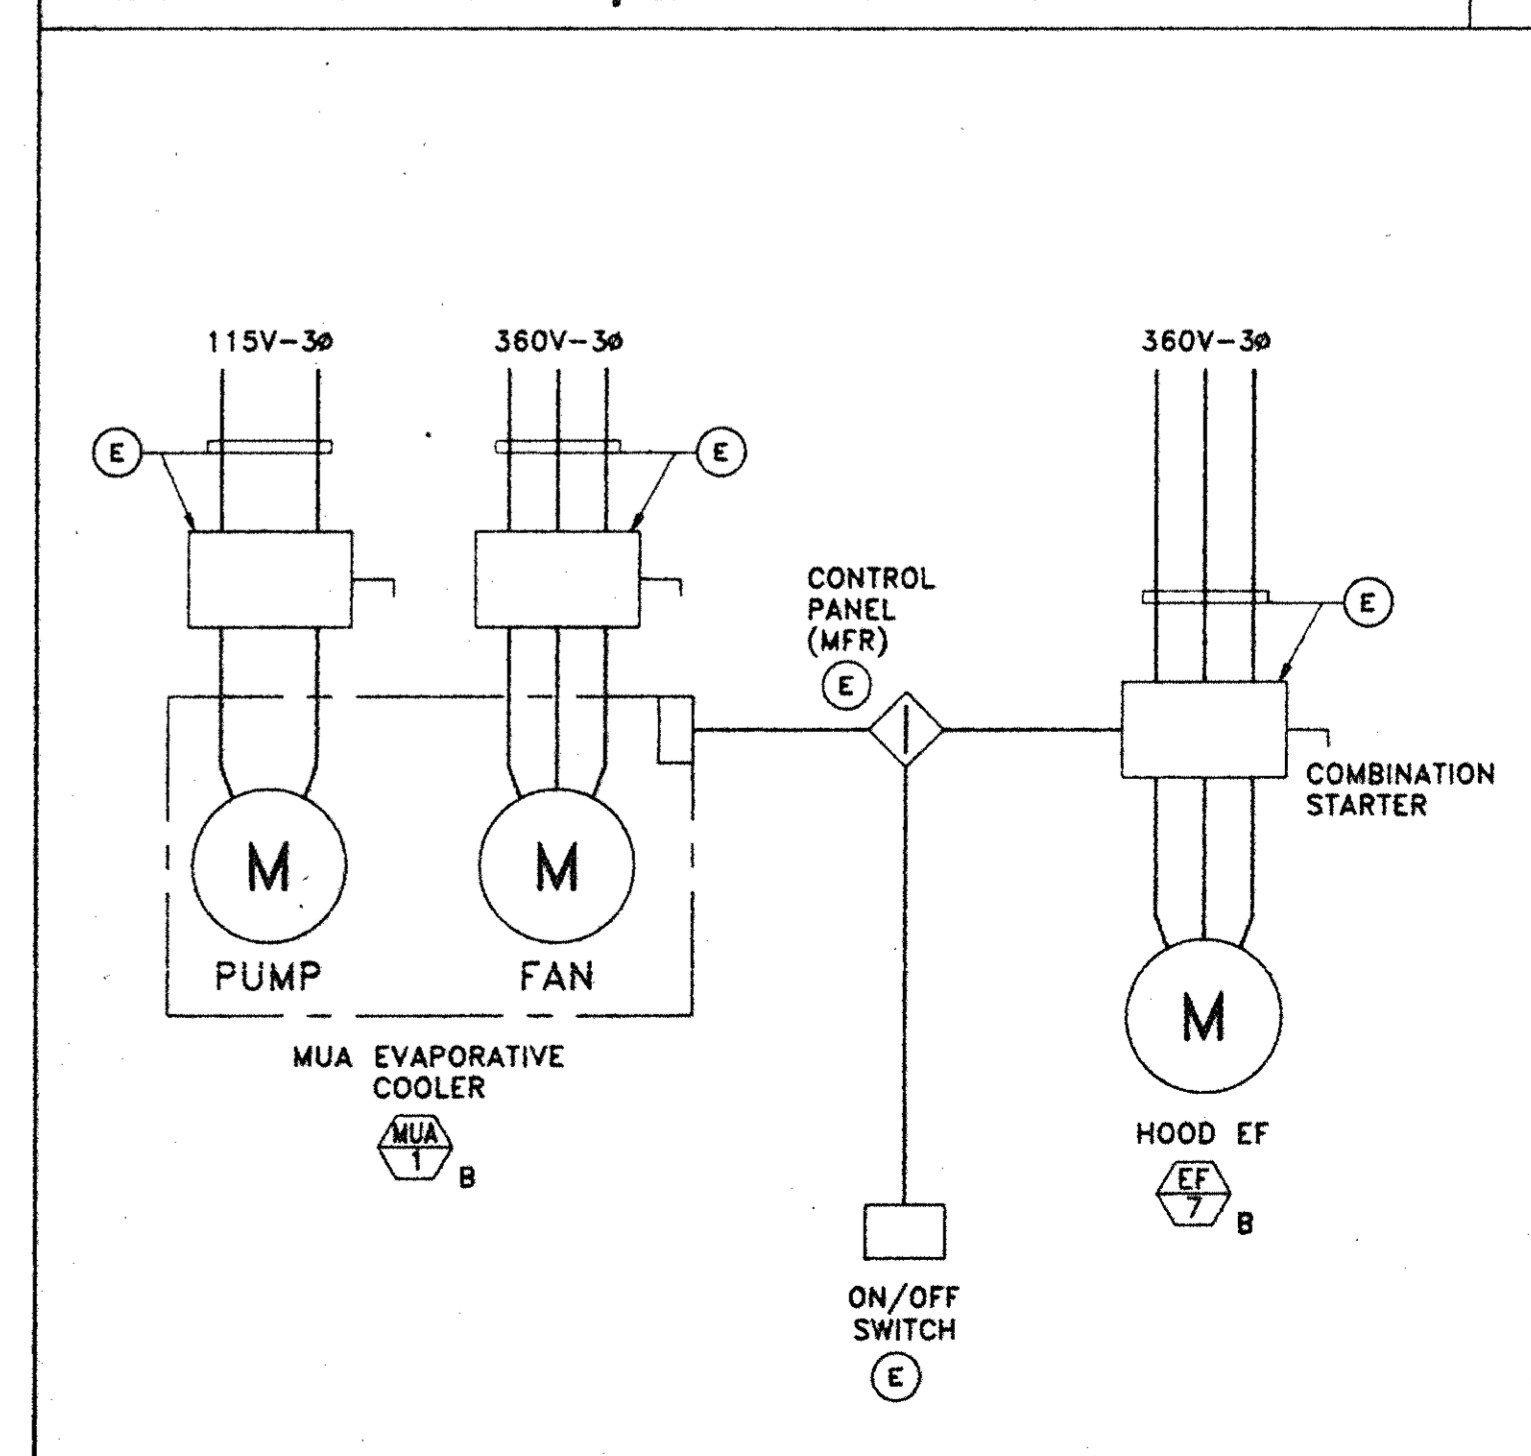

Murrieta Valley Unified School District
 Thompson Phase 2 Middle School

CONSULTANT
MATHAUDHU ENGINEERING, INC.
 CONSULTING ENGINEERS
 3803 BROOKTON AVE., SUITE 5, RIVERSIDE, CA 92501
 (714) 886-1728 FAX (714) 886-5081

APPROVED
 RELEASED ARCHITECT
 MATHAUDHU ENGINEERING, INC.
 C-14546
 M.M. 02/19/99

APPROVED
 DELEGATION STAMP
 DIV. OF THE STATE ARCHITECT
 OFFICE OF REGULATION SERVICES
 APPR. 6/16/97
 DATE 6/16/97

APPROVED

NO	DATE	BY	REMARKS

MECHANICAL CONTROL DIAGRAM and WIRING DIAGRAM

DRAWN DLB
 CHECKED SSM
 DATE 1/14/99
 SCALE NONE
 JOB NO. 9216100

M0.3



Murrieta Valley Unified School District

Thompson Phase 2 Middle School

CONSULTANT
MATHAUDHU ENGINEERING
CONSULTING ENGINEERS (714) 606-1178
3003 BROOKTON AVE., SUITE 5, RIVERSIDE, CA 92501

APPROVED

APPROVED
MATHAUDHU ENGINEERING
CONSULTING ENGINEERS
STATE OF CALIFORNIA


APPROVED
IDENTIFICATION NUMBER
OFFICE OF REGULATION SERVICES
APPL 6167
AC RLS/20 SSZ
DATE 01/28/94

NO	DATE	BY	REMARKS


DETAILS

DRAWN BS
CHECKED BS
DATE JAN. 94
SCALE NONE
JOB NO. 926640


REVISIONS
DATE 01-31-94
BY BS

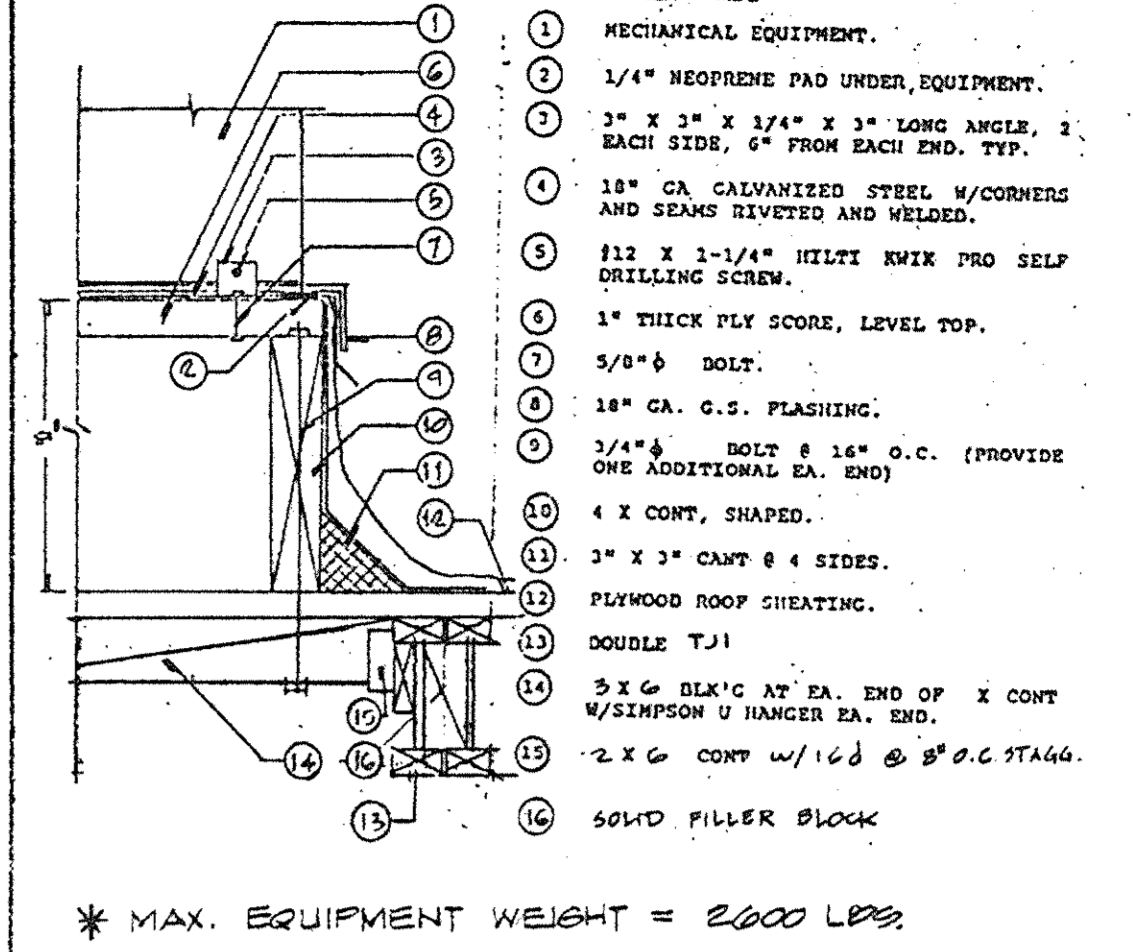


EQUIPMENT PLATFORM ① SCALE NONE

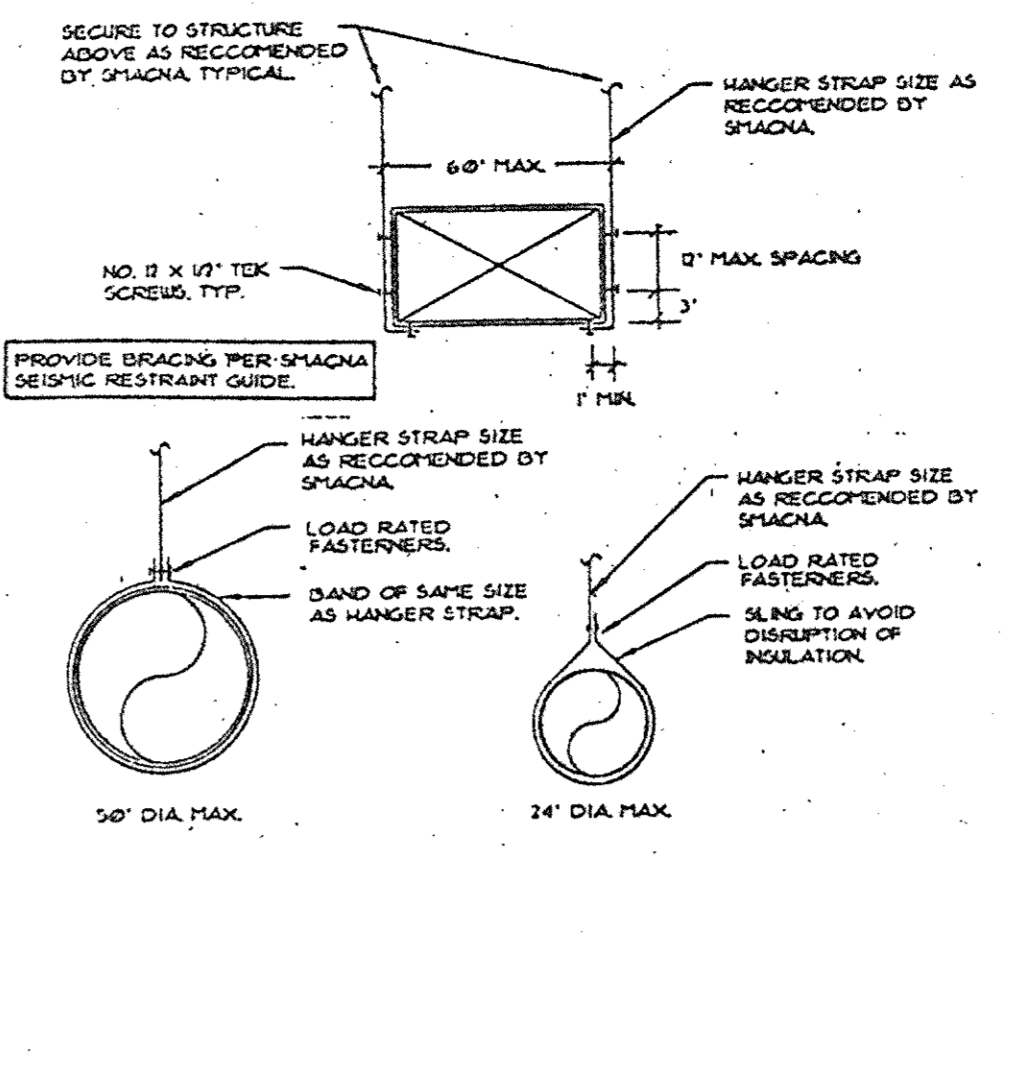


DUCT SUPPORT ④ SCALE NONE

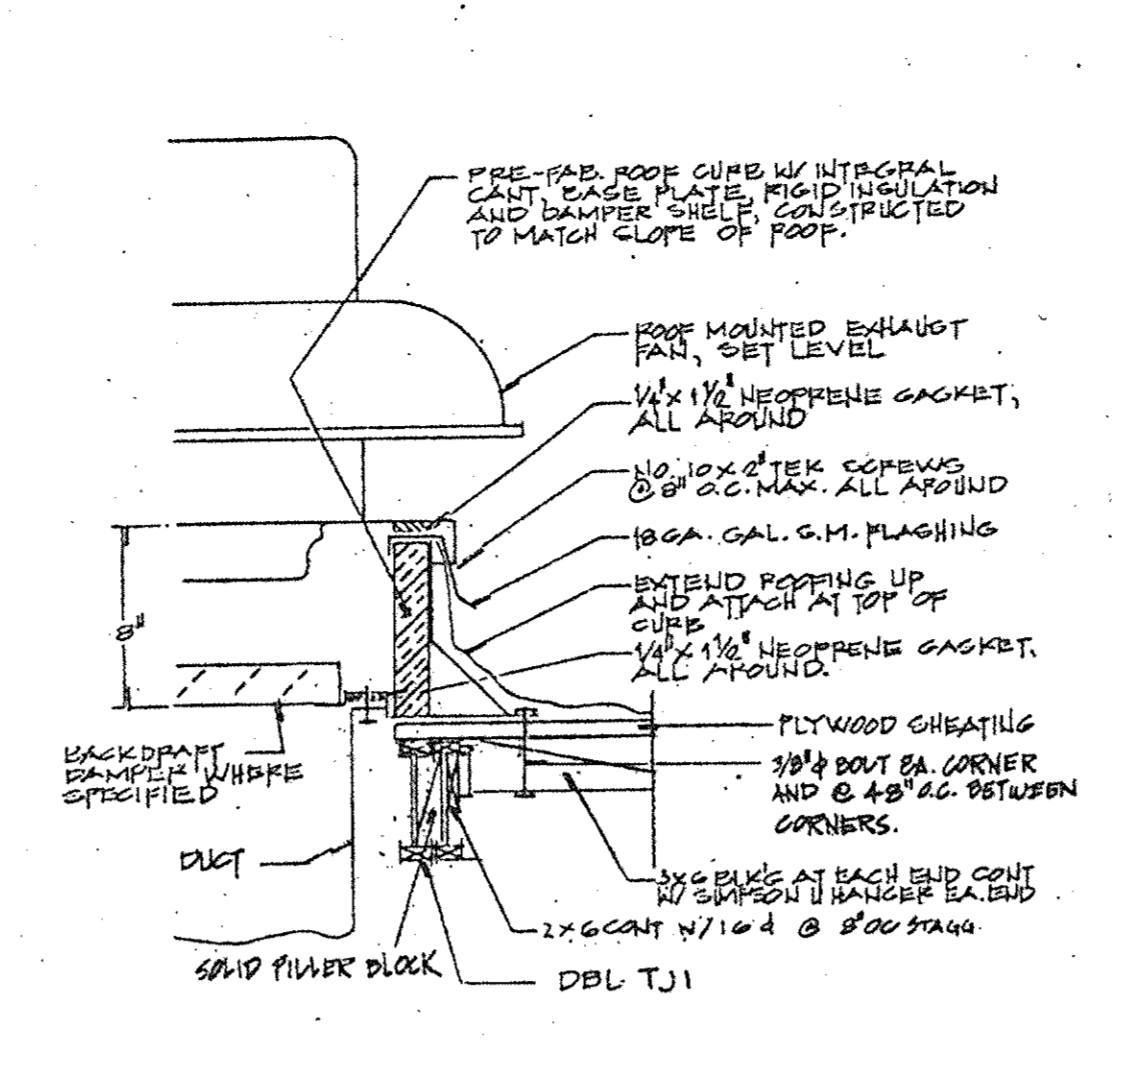


ROOF EXHAUSTER INSTALLATION ⑥ SCALE NONE

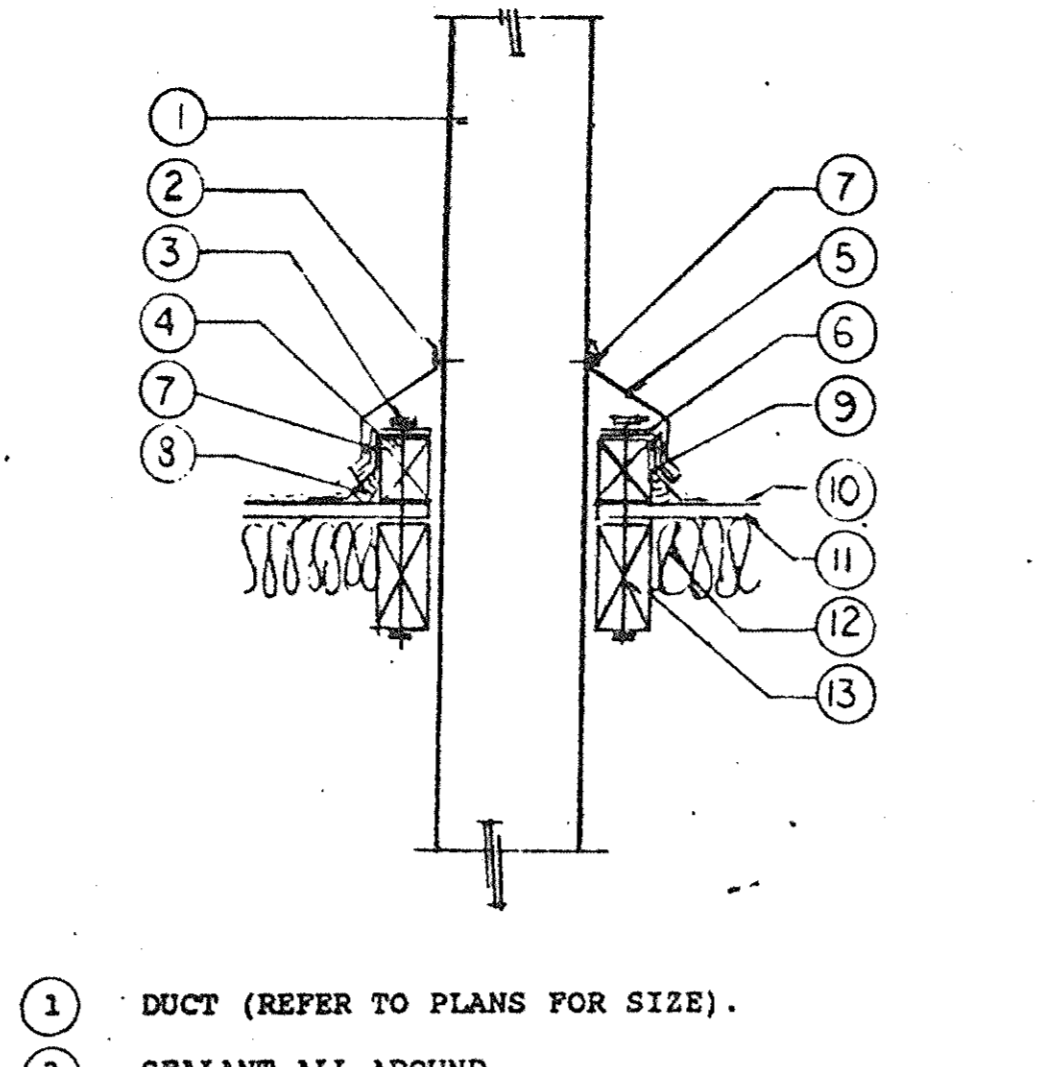


DUCT THRU ROOF ⑨ SCALE NONE

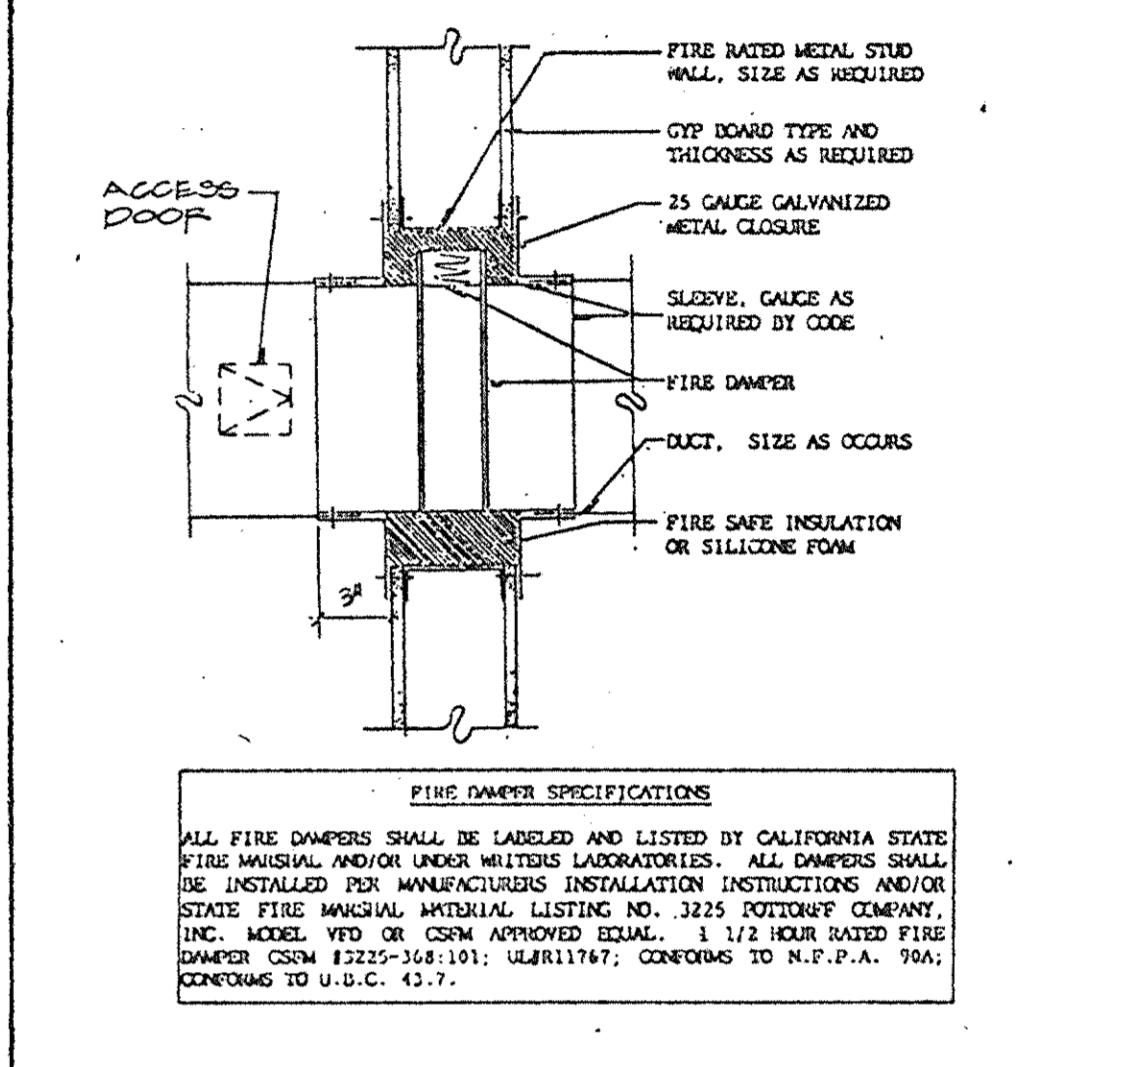

FIRE DAMPER @ RATED WALL ② SCALE NONE

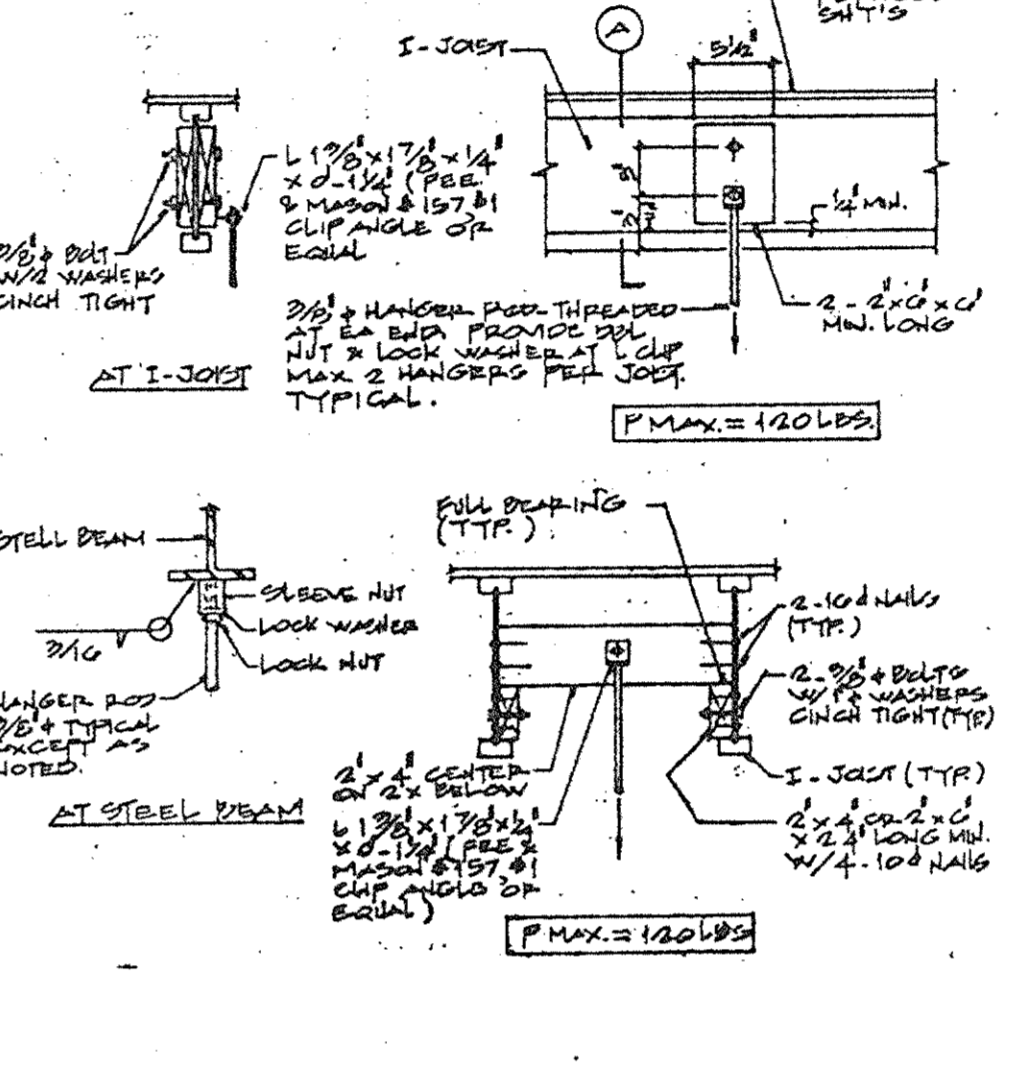

EQUIPMENT SUPPORT @ ROOF FRAMING ⑤ SCALE NONE

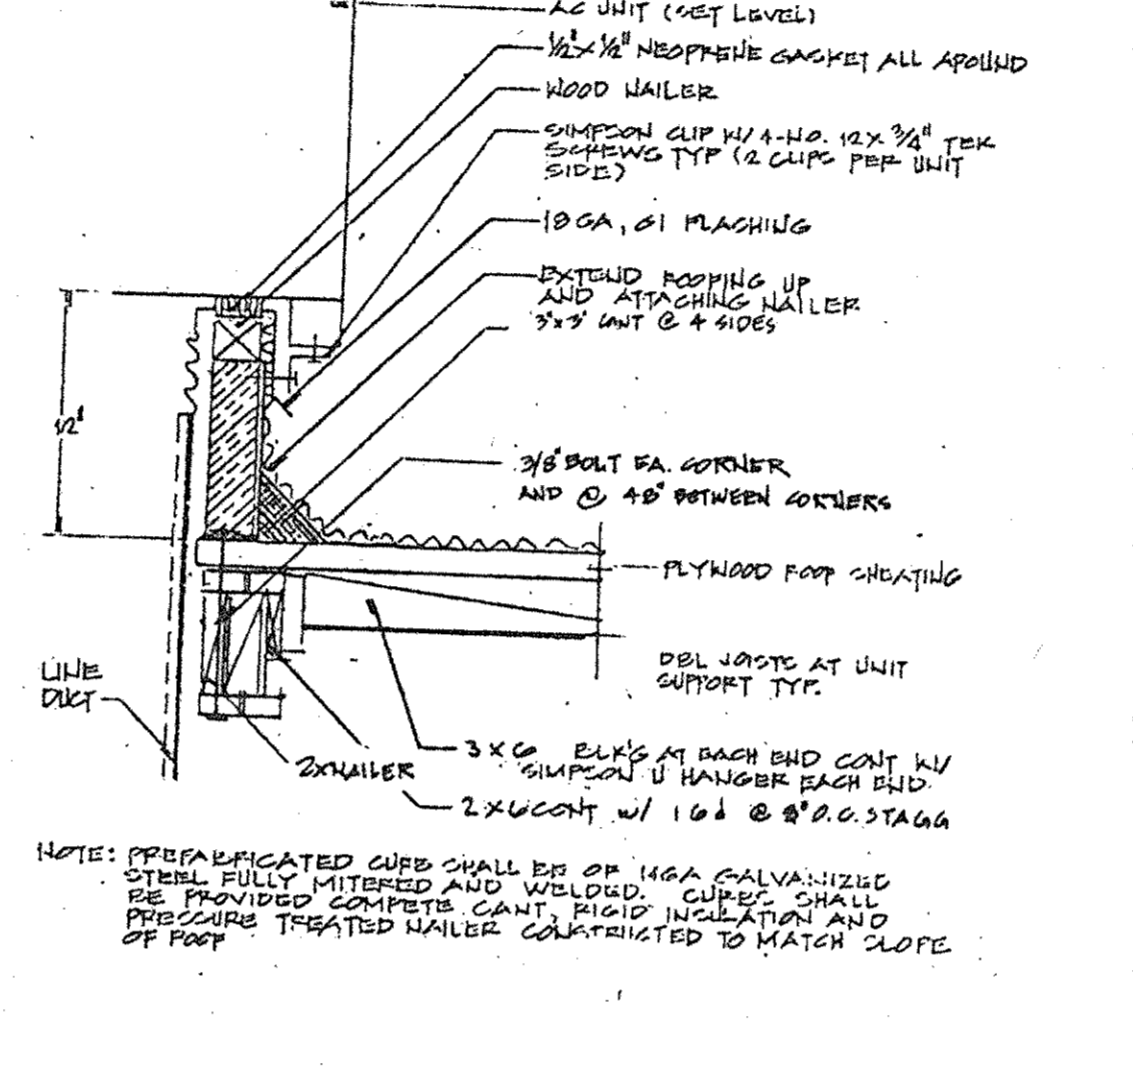


EQUIPMENT ROOF CURB ⑦ SCALE NONE

Table 1 Properties

Property	SUPER FIRETEMP 30	SUPER FIRETEMP 120
Board size (ft. x ft. x in.)	4' x 8'	4' x 8'
Thickness (in.)	1 1/2"	1 1/2"
Density, pcf	130	130
Compressive strength, psi	100	100
Tensile strength, psi	100	100
Screening strength, psi	100	100
Dielectric strength, kV/inch	30	30
Linear shrinkage, %	30	30
Two-hour heat soak @ 1800°F	1800	1800
Maximum continuous service temperature, °F	1800	1800
UL Value per inch	1 1/2"	1 1/2"
Thermal Conductivity, BTU-in./hr. °F	0.15	0.15
Mean temperature, °F	41	41
UL Value per inch	1 1/2"	1 1/2"
UL Value per inch	1 1/2"	1 1/2"
UL Value per inch	1 1/2"	1 1/2"

Table 2 SPECIFICATION QUALIFICATIONS

Specification	Qualification
ASTM E 272	Passes 0 Flame
E 644	1, 2, 3, 4 Hours
E 119	Passes
E 136	Passes
E 814	Passes
C 795	Passes
UL 763	1, 2, 3, 4 Hours
UL 767	1, 2, 3, 4 Hours
UL 768	1, 2, 3, 4 Hours
ULC 300	15" min. thickness
U.S. Coast Guard 164.003, 164.008	15" min. thickness
Underwriters Laboratories, Inc. Design Numbers	UL 218 UL 444
UL Canada Design Numbers	W-42 W-41
American Nuclear Insurers	ANNULIFIP
Farmers Home Administration	Approved
Mine Safety and Health Administration	Approved
VTEC Laboratories (Exit Report)	100-201

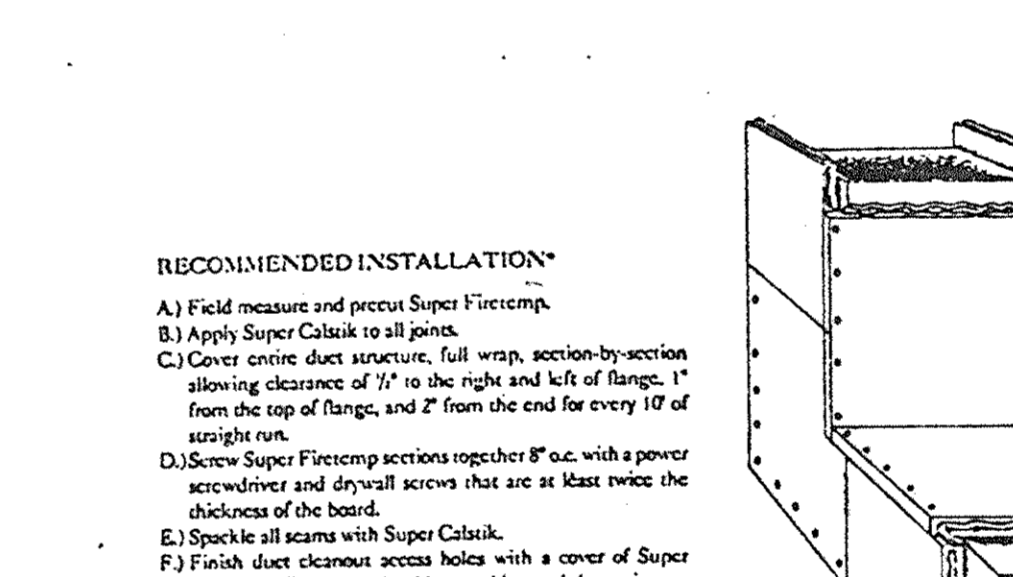

RECOMMENDED INSTALLATION*

- Field measure and pre-cut Super Firetemp.
- Apply Super Calcium to all joints.
- Cover entire duct structure, full wrap section by section allowing clearance of 1/2" to the right and left of flange, 1" from the top of flange, and 2" from the end for every 1/2" of wrap-around.
- Use Super Firetemp sections together 8" x 24" with a power screwdriver and drill screws that act as their own the thickness of the board.
- Splice all seams with Super Calcium.
- Finish duct exterior access holes with a cover of Super Firetemp. The cover should extend beyond the perimeter of the hole by at least 1". The cover is removed in place using removable striping 1/2" x 2" x 2" minimum 2 steps.

*This application is based on a typical fire hood design. Types and sizes of duct may vary. Consult fabricator for specific application files.


FOR ADDITIONAL INFORMATION CONTACT:

A. WILLIAM Mc CARTHY
DISTRICT SALES MANAGER
FIRETEMP PRODUCTS

PABCO
INSULATION-FIREPROOFING-METALS

(414) 723 2115

CALIFORNIA STATE FIRE MARSHAL
LISTING NO 2280-1357:100

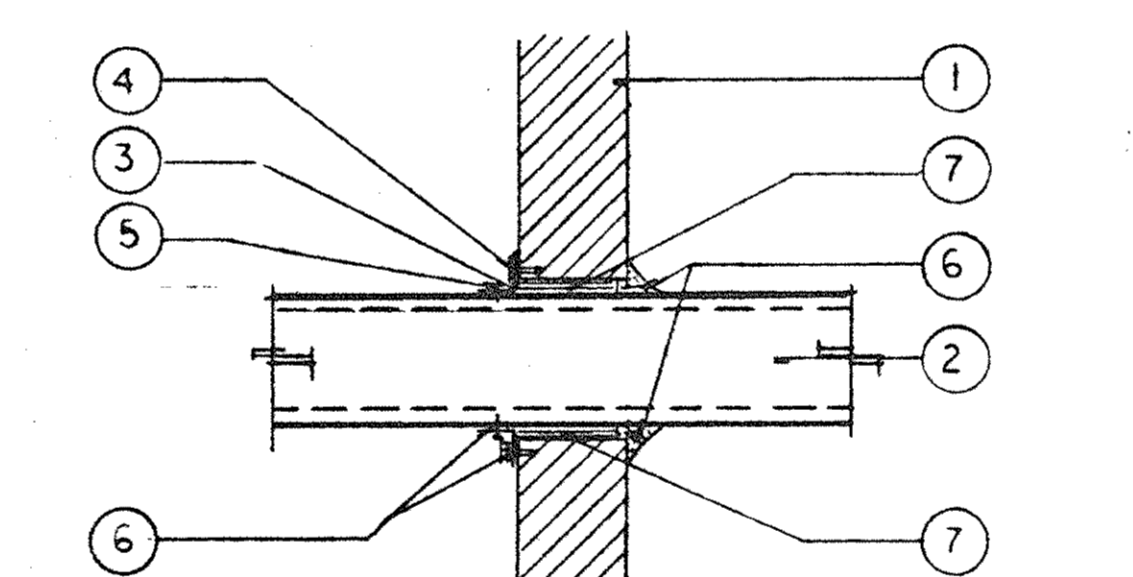


DUCT THRU WALL ⑧ SCALE NONE

DUCT THRU WALL ⑧ SCALE NONE

DUCT THRU ROOF ⑨ SCALE NONE

DUCT THRU WALL ⑧ SCALE NONE

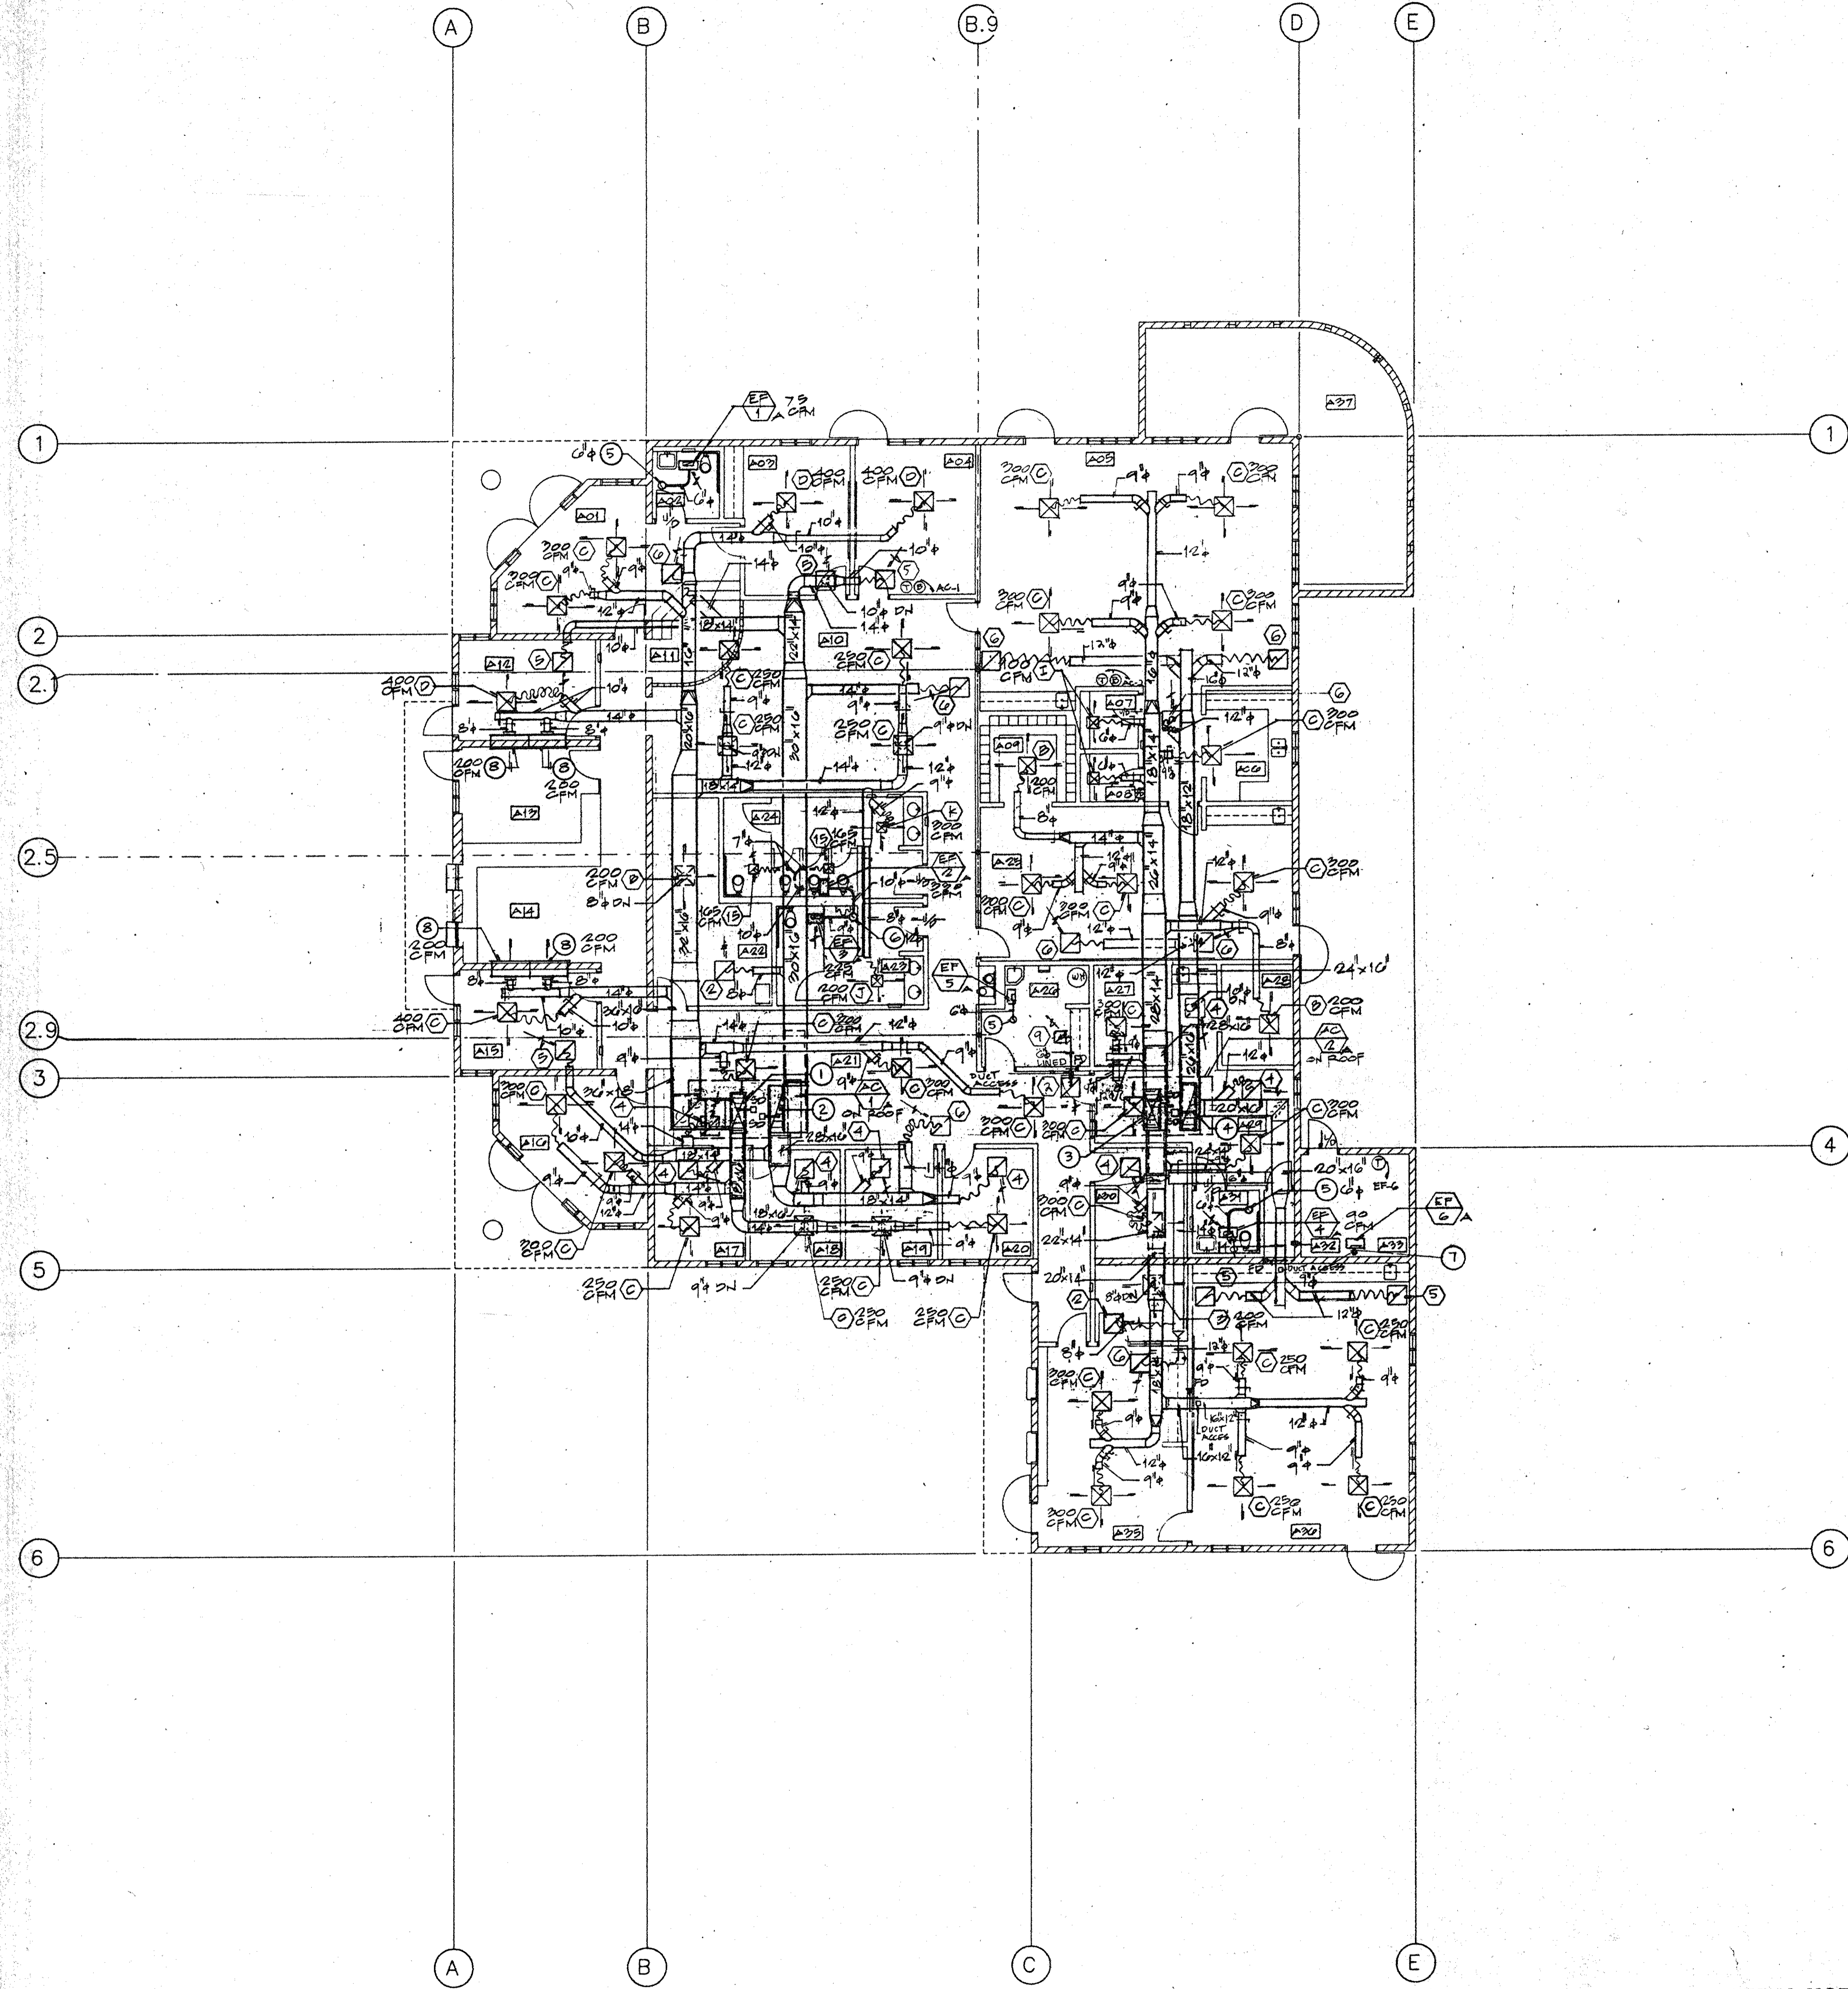

ROOM NAMES

- A01 PUBLIC LOBBY
- A02 TOILET
- A03 CONFERENCE ROOM
- A04 PRINCIPAL'S OFFICE
- A05 STAFF LOUNGE
- A06 KITCHENETTE
- A07 PHONE ROOM
- A08 PHONE ROOM
- A09 MAIL ROOM
- A10 CLERICAL AREA
- A11 REGISTRATION CUBICLE
- A12 ASSISTANT PRINCIPAL'S OFFICE
- A13 DISCIPLINE LOBBY
- A14 ATTENDANCE OFFICE
- A15 ASSISTANT PRINCIPAL'S OFFICE
- A16 STUDENT LOBBY
- A17 COUNSELOR'S OFFICE
- A18 COUNSELOR'S OFFICE
- A19 COUNSELOR'S OFFICE
- A20 DESIGNATED INSTRUCTIONAL SERVICES OFFICE
- A21 CLERICAL AREA
- A22 STUDENT RECORDS ROOM
- A23 MEN'S RESTROOM
- A24 WOMEN'S RESTROOM
- A25 STAFF WORKROOM
- A26 STORAGE
- A27 COT ROOM
- A28 COT ROOM
- A29 NURSE'S OFFICE
- A30 THERAPIST'S OFFICE
- A31 TOILET
- A32 CLOSET
- A33 ELECTRICAL ROOM
- A34 ACTIVITIES DIRECTOR'S OFFICE
- A35 STUDENT STORE
- A36 STUDENT LEADERSHIP ROOM
- A37 PATIO


REFERENCE NOTES

- ① 60" X 20" LINED SUPPLY AIR DUCT UP TO UNIT ON ROOF. PROVIDE TRANSITIONS AS REQUIRED AND CONNECT TO UNIT WITH FLEXIBLE CONNECTOR.
- ② 60" X 20" LINED RETURN AIR DUCT UP TO UNIT ON ROOF. PROVIDE TRANSITIONS AS REQUIRED AND CONNECT TO UNIT WITH FLEXIBLE CONNECTOR.
- ③ 60" X 18" LINED SUPPLY AIR DUCT UP TO UNIT ON ROOF. PROVIDE TRANSITIONS AS REQUIRED AND CONNECT TO UNIT WITH FLEXIBLE CONNECTOR.
- ④ 60" X 18" LINED RETURN AIR DUCT UP TO UNIT ON ROOF. PROVIDE TRANSITIONS AS REQUIRED AND CONNECT TO UNIT WITH FLEXIBLE CONNECTOR.
- ⑤ 6" Ø EXHAUST DUCT UP THRU ROOF AND CONNECT TO ROOF JACK. PROVIDE TRANSITION AS REQUIRED AND CONNECT TO EXHAUST FAN WITH FLEXIBLE CONNECTOR.
- ⑥ 12" Ø EXHAUST RISER DUCT UP THRU ROOF AND CONNECT TO ROOF JACK. DUCT BRANCHES CONNECTED TO RISER SHALL NOT BE IN THE SAME PLANE.
- ⑦ 9" Ø EXHAUST DUCT UP THRU ROOF AND CONNECT TO ROOF JACK. PROVIDE TRANSITION AS REQUIRED AND CONNECT TO EXHAUST FAN WITH FLEXIBLE CONNECTOR.
- ⑧ SIDEWALL ADJUSTABLE LINEAR SLOT DIFFUSERS. DIFFUSERS SHALL MEET ALL THE FOLLOWING CHARACTERISTICS: SURFACE MOUNT, NUMBER OF SLOTS = 2 WITH 1/2" SLOT, LENGTH = 4' (EA.), AIR FLOW = 50 CFM/FT., NC-30 AND COMPLETE WITH INSULATED BOOT PLENUM. DIFFUSER SHALL BE METAL AIR SERIES 6000 WITH BPI INSULATED BOOT PLENUM.

GENERAL NOTES

- 1. ALL TRANSFER DUCTS SHALL BE LINED WITH 1'-0" DUCT LINER INSULATION.
- 2. ALL EXTERIOR DOOR LOUVERS SHALL BE PROVIDED WITH SCREEN. SEE ARCHITECTURAL DRAWINGS.
- 3. ALL EXTERIOR DUCTWORK SHALL BE WEATHERPROOF AND SEALED TO FORM A POSITIVE AIR AND WATERTIGHT SEAL.

NORTH

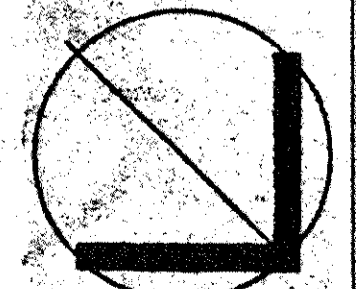


1/8" = 1'-0"

BUILDING 'A' FLOOR PLAN


Wolff/Lang/Christopher
 Architects, Incorporated
 Virginia Dale Tower 10770 Franklin Blvd. Rancho Cucamonga, CA 91730 (714)987-6900

Murrieta Valley Unified School District

Thompson Middle School
 Phase 2

CONSULTANT

MATHAUDHU ENGINEERING, INC.
 CONSULTING MECHANICAL ENGINEERS
 2803 BROOKTON AVE. SUITE A, RIVERSIDE, CA 92501
 (951) 688-1778 FAX (951) 688-0061

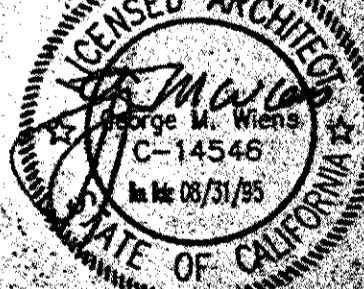APPROVED

APPROVED

 STATE OF CALIFORNIA

APPROVED
 IDENTIFICATION STAMP
 DIV. OF THE STATE ARCHITECTS
 OFFICE OF REGULATION SERVICES
 APPL. 6/1/97
 AC: FLS/B
 DATE: 6/1/97


NO	DATE	BY	REMARKS

BUILDING 'A' MECHANICAL FLOOR PLAN

DRAWN CC/BTS
 CHECKED SSM
 DATE JAN, 94
 SCALE AS NOTED
 JOB NO. 9210400

M1.A



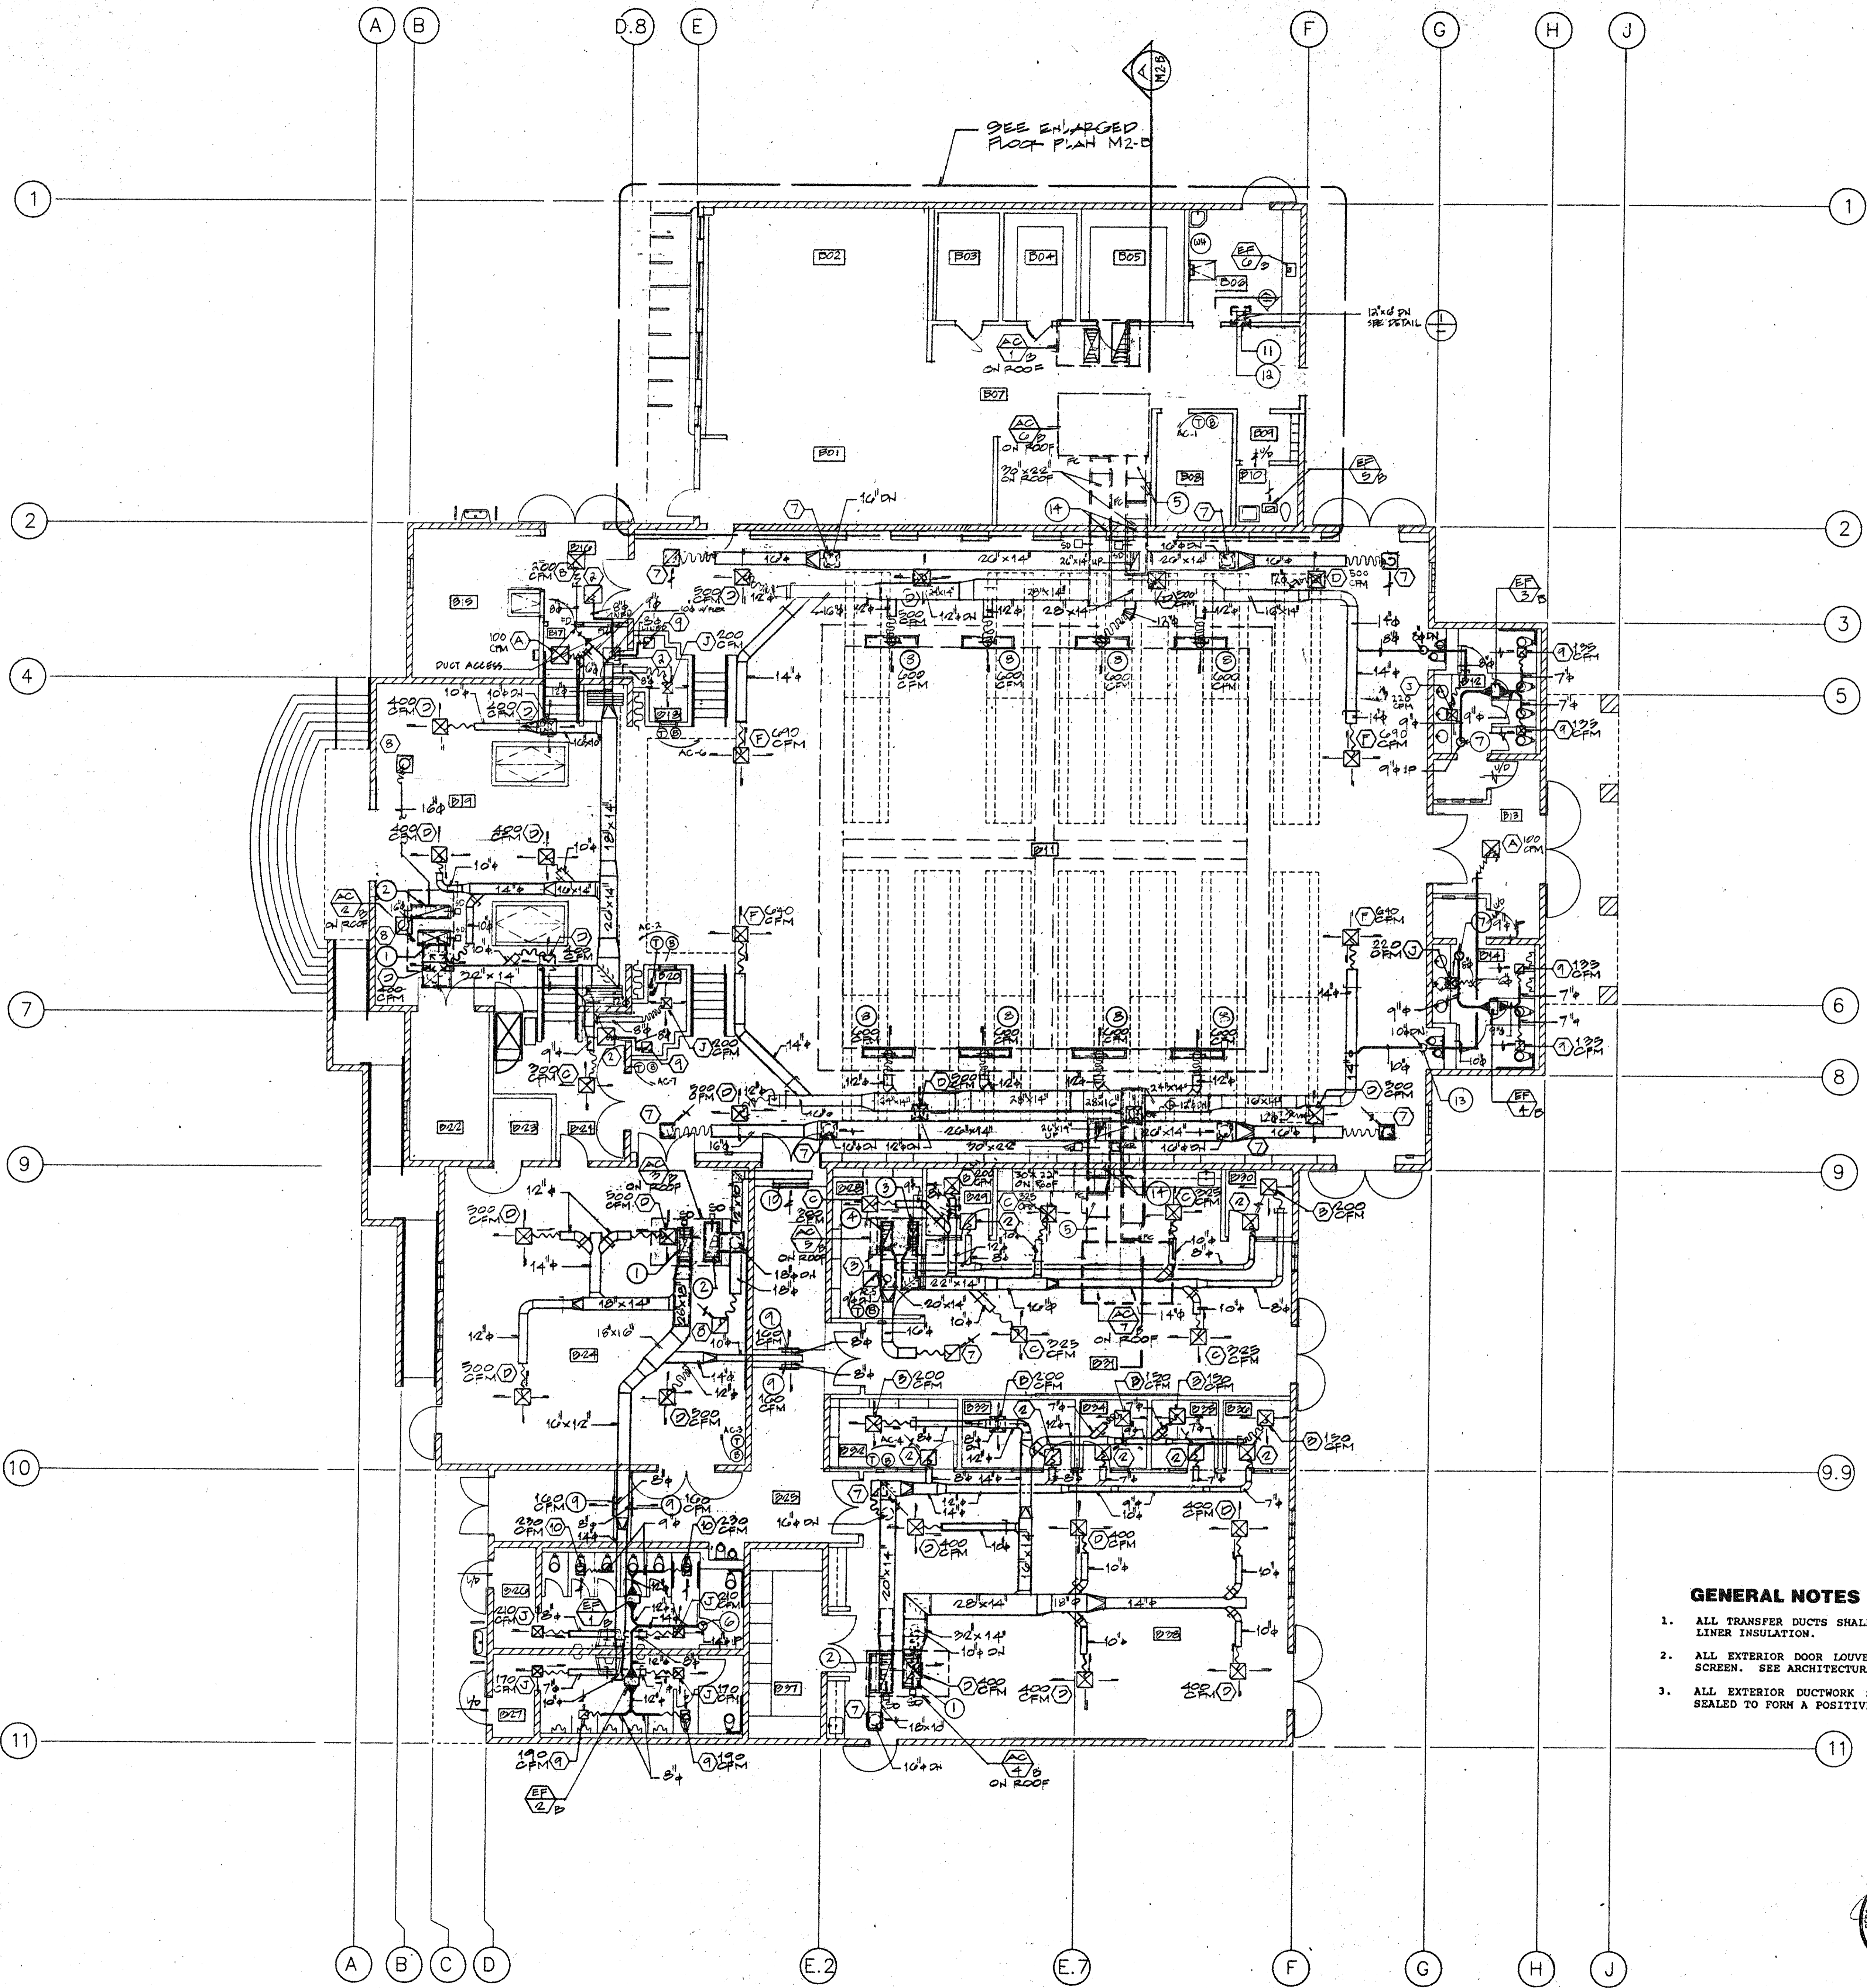

ROOM NAMES



- B01 FAST SERVICE ROOM
- B02 SNACK BAR/COOKING AREA
- B03 REFRIGERATOR
- B04 FREEZER
- B05 DRY FOOD STORAGE
- B06 CUSTODIAN STORAGE
- B07 FOOD PREPARATION AREA
- B08 DIRECTOR'S OFFICE
- B09 LOCKER AREA
- B10 TOILET
- B11 MULTI-PURPOSE ROOM
- B12 WOMEN'S RESTROOM
- B13 VESTIBULE
- B14 MEN'S RESTROOM
- B15 STORAGE
- B16 VESTIBULE
- B17 VESTIBULE
- B18 ELECTRICAL ROOM
- B19 REGULAR STAGE
- B20 CONTROL ROOM
- B21 VESTIBULE
- B22 STAGE STORAGE
- B23 STORAGE
- B24 DRAMA CLASSROOM
- B25 HALLWAY
- B26 GIRLS' RESTROOM
- B27 BOYS' RESTROOM
- B28 OFFICE/LIBRARY
- B29 PRACTICE ROOM
- B30 PRACTICE ROOM
- B31 CHAIR CLASSROOM
- B32 LIBRARY
- B33 OFFICE/PRACTICE ROOM
- B34 PRACTICE ROOM
- B35 PRACTICE ROOM
- B36 PRACTICE ROOM
- B37 LOCKER/STORAGE
- B38 BAND CLASSROOM

REFERENCE NOTES

- 1 32" X 16" LINED SUPPLY AIR DUCT UP TO UNIT ON ROOF. PROVIDE TRANSITIONS AS REQUIRED AND CONNECT TO UNIT WITH FLEXIBLE CONNECTOR.
- 2 32" X 16" LINED RETURN AIR DUCT UP TO UNIT ON ROOF. PROVIDE TRANSITIONS AS REQUIRED AND CONNECT TO UNIT WITH FLEXIBLE CONNECTOR.
- 3 24" X 14" LINED SUPPLY AIR DUCT UP TO UNIT ON ROOF. PROVIDE TRANSITIONS AS REQUIRED AND CONNECT TO UNIT WITH FLEXIBLE CONNECTOR.
- 4 24" X 14" LINED RETURN AIR DUCT UP TO UNIT ON ROOF. PROVIDE TRANSITIONS AS REQUIRED AND CONNECT TO UNIT WITH FLEXIBLE CONNECTOR.
- 5 COMBINATION ECONOMIZER AND POWER EXHAUST FOR A.C. UNIT WITH HORIZONTAL FLOW (3/4 HP, 460V, 1 PH, 3.2 FLA, 8.4 LRA).
- 6 14" Ø EXHAUST DUCT RISER UP THRU ROOF AND CONNECT TO ROOF JACK. DUCT BRANCHES CONNECTED TO RISER SHALL NOT BE IN THE SAME PLANE.
- 7 8" Ø EXHAUST DUCT UP THRU ROOF AND CONNECT TO ROOF JACK. PROVIDE TRANSITIONS AS REQUIRED AND CONNECT TO EXHAUST FAN WITH FLEXIBLE CONNECTOR.
- 8 SIDEWALL ADJUSTABLE LINEAR SLOT SUPPLY DIFFUSERS - DIFFUSERS SHALL MEET ALL THE FOLLOWING CHARACTERISTICS: SURFACE MOUNT, NUMBER OF SLOTS = 4 WITH 3/4" WIDE SLOTS, LENGTH = 6' (EA.), AIRFLOW = 100 CFM/FT, NC = 30 MAX. DIFFUSER SHALL BE METAL AIRE SERIES 6000 COMPLETE WITH BPI INSULATED BOOT PLENUM.
- 9 SIDEWALL ADJUSTABLE LINEAR SLOT SUPPLY DIFFUSERS. DIFFUSERS SHALL MEET ALL THE FOLLOWING CHARACTERISTICS: SURFACE MOUNT, NUMBER OF SLOTS = 3 WITH 3/4" WIDE SLOTS, LENGTH = 2' (EA.), AIR FLOW = 80 CFM/FT, NC = 30. DIFFUSER SHALL BE METAL AIRE SERIES 6000.
- 10 SIDEWALL ADJUSTABLE LINEAR SLOT RETURN REGISTER. REGISTER SHALL MEET ALL THE FOLLOWING CHARACTERISTICS: SURFACE MOUNT, NUMBER OF SLOTS = 4 WITH 3/4" WIDE SLOTS, LENGTH = 4', AIRFLOW = 160 CFM/FT, NC = 30. REGISTER SHALL BE METAL AIRE SERIES 6000.
- 11 AIR INTAKE GRAVITY VENTILATOR ON ROOF COMPLETE WITH 8" HIGH CURB, BIRD SCREEN AND ANTI-CONDENSATE COATING. UNIT SHALL BE LOREN COOK TYPE VI AND UNIT SIZE = 12" X 12".
- 12 12" X 12" INTAKE AIR DUCT DOWN FROM GRAVITY VENTILATOR. REFER TO DETAIL (NO. 1) FOR DUCT ARRANGEMENT.
- 13 10" Ø SUPPLY AIR DUCT DOWN IN FURRED SPACE. SEE ARCHITECTURAL DRAWING FOR DETAIL.
- 14 FOR DUCT PENETRATION THRU WALL, REFER TO DETAIL (NO. 4).
- 15 FOR CURB DETAIL, REFER TO DETAIL (NO. 7).

GENERAL NOTES

1. ALL TRANSFER DUCTS SHALL BE LINED WITH 1"-Ø DUCT LINER INSULATION.
2. ALL EXTERIOR DOOR LOUVERS SHALL BE PROVIDED WITH SCREEN. SEE ARCHITECTURAL DRAWINGS.
3. ALL EXTERIOR DUCTWORK SHALL BE WEATHERPROOF AND SEALED TO FORM A POSITIVE AIR AND WATERTIGHT SEAL.

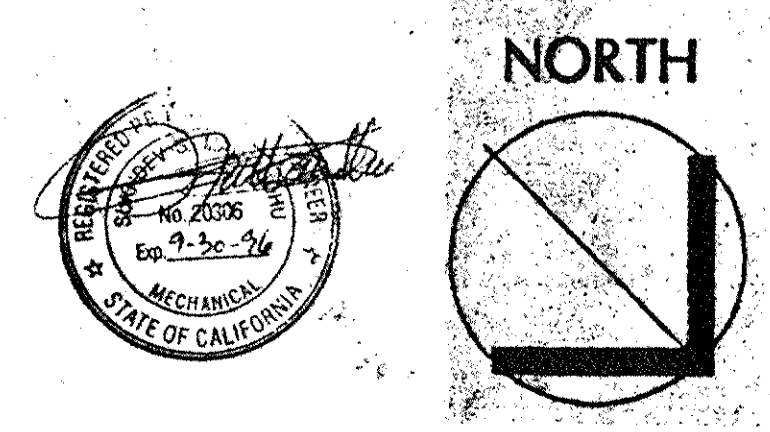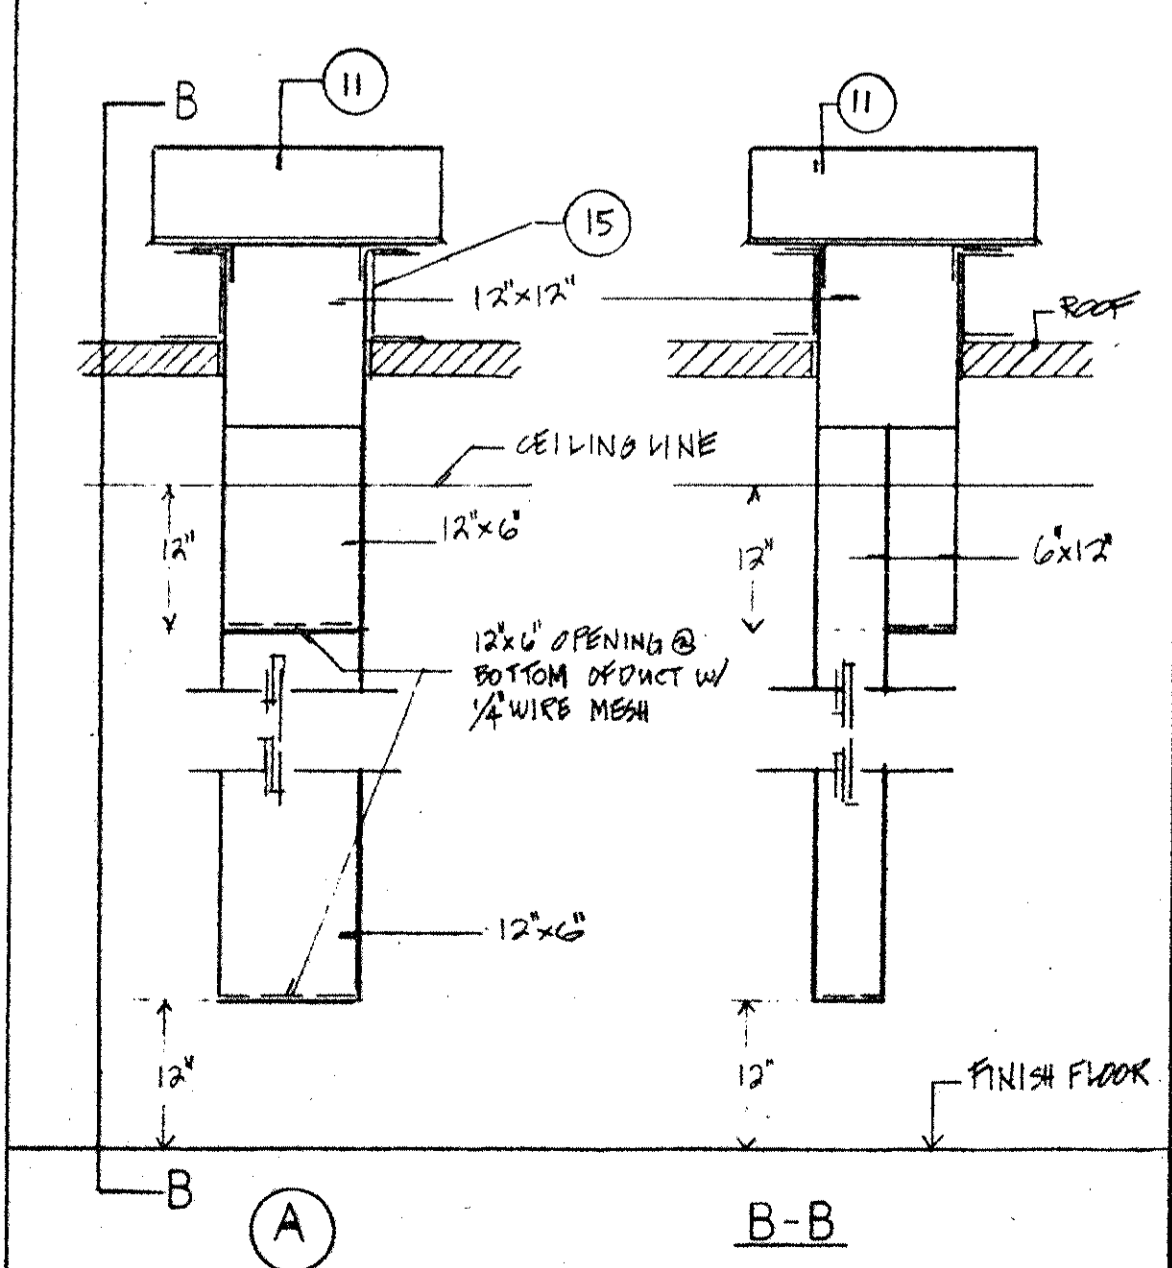

BUILDING 'B' FLOOR PLAN

1/8"=1'-0"

DETAIL

NTS



Murrieta Valley Unified School District

Thompson Phase 2 Middle School

CONSULTANT
MATHAUDHU ENGINEERING, INC.
 CONSULTING MECHANICAL ENGINEERS
 2603 BROOKTON AVE., SUITE 6, RIVERSIDE, CA 92501
 (951) 508-1178

APPROVED

APPROVED

 REGISTERED ARCHITECT
 State of California
 No. M-14546
 Exp. 08/31/99


APPROVED
 IDENTIFICATION STAMP
 DIV. OF THE STATE ARCHITECT
 OFFICE OF REGULATION SERVICES
 APPL. 61167
 AG: FLSK
 DATE: 1/11/94

NO	DATE	BY	REMARKS

BUILDING 'B' MECHANICAL FLOOR PLAN

DRAWN CC/BTS
 CHECKED SSM
 DATE JAN. 94
 SCALE AS NOTED
 JOB NO. 9210400

M1.B

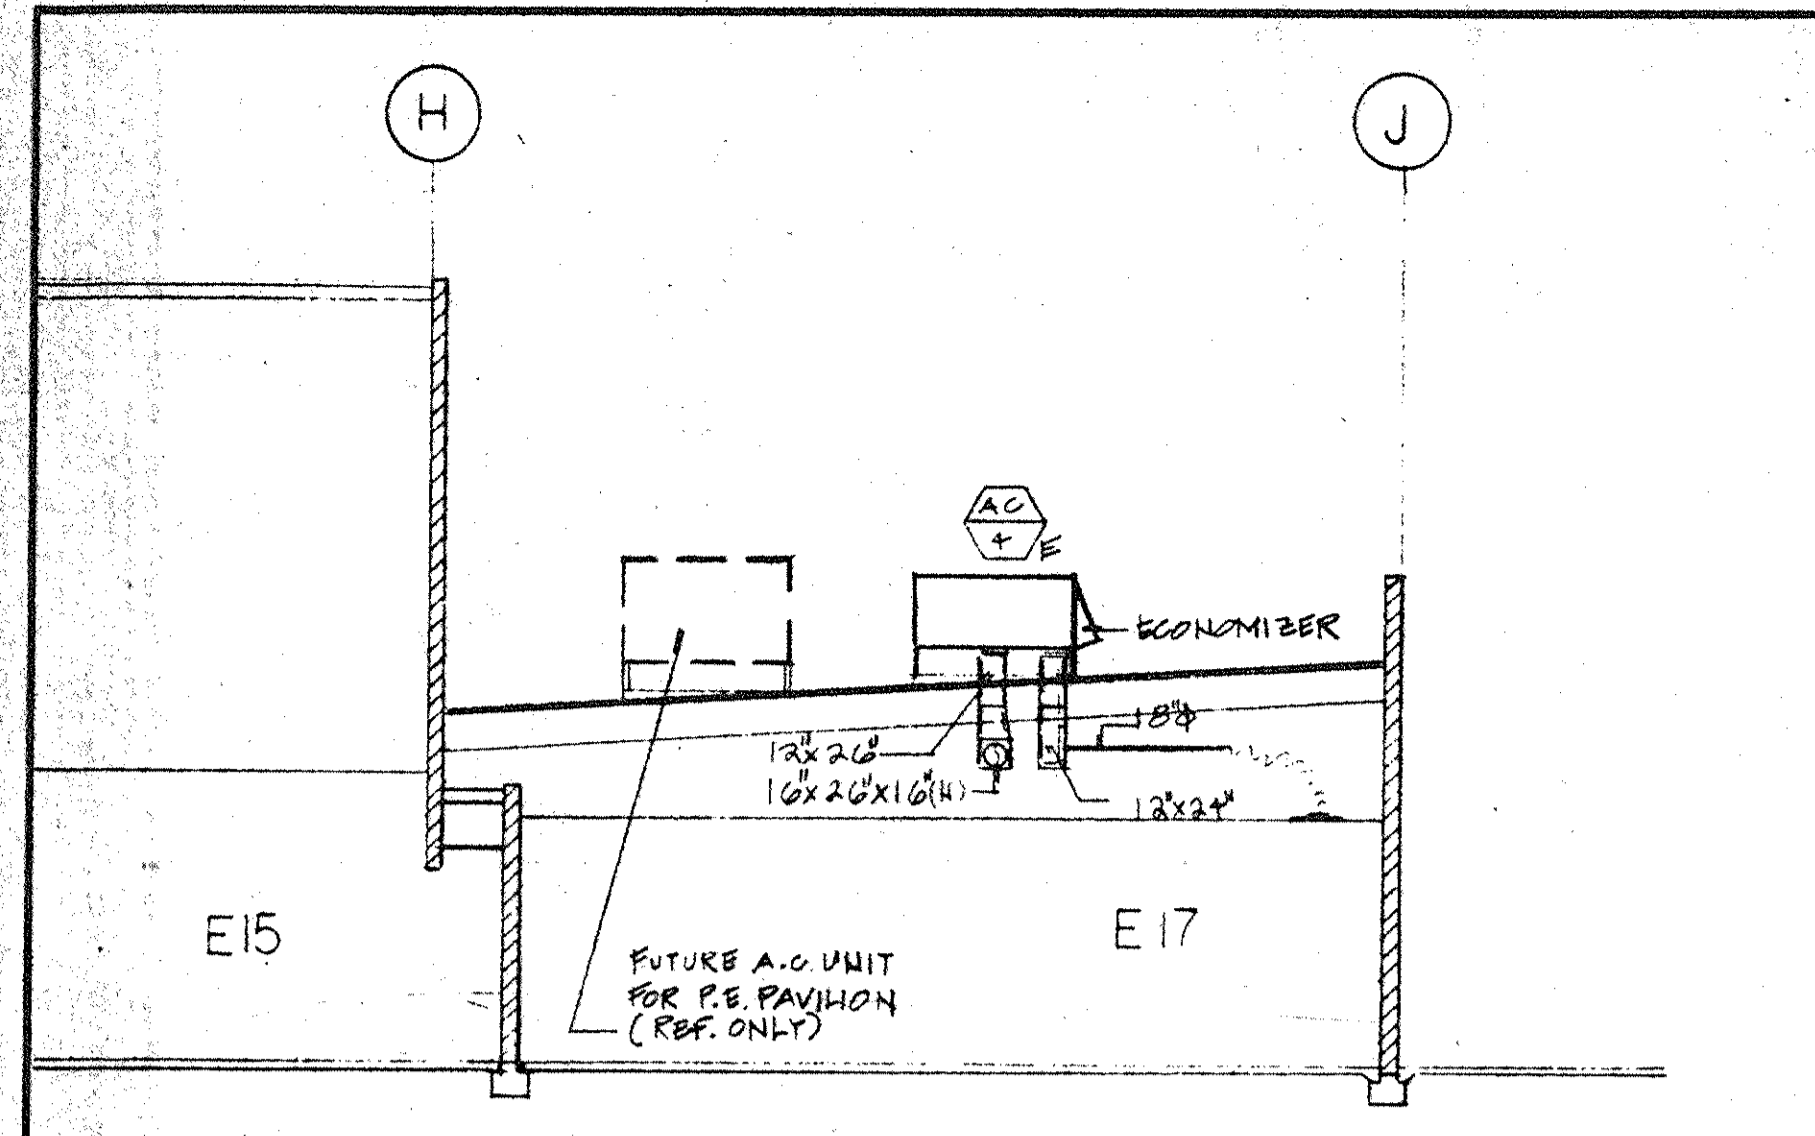

SECTION A


1/8" = 1'-0"

ROOM NAMES

- E01 EQUIPMENT STORAGE
- E02 FEMALE STAFF OFFICE
- E03 GIRLS' LOCKER ROOM
- E04 WOMEN'S SHOWER/LOCKER/RESTROOM
- E05 ELECTRICAL ROOM
- E06 GIRLS' SHOWER
- E07 GIRLS' RESTROOM
- E08 MEN'S SHOWER/LOCKER/RESTROOM
- E09 CUSTODIAN
- E10 BOYS' SHOWER
- E11 BOYS' RESTROOM
- E12 MALE STAFF OFFICE
- E13 EQUIPMENT STORAGE
- E14 BOYS' LOCKER
- E15 P.E. PAVILION
- E16 HEIGHT TRAINING ROOM
- E17 WRESTLING ROOM
- E18 DANCE ROOM
- E19 P.E. CLASSROOM

REFERENCE NOTES


- 1 26" X 12" LINED SUPPLY AIR DUCT UP TO UNIT ON ROOF. PROVIDE TRANSITIONS AS REQUIRED AND CONNECT TO UNIT WITH FLEXIBLE CONNECTOR.
- 2 24" X 12" LINED RETURN AIR DUCT UP TO UNIT ON ROOF. PROVIDE TRANSITIONS AS REQUIRED AND CONNECT TO UNIT WITH FLEXIBLE CONNECTOR.
- 3 34" X 14" LINED SUPPLY AIR DUCT UP TO UNIT ON ROOF. PROVIDE TRANSITIONS AS REQUIRED AND CONNECT TO UNIT WITH FLEXIBLE CONNECTOR.
- 4 34" X 12" LINED RETURN AIR DUCT UP TO UNIT ON ROOF. PROVIDE TRANSITIONS AS REQUIRED AND CONNECT TO UNIT WITH FLEXIBLE CONNECTOR.
- 5 16" X 16" EXHAUST DUCT UP THRU ROOF. PROVIDE TRANSITIONS AS REQUIRED AND CONNECT TO ROOF EXHAUSTER WITH FLEXIBLE CONNECTOR.
- 6 8" EXHAUST DUCT UP THRU ROOF JACK AND CONNECT TO ROOF JACK. PROVIDE TRANSITIONS AS REQUIRED AND CONNECT TO EXHAUST FAN IN CEILING PLENUM WITH FLEXIBLE CONNECTOR.
- 7 AIR INTAKE UNIT ON ROOF COMPLETE WITH 8" HIGH CURB, BIRD SCREEN AND ANTI-CONDENSATE COATING. UNIT SHALL BE LOREN COOK, TYPE VI OF 24" X 24" THROAT SIZE.
- 8 24" X 12" DUCT DOWN AND TERMINATE @ ±12" BELOW FINISH CEILING WITH 1/4" WIRE MESH.
- 9 24" X 12" DUCT DOWN AND TERMINATE @ ±12" ABOVE FINISH FLOOR WITH 1/4" WIRE MESH.
- 10 16" X 16" EXHAUST DUCT UP THRU ROOF AND CONNECT TO EXHAUST FAN ON ROOF WITH FLEXIBLE CONNECTOR. PROVIDE TRANSITIONS AS REQUIRED.

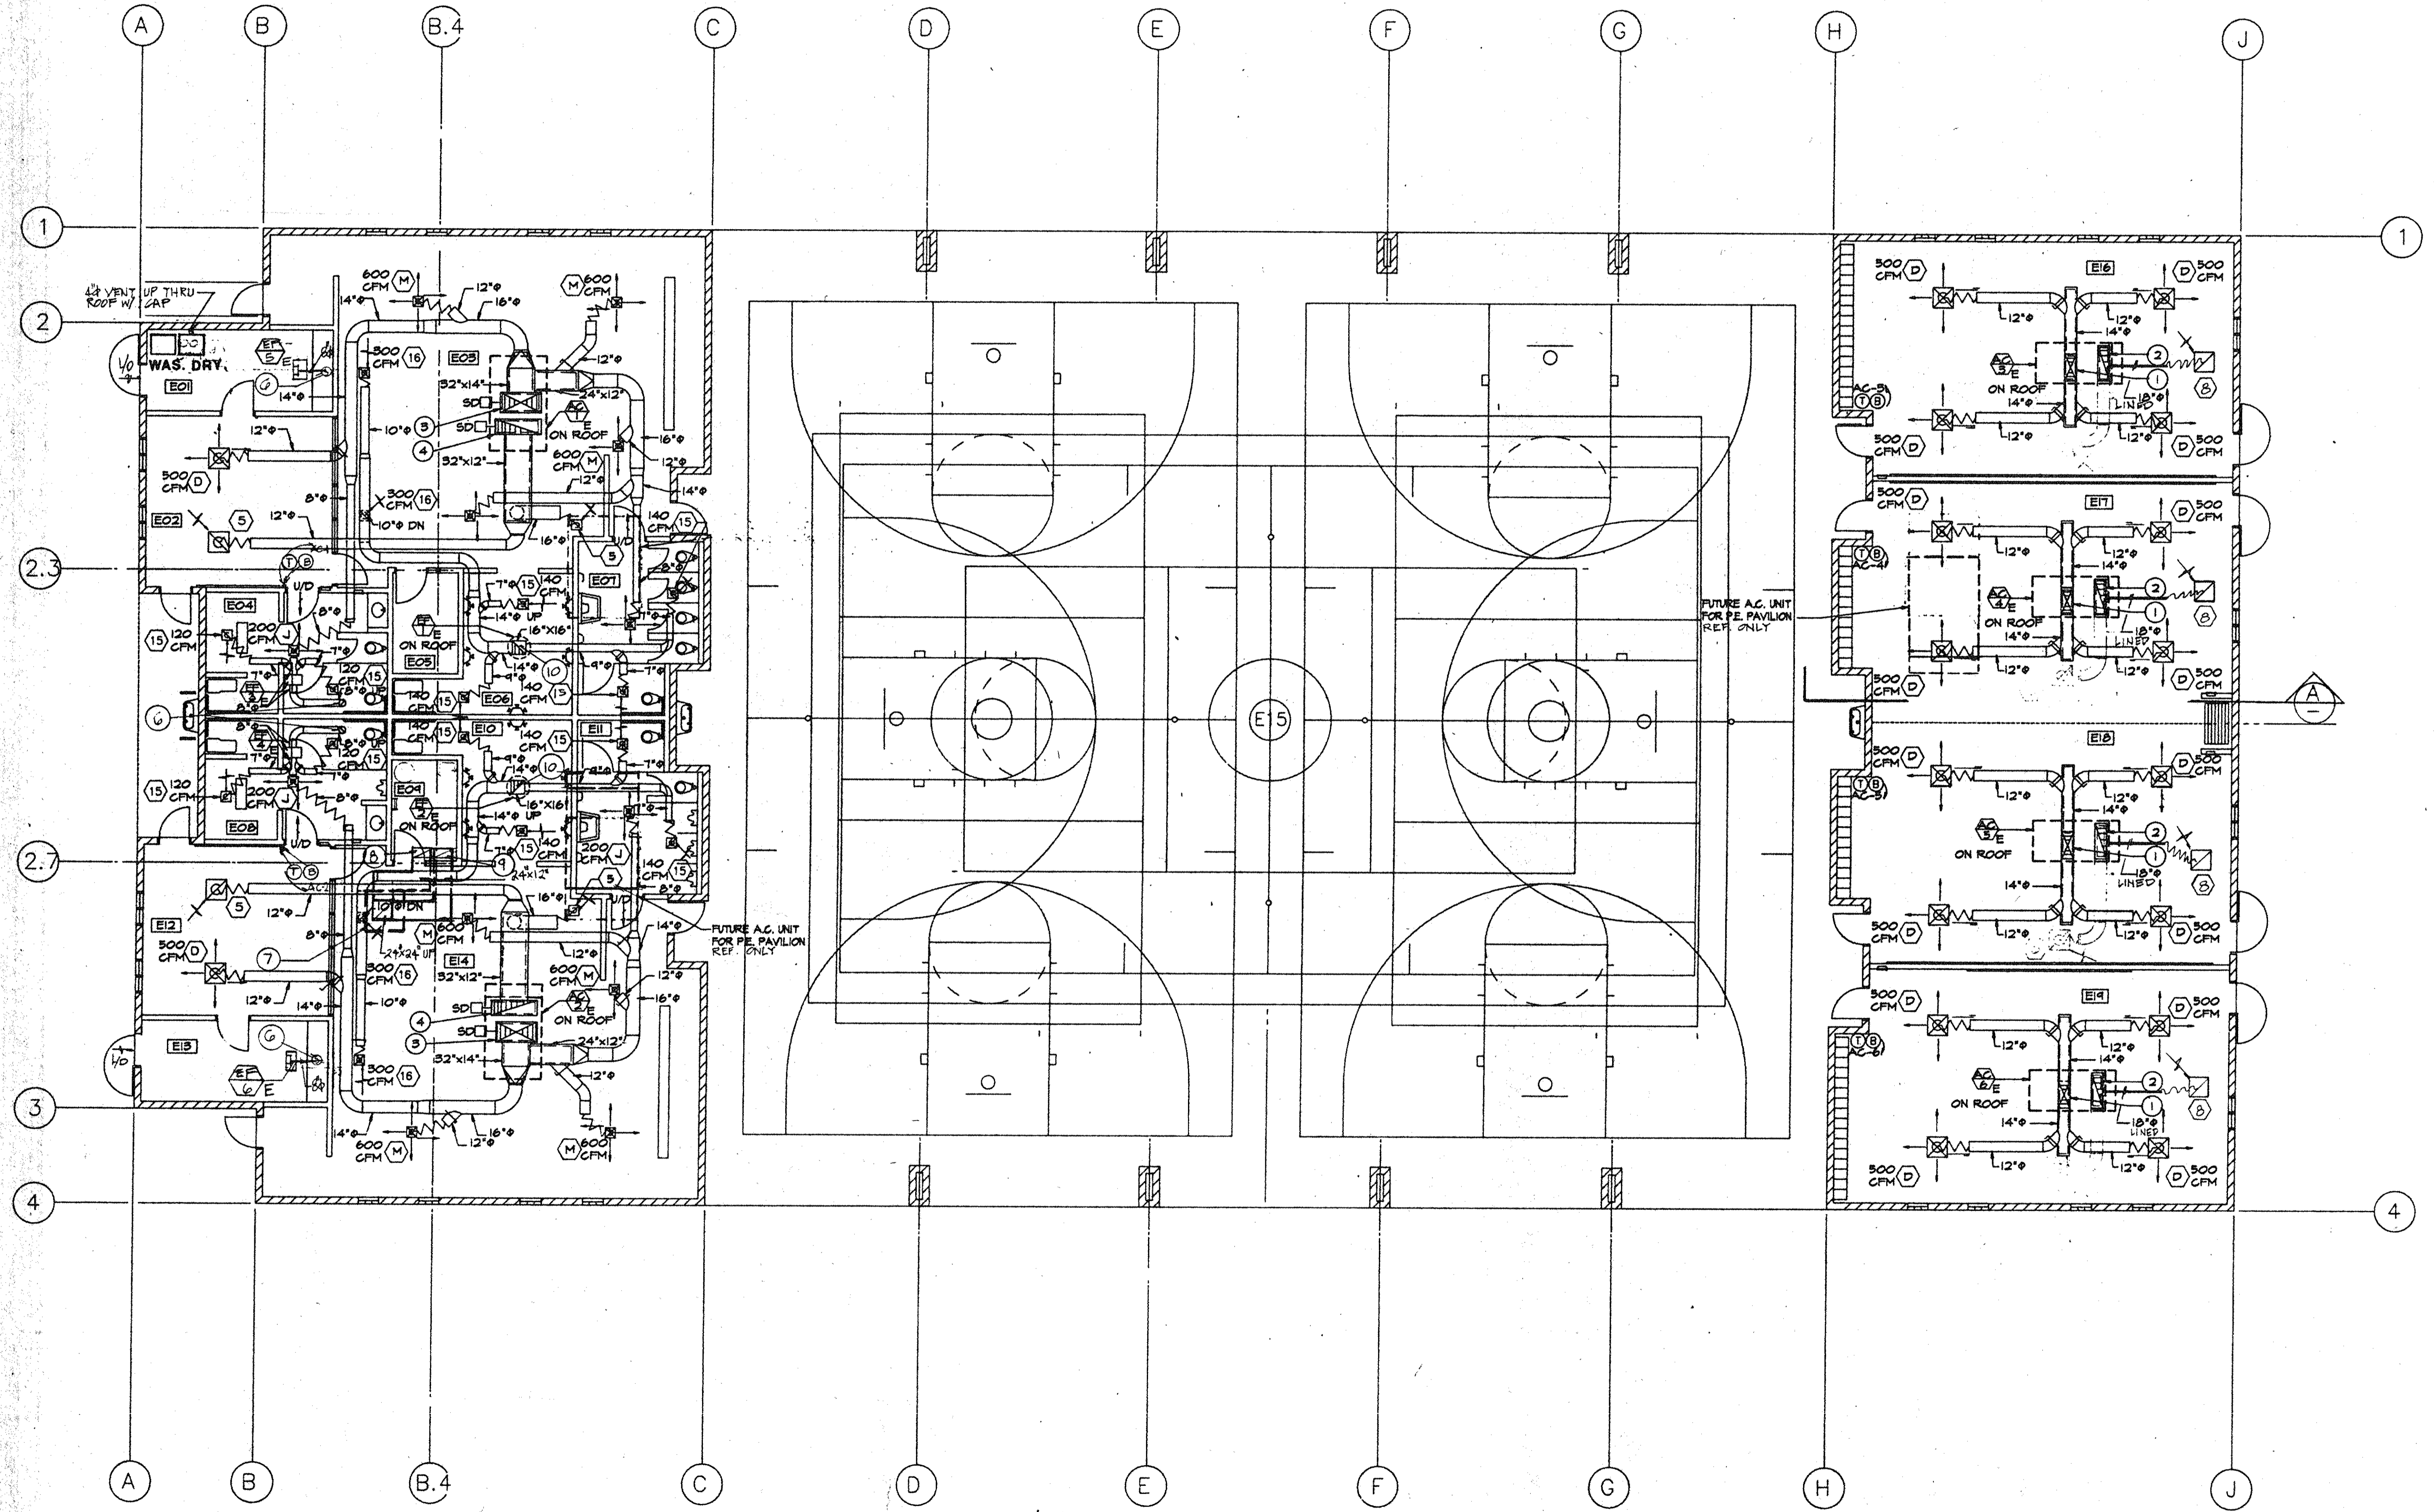

GENERAL NOTES

1. ALL TRANSFER DUCTS SHALL BE LINED WITH 1'-0" DUCT LINER INSULATION.
2. ALL EXTERIOR DOOR LOUVERS SHALL BE PROVIDED WITH SCREEN. SEE ARCHITECTURAL DRAWINGS.
3. ALL EXTERIOR DUCTWORK SHALL BE WEATHERPROOF AND SEALED TO FORM A POSITIVE AIR AND WATERTIGHT SEAL.

NORTH

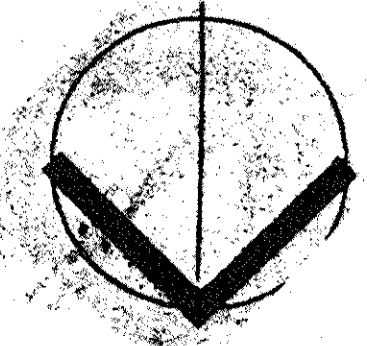

1/8" = 1'-0"

BUILDING 'E' FLOOR PLAN



Murrieta Valley Unified School District

Thompson Middle School
Phase 2

CONSULTANT
MATHAUDHU ENGINEERING, INC.
CONSULTING MECHANICAL ENGINEERS
3803 BROOKTON AVE., SUITE 2, RIVERSIDE, CA 92501
(951) 506-1178

APPROVED

APPROVED


 GEORGE M. WANS
 C-14546
 8/31/99
 STATE OF CALIFORNIA


APPROVED
 IDENTIFICATION STAMP
 DIV. OF THE STATE ARCHITECT
 OFFICE OF REGULATION SERVICES
 APPL 61167
 AC _____ FILED _____
 DATE _____
 STATE OF CALIFORNIA

NO	DATE	BY	REMARKS

BLDG E MECHANICAL FLOOR PLAN

DRAWN DP/DS
 CHECKED SSM
 DATE JAN. 94
 SCALE AS NOTED
 JOB NO. 9216420
M1.E

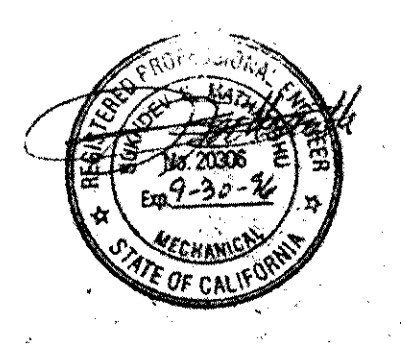

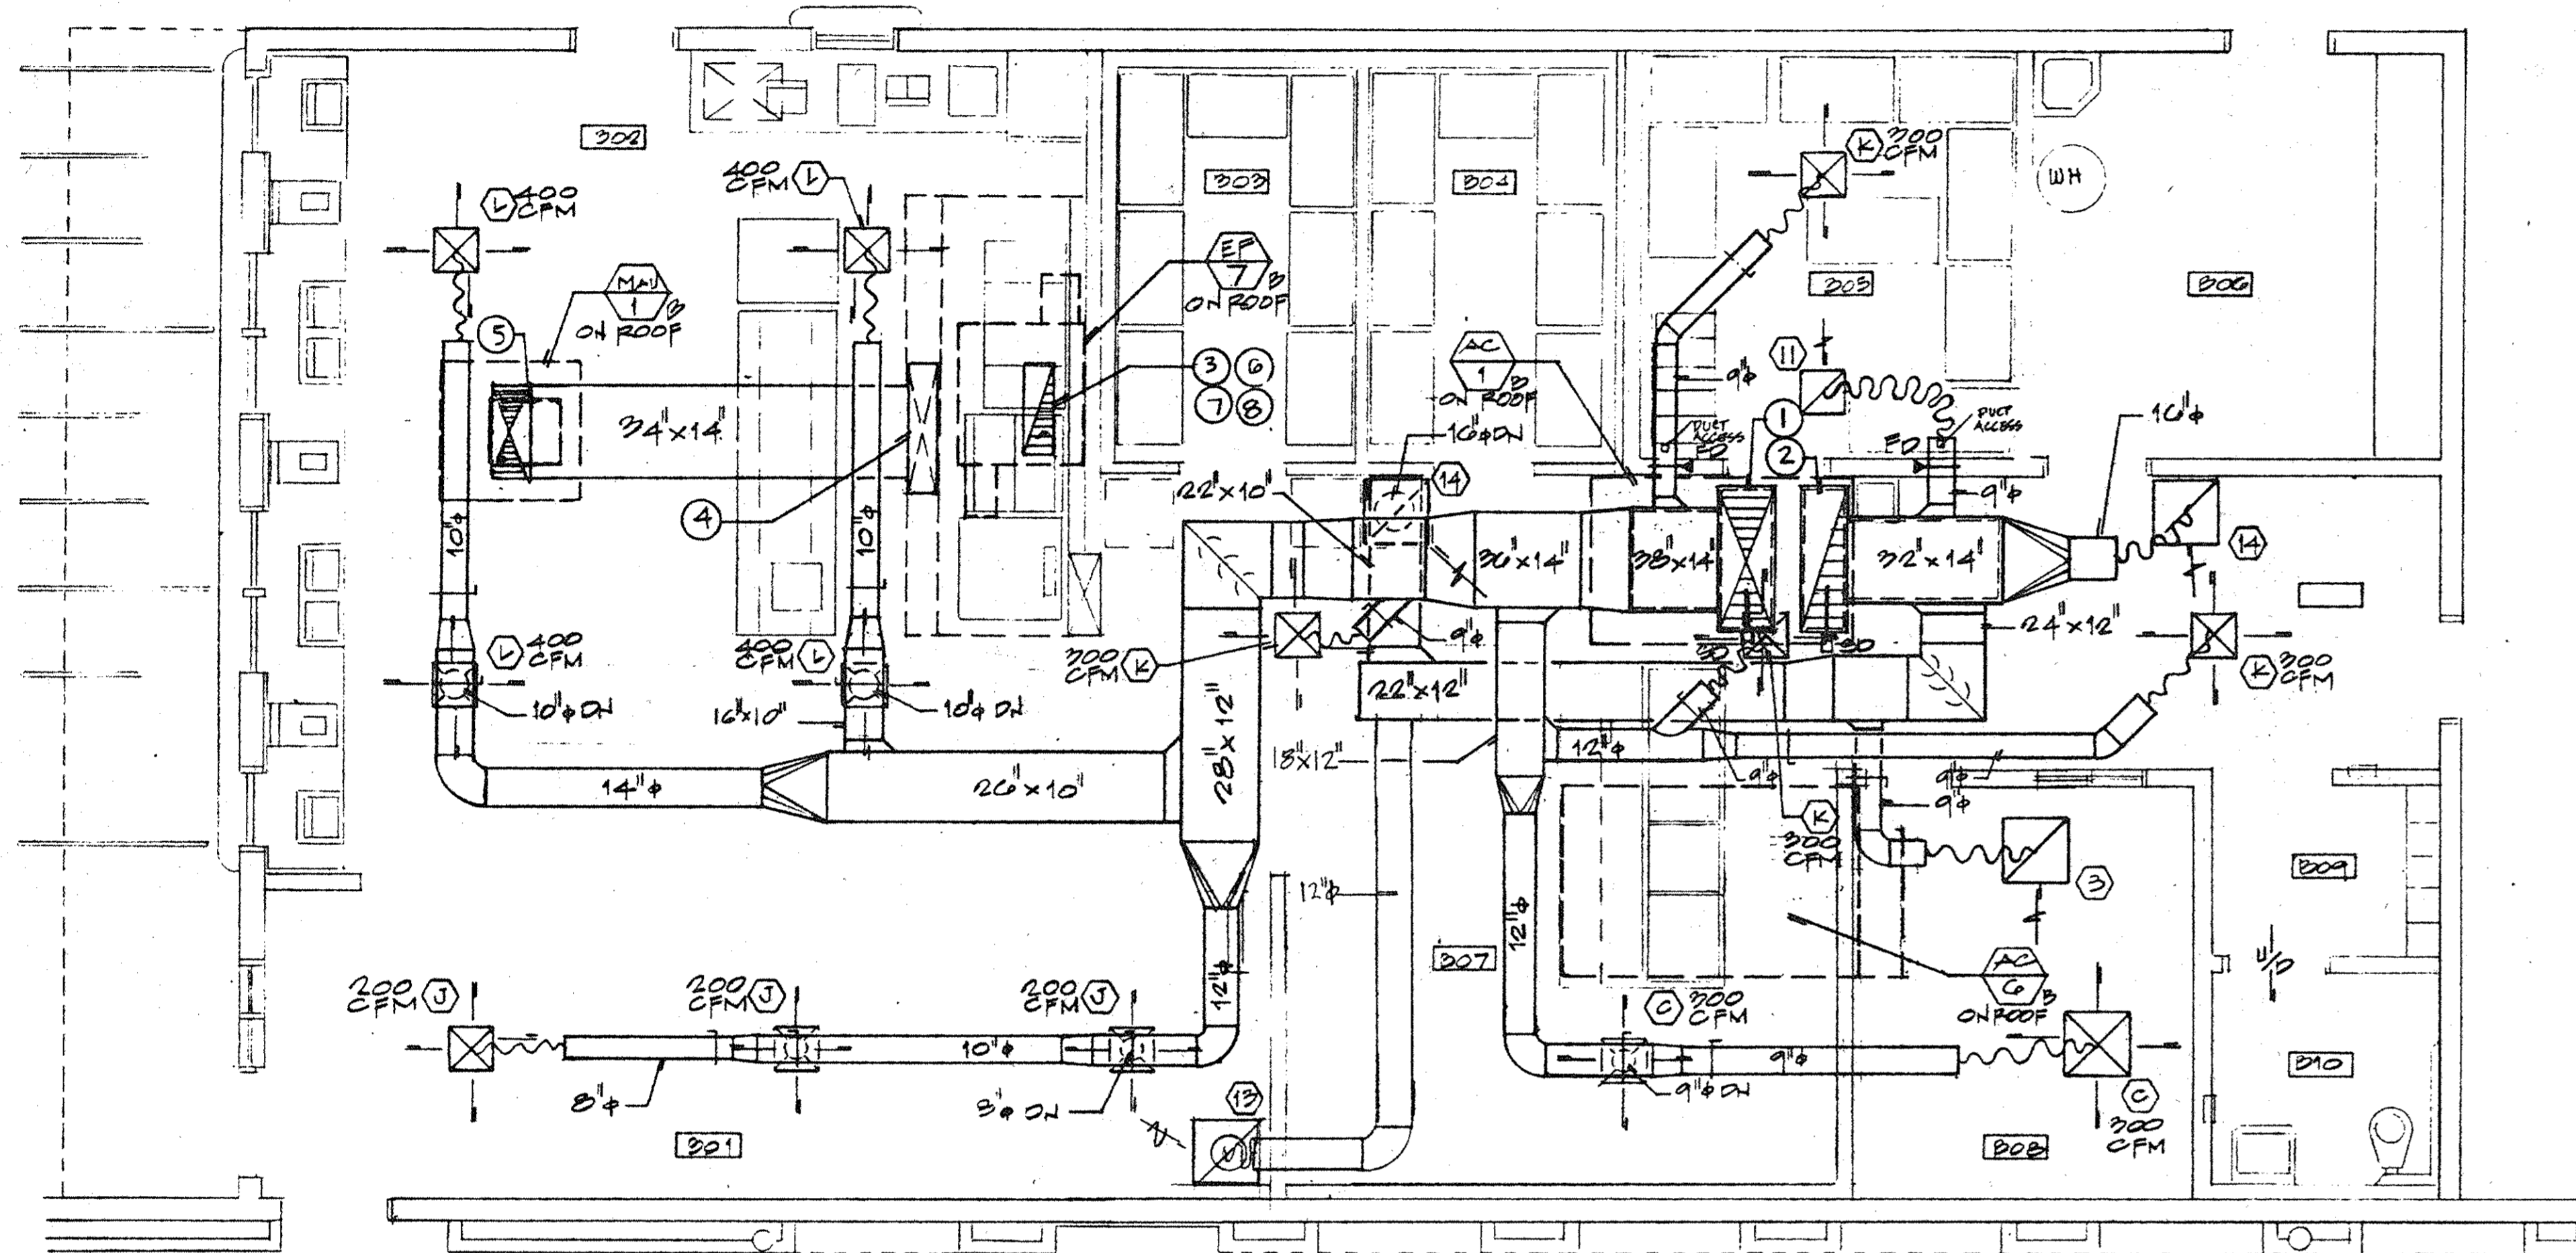


ROOM NAMES

- B01 FAST SERVICE ROOM
- B02 SNACK BAR/COOKING AREA
- B03 REFRIGERATOR
- B04 FREEZER
- B05 DRY FOOD STORAGE
- B06 CUSTODIAN STORAGE
- B07 FOOD PREPARATION AREA
- B08 DIRECTOR'S OFFICE
- B09 LOCKER AREA
- B10 TOILET


REFERENCE NOTES

- ① 38" X 14" LINED SUPPLY AIR DUCT UP TO UNIT ON ROOF. PROVIDE TRANSITIONS AS REQUIRED AND CONNECT TO UNIT WITH FLEXIBLE CONNECTOR.
- ② 36" X 14" LINED RETURN AIR DUCT UP TO UNIT ON ROOF. PROVIDE TRANSITIONS AS REQUIRED AND CONNECT TO UNIT WITH FLEXIBLE CONNECTOR.
- ③ 34" X 10" EXHAUST HOOD OPENING. REFER TO KITCHEN DWG. FOR EXACT LOCATION.
- ④ 47" X 10" SUPPLY HOOD OPENING. REFER TO KITCHEN DWG. FOR EXACT LOCATION.
- ⑤ 34" X 14" SUPPLY AIR DUCT UP THRU ROOF AND CONNECT TO MAKE UP AIR UNIT WITH FLEXIBLE CONNECTOR. PROVIDE TRANSITIONS AS REQUIRED. CONNECT THE OTHER SIDE TO HOOD SUPPLY OPENING.
- ⑥ 34" X 10" EXHAUST DUCT UP AND WELDED TO CURB AND 34" X 10" EXHAUST DUCT UP AND WELDED TO CURB AND 34" X 10" EXHAUST DUCT DOWN AND WELDED TO KITCHEN HOOD EXHAUST OPENING.
- ⑦ EXHAUST DUCT FROM KITCHEN HOOD SHALL BE PROTECTED WITH 1-HOUR FIRE RATED SUPER FIRE TEMP MINERAL AND FIBER BOARD BY PABCO (REFER TO DETAIL 3, M0.4).
- ⑧ ALL EXHAUST DUCT FROM KITCHEN HOOD UP TO CEILING SHALL BE CONSTRUCTED OF STAINLESS STEEL OF AT LEAST 0.044 INCH IN THICKNESS AND ALL EXHAUST DUCT ABOVE CEILING SHALL BE OF GALVANIZED STEEL OF AT LEAST 0.055 INCH THICK. JOINTS AND SEAMS SHALL BE MADE WITH A CONTINUOUS LIQUID-TIGHT WELD.

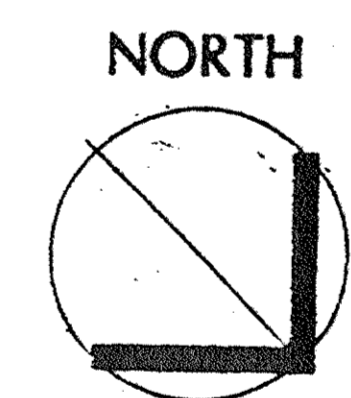

BUILDING 'B' MECHANICAL KITCHEN FLOOR PLAN

SCALE
1/4" = 1'-0"

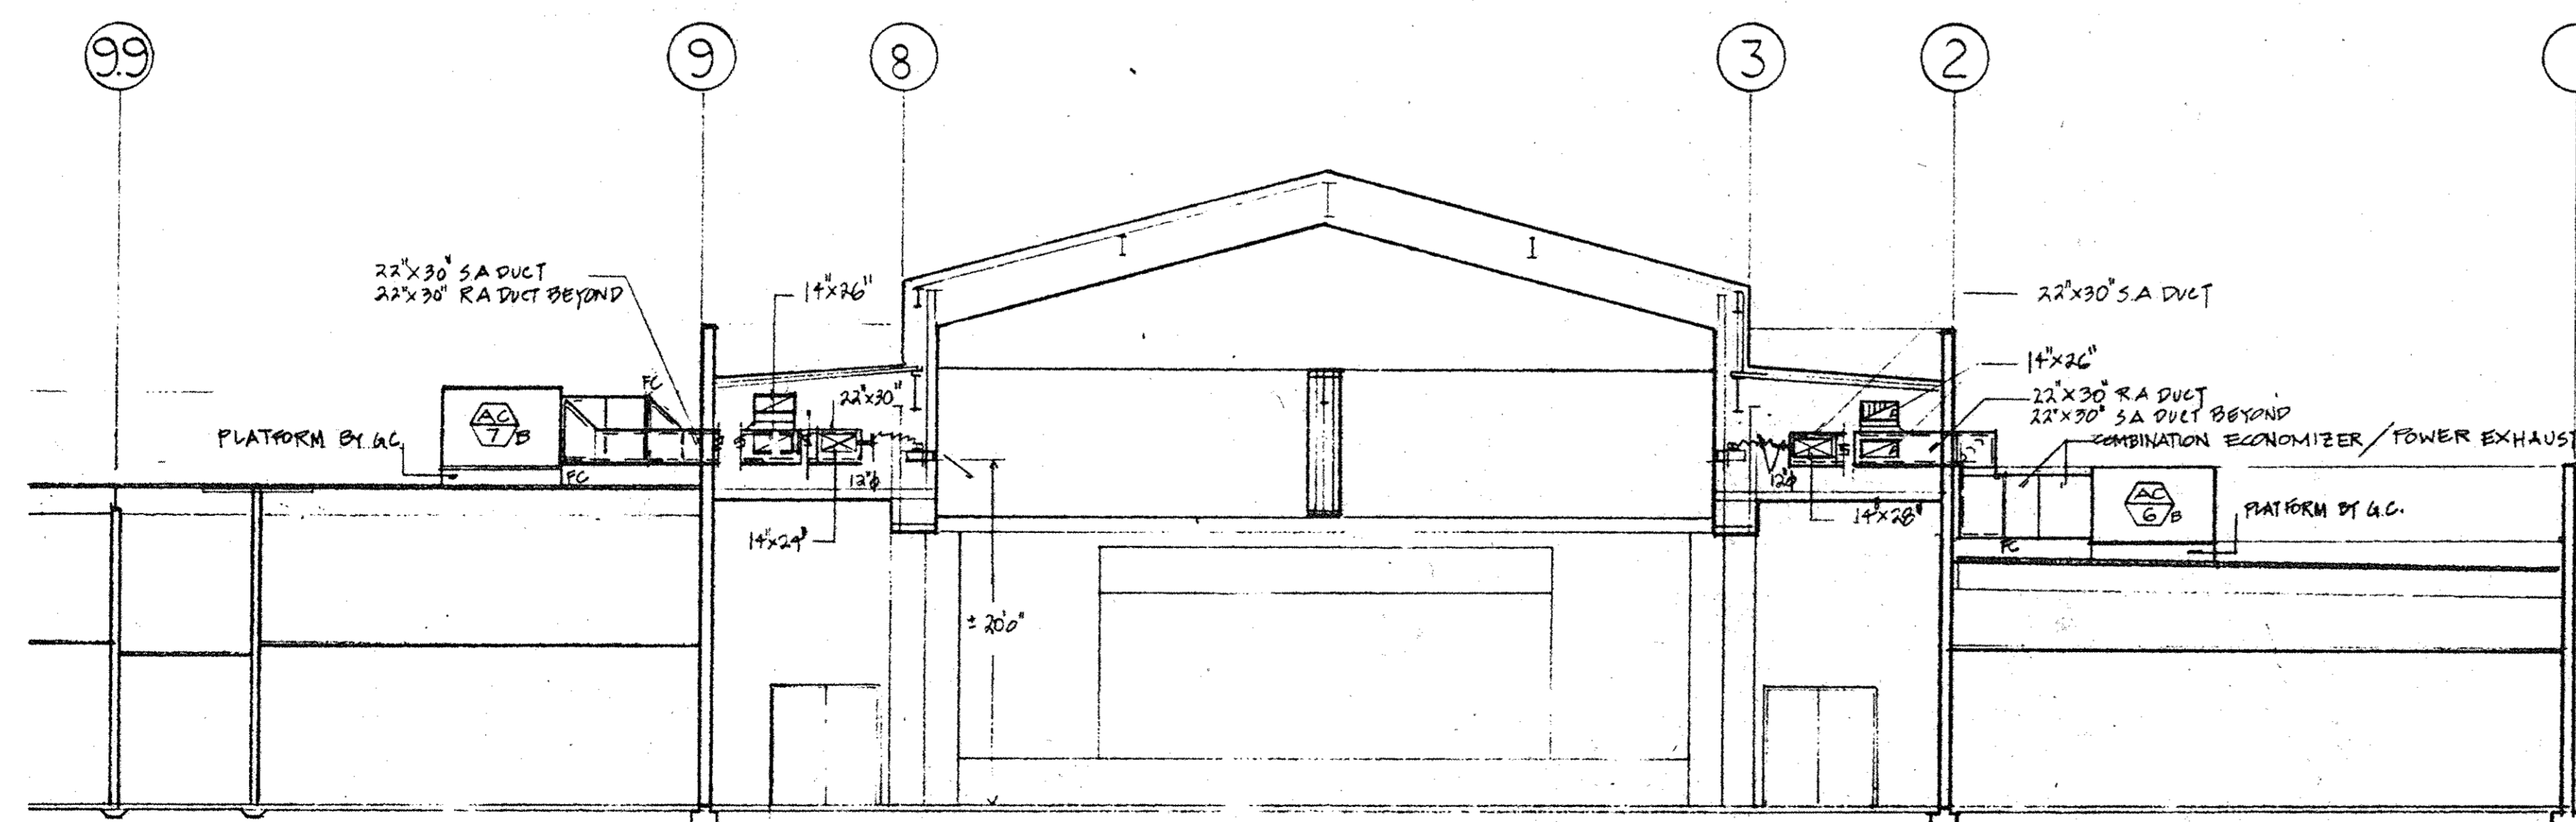

SECTION

SCALE
1/8" = 1'-0"

Murrieta Valley Unified School District

Thompson
Phase 2
Middle School

CONSULTANT
MATHAUDHU ENGINEERING, INC.
CONSULTING MECHANICAL ENGINEERS
3803 BROOKTON AVE., SUITE 8, RIVERSIDE, CA 92505
(951) 988-1778

APPROVED

APPROVED
SEAL OF ARCHITECT
George M. Wilson
C-14548
DATE 1/19/94


APPROVED
IDENTIFICATION STAMP
DIV. OF THE STATE ARCHITECT
OFFICE OF REGULATION SERVICES
APPL 61167
AC FL/1/19/94
DATE 1/19/94

NO	DATE	BY	REMARKS


BUILDING 'B' MECHANICAL KITCHEN FLOOR PLAN

DRAWN CC/BTS
CHECKED SS-VI
DATE JAN. 94
SCALE AS NOTED
JOB NO. 9216403

M2.B





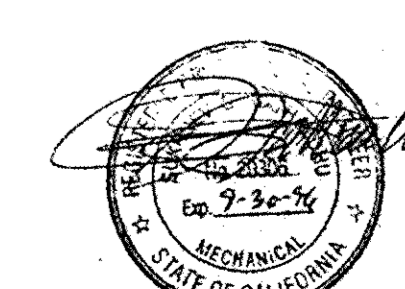


Woff Lang/Christopher Architects, Incorporated
 10070 Foothill Blvd., Rancho Dominguez, CA 91750 (714) 987-0000

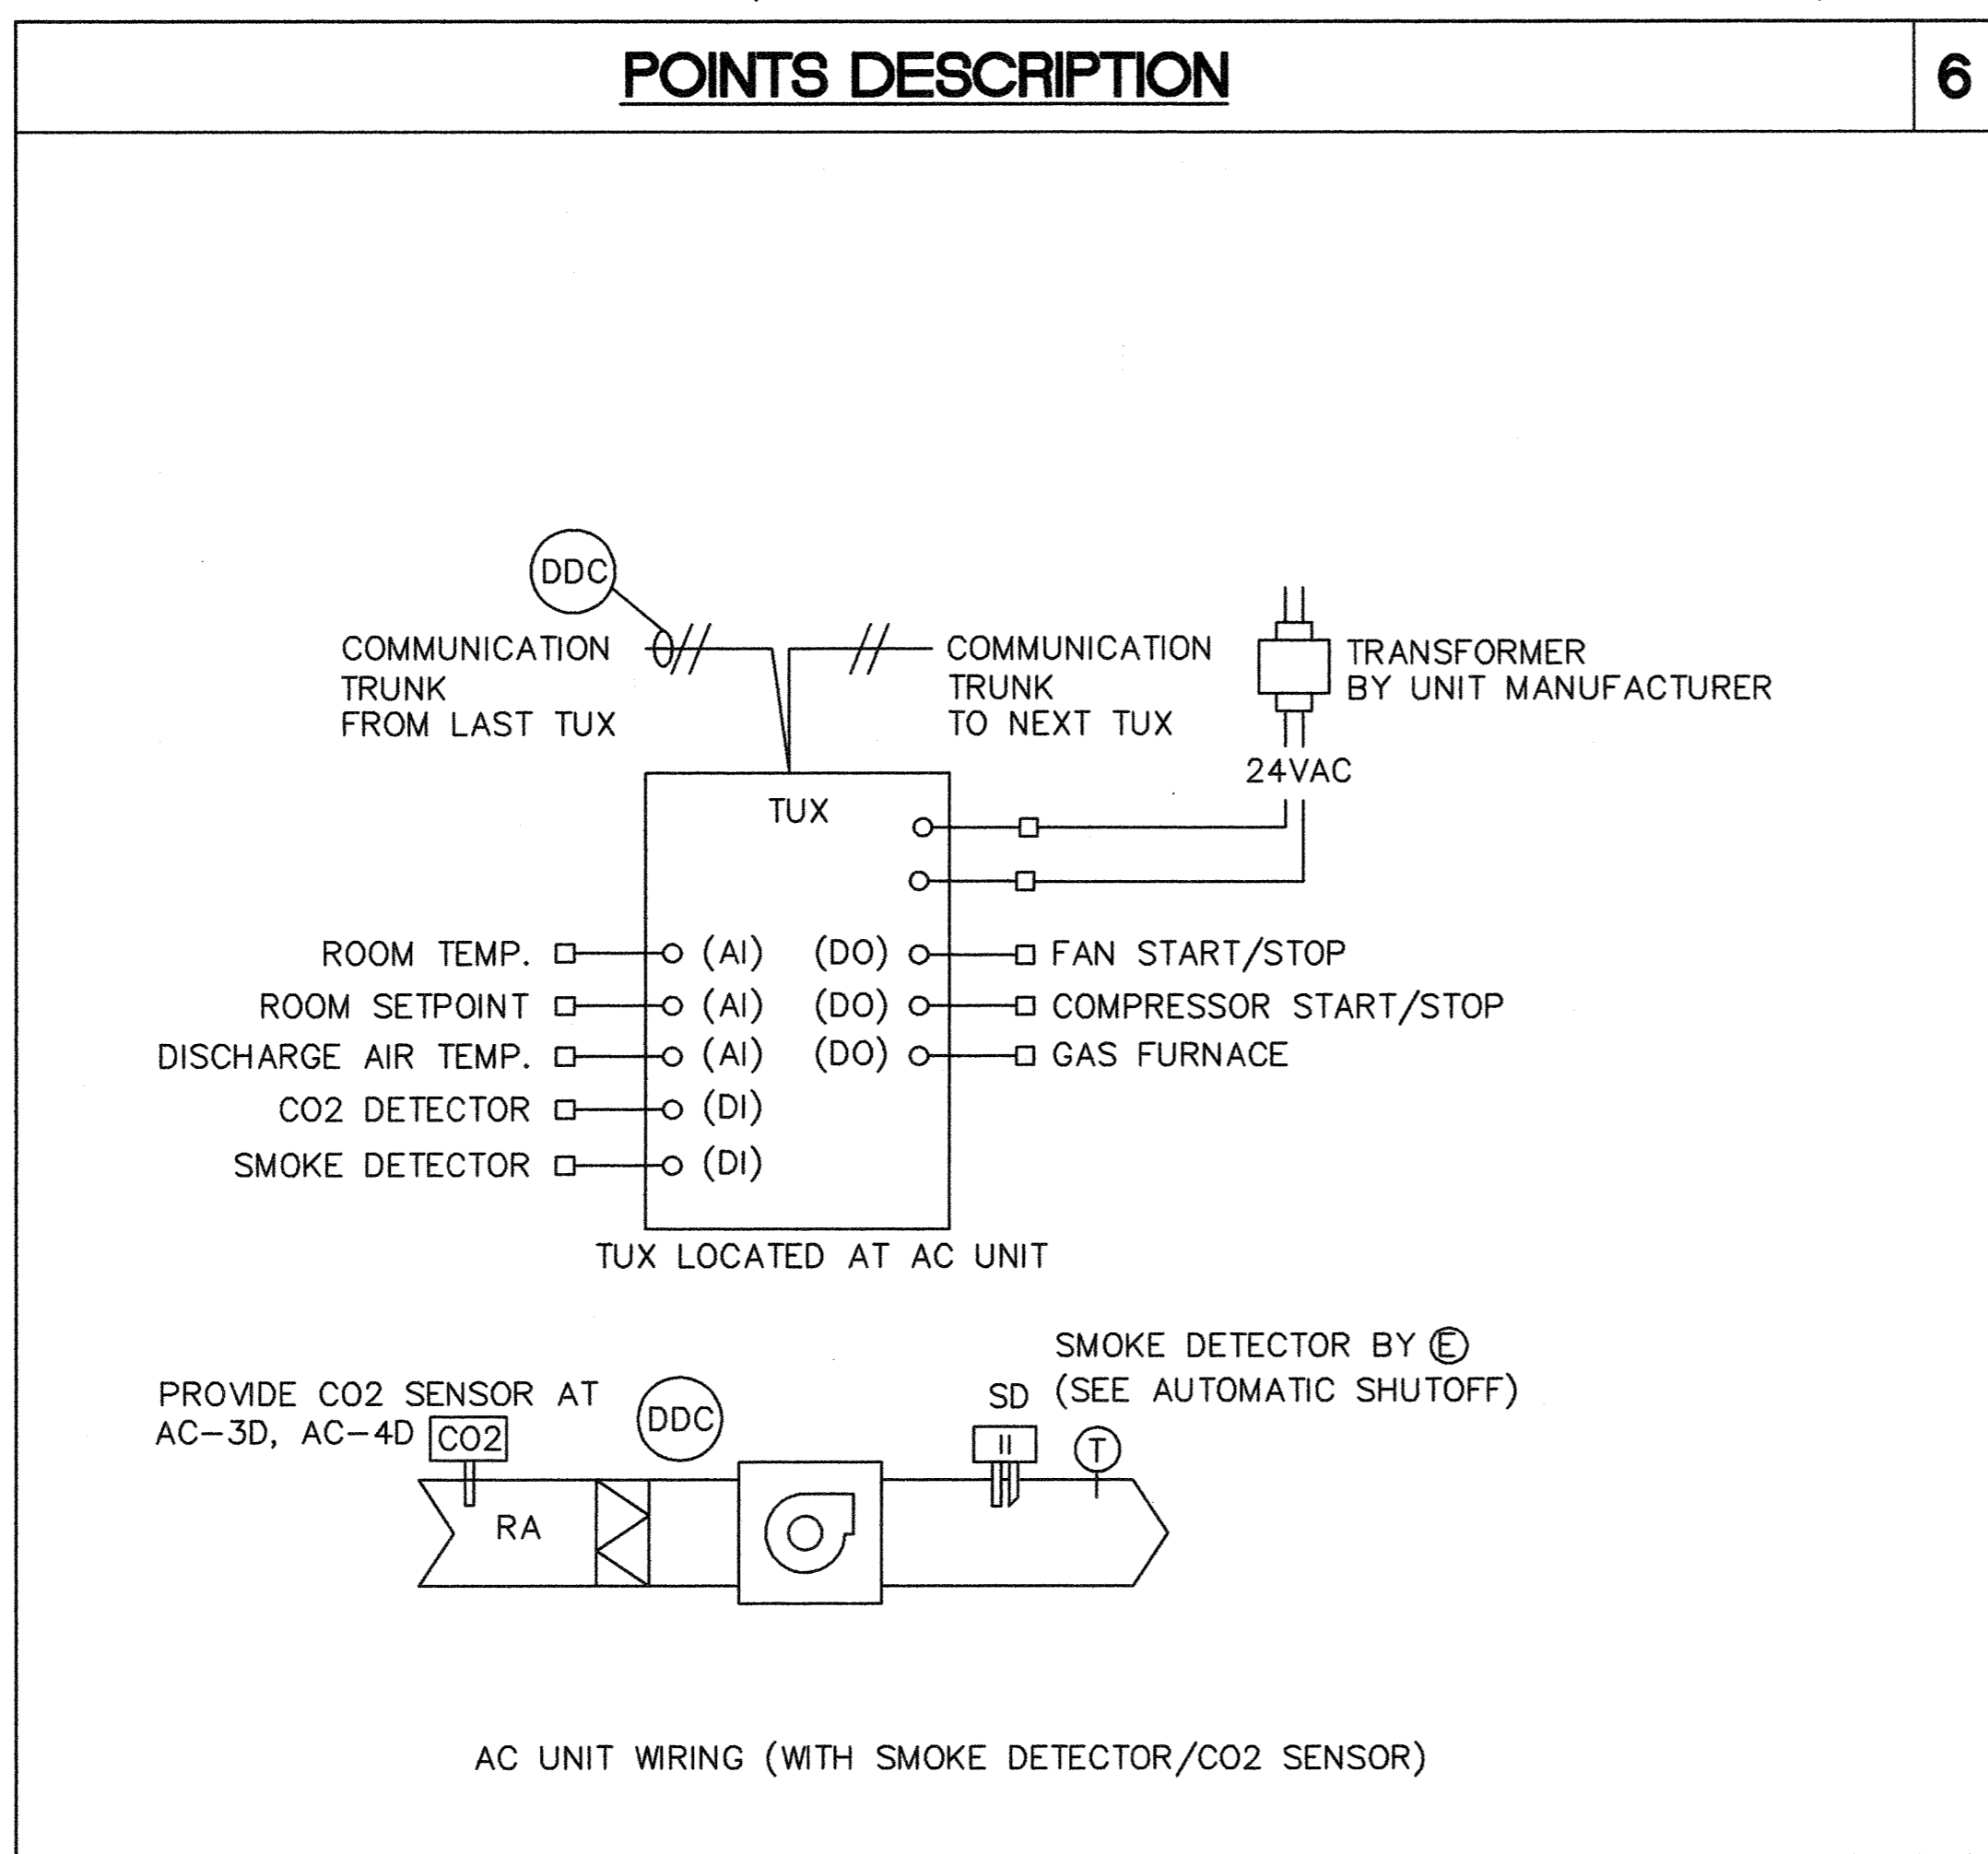

LEGEND 7

(M)	MECHANICAL
(E)	ELECTRICAL
(ME)	EQUIPMENT FURNISHED AND WIRED BY ELECTRICAL AND INSTALLED BY MECHANICAL

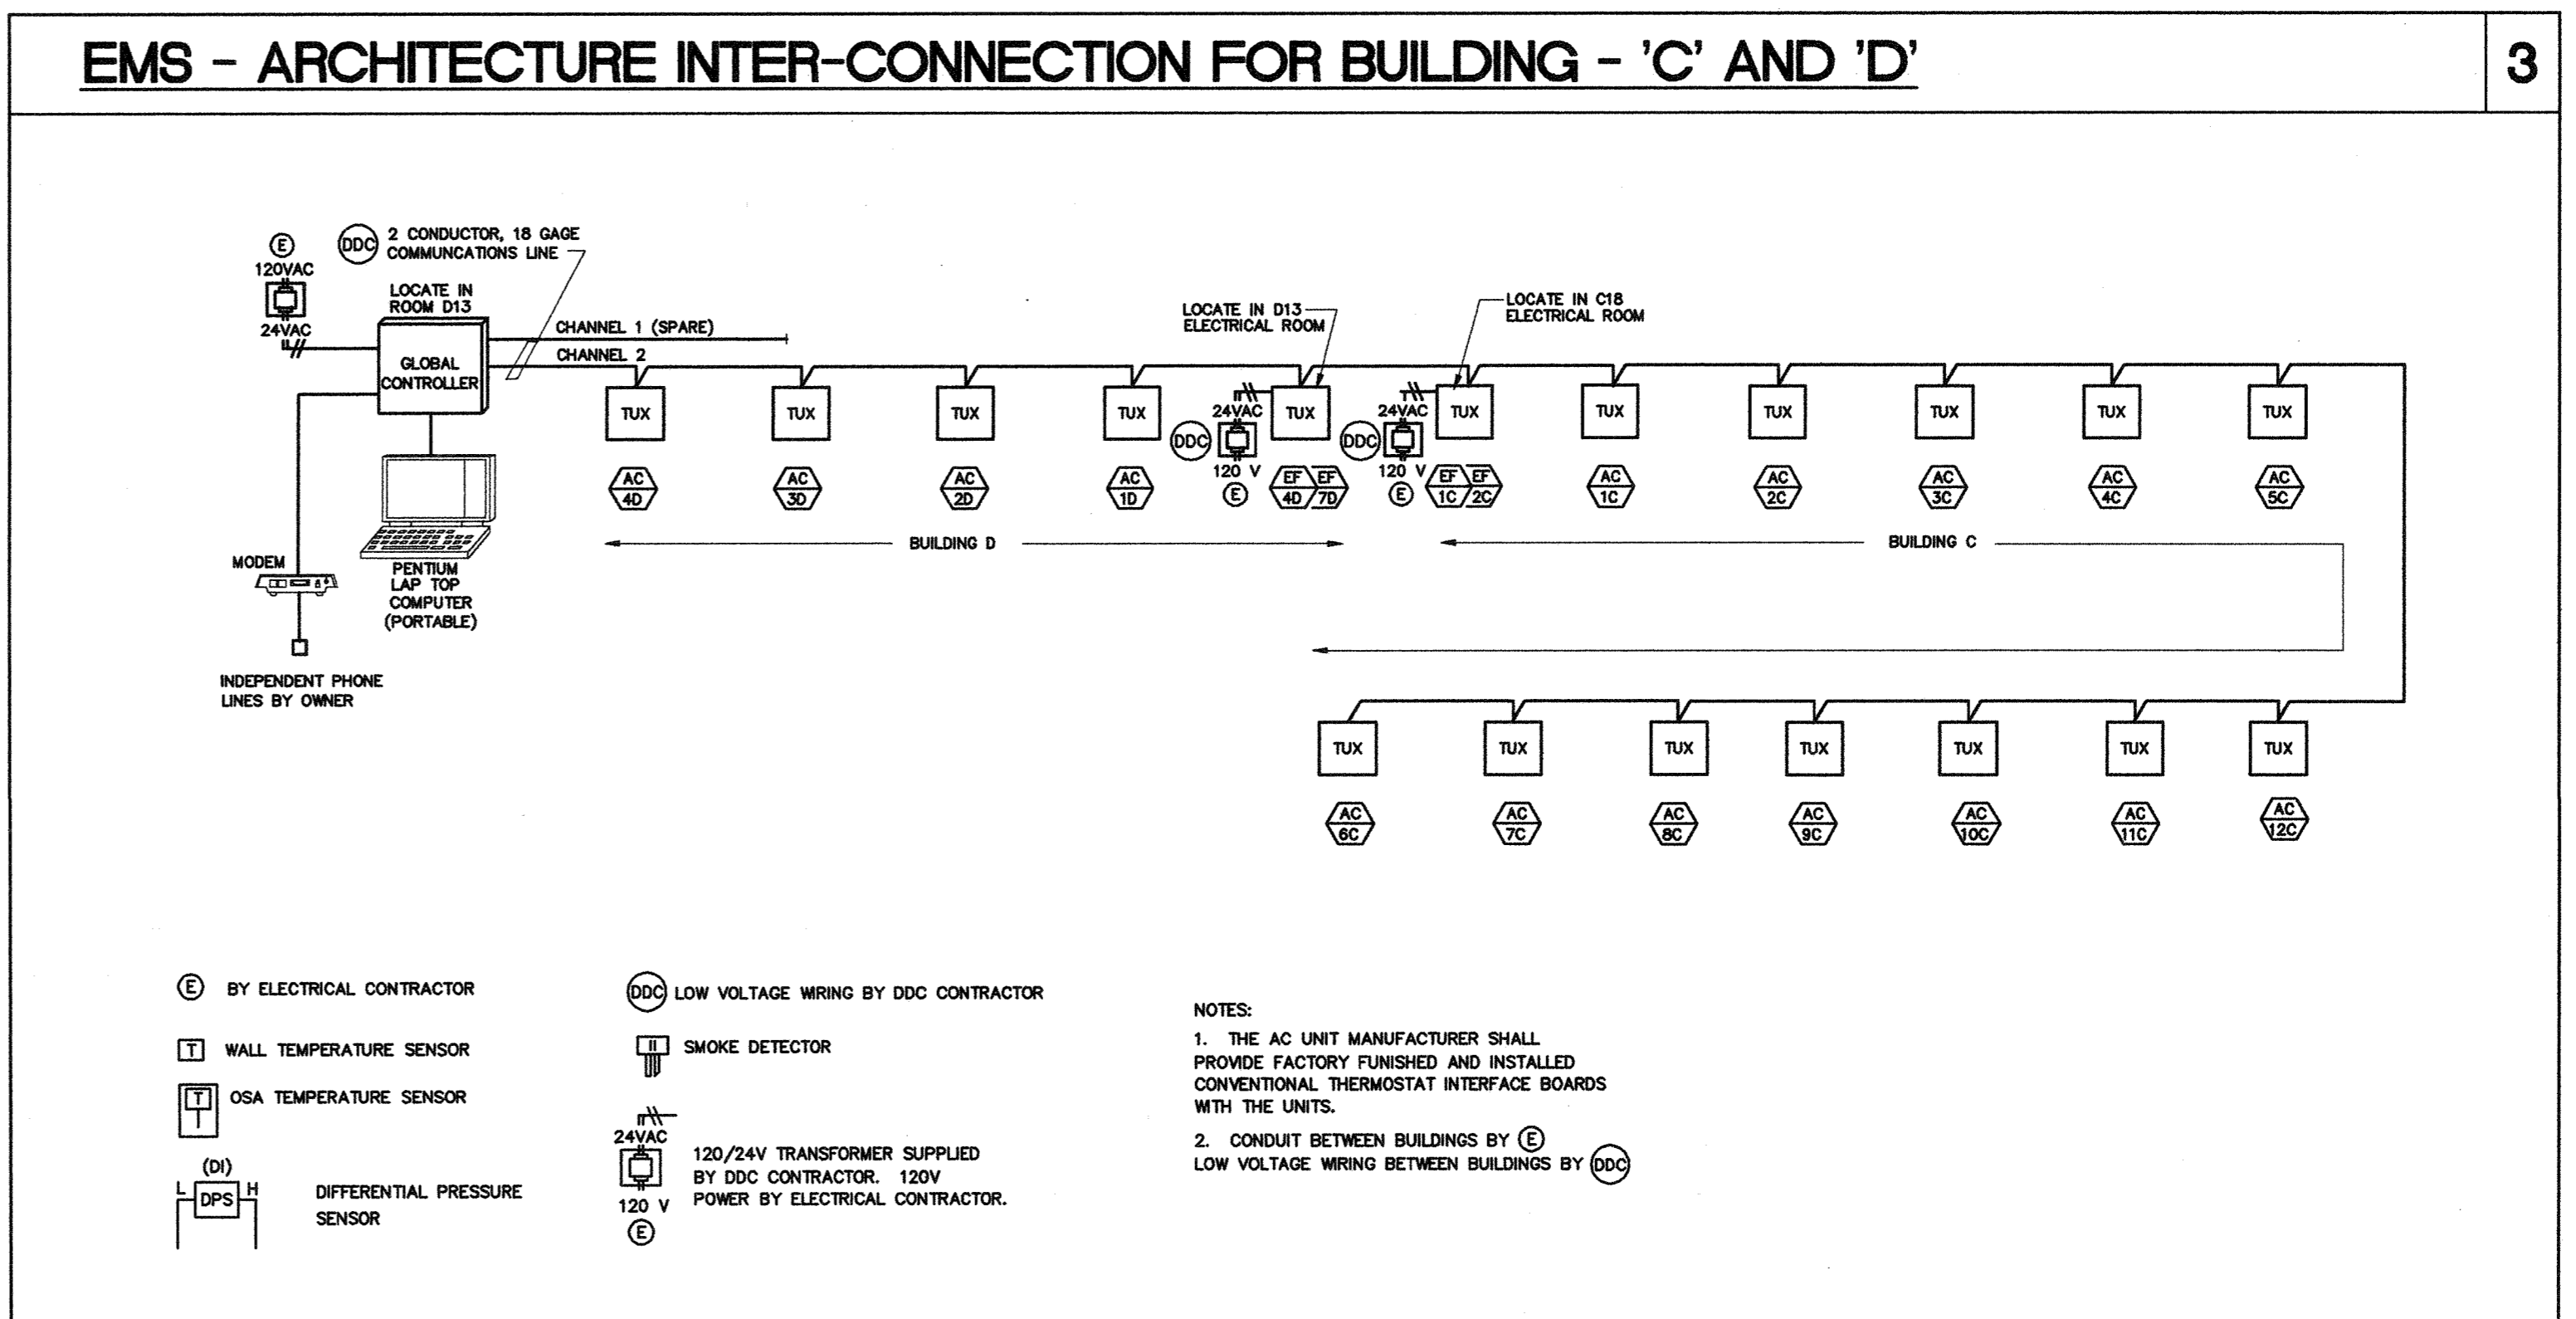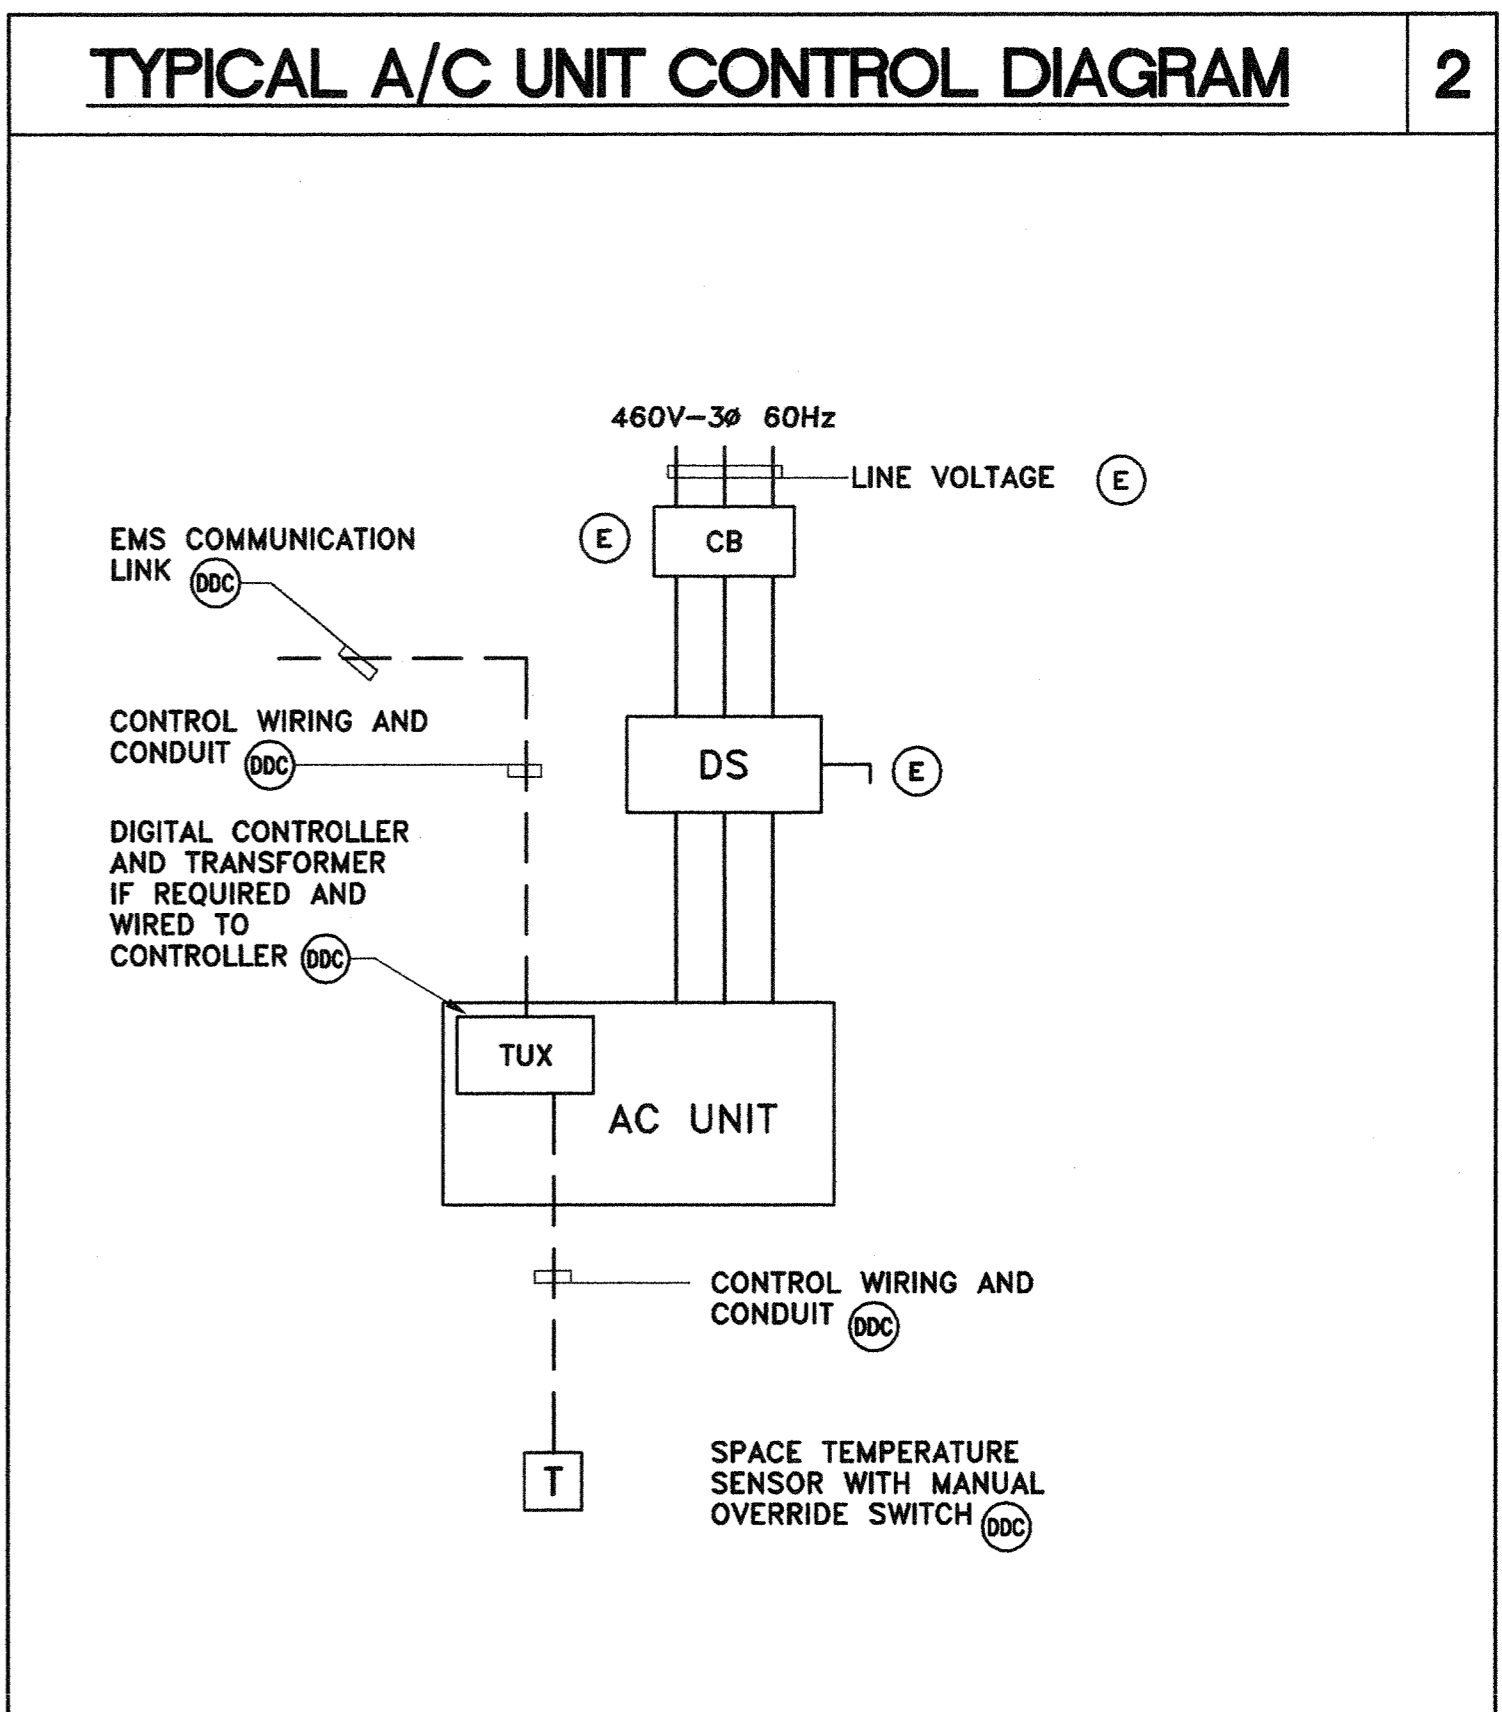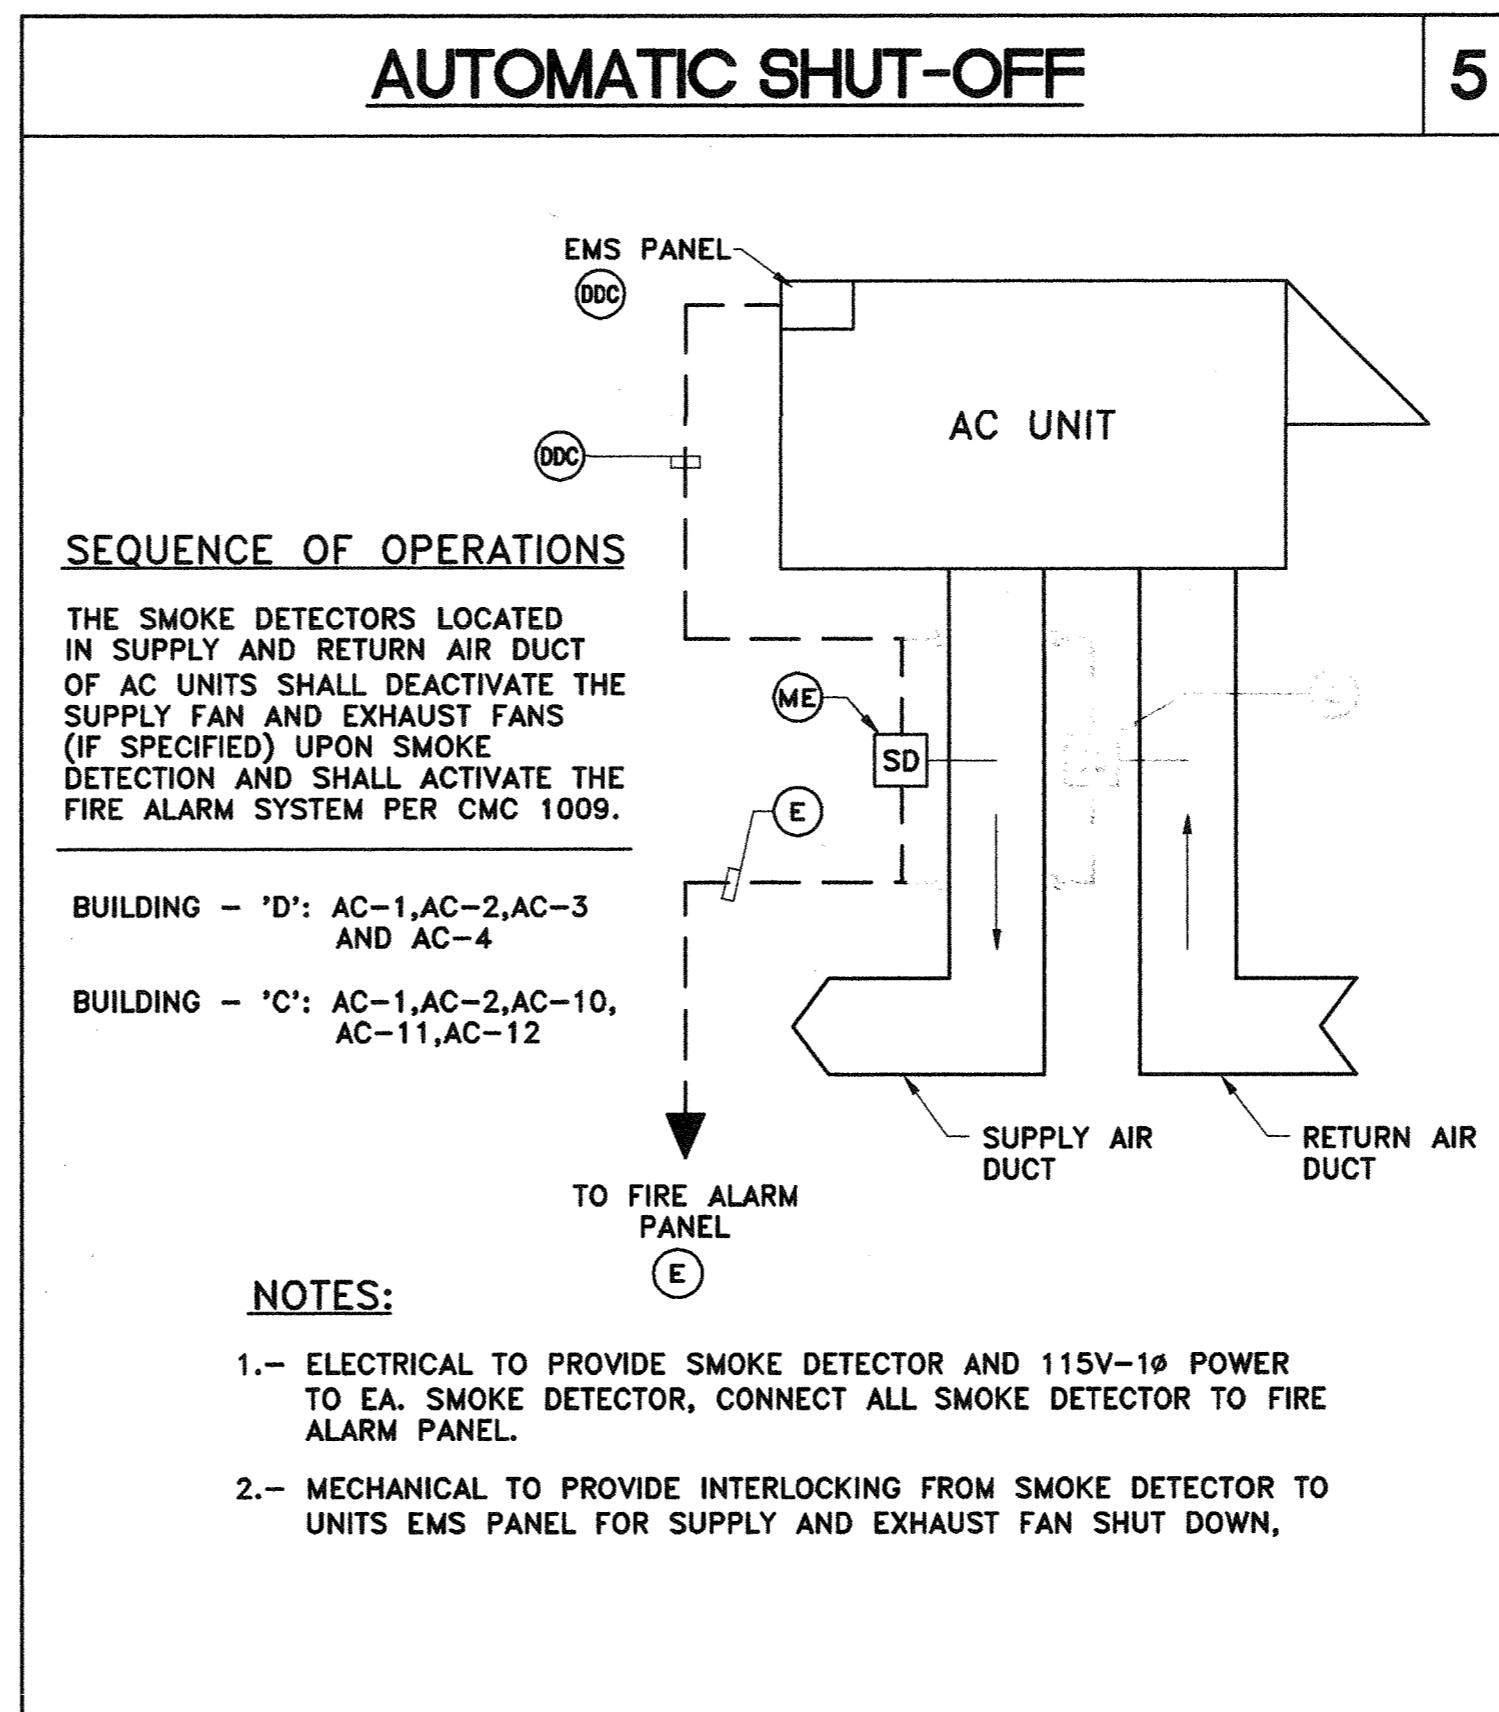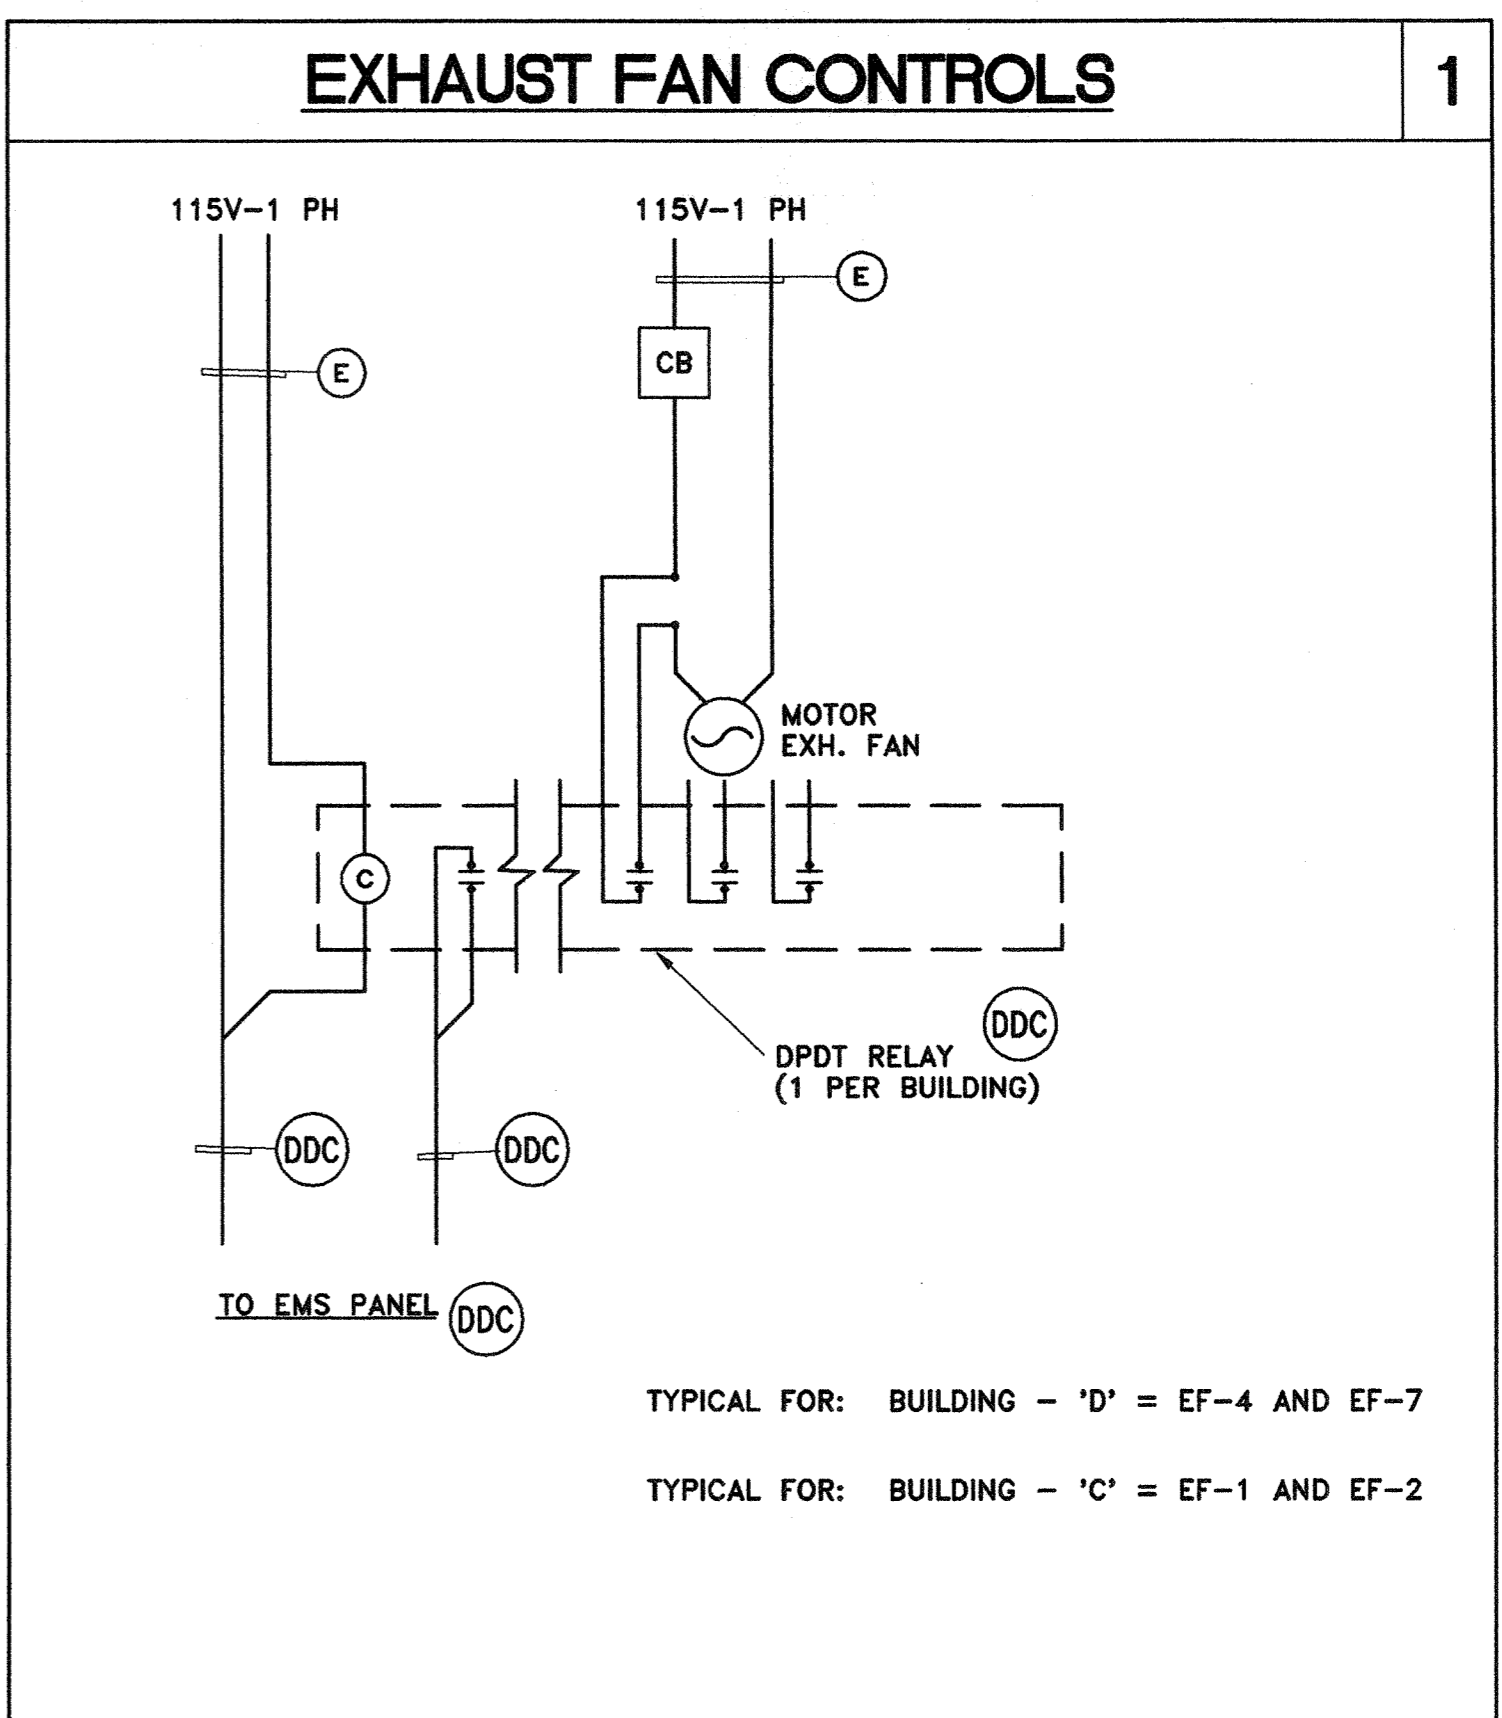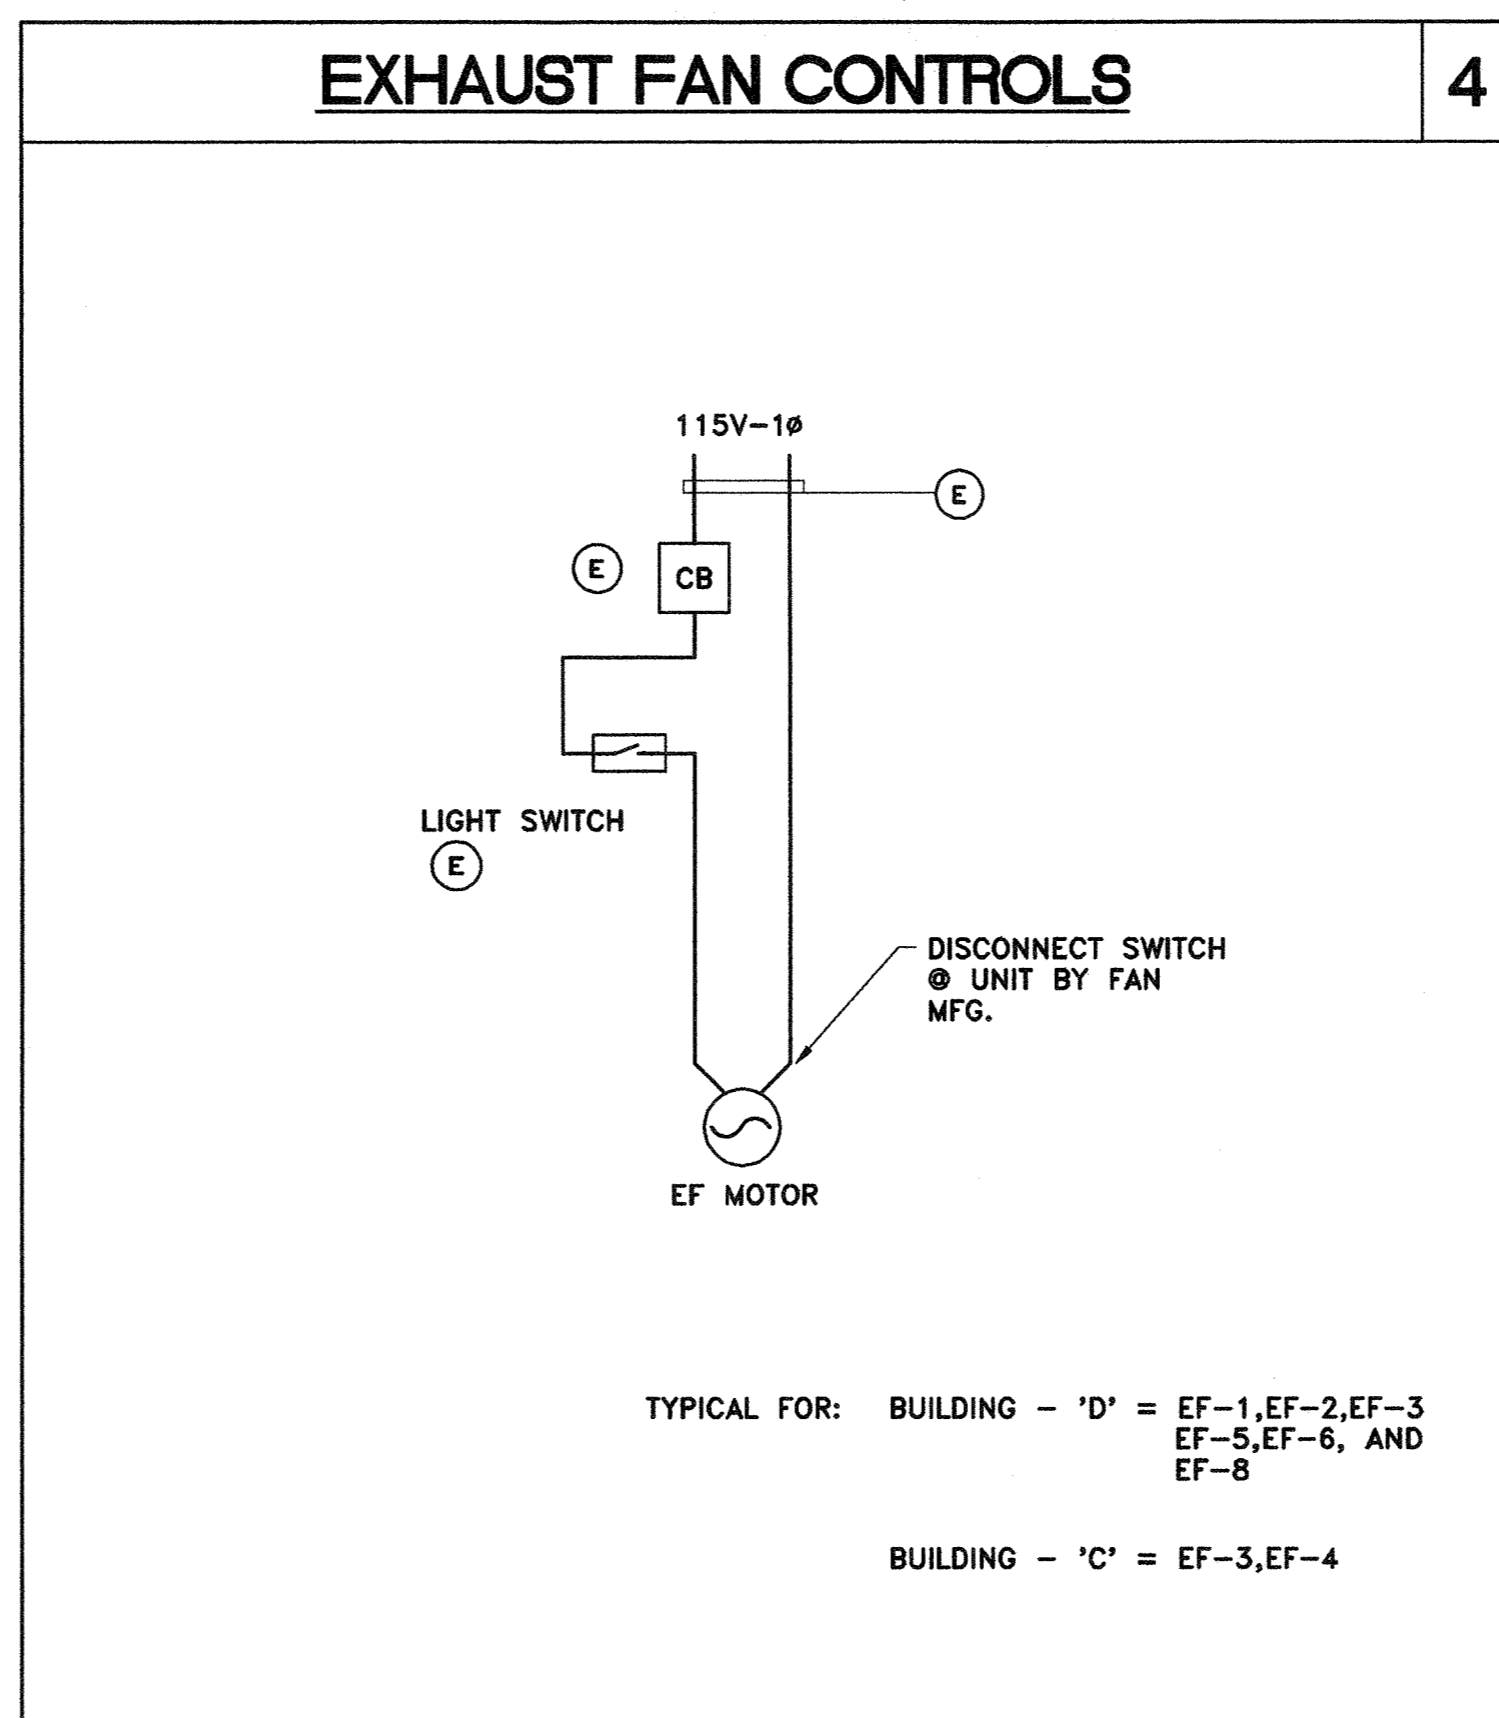

CONSULTANT

MATHAUDHU ENGINEERING, INC.
CONSULTING MECHANICAL ENGINEERS
3833 JURUPA AVENUE
ROVERIDGE, CA 92369-5221
(909) 688-1776 FAX (909) 688-5061

APPROVED

REGISTERED PROFESSIONAL ENGINEER
MATHAUDHU ENGINEERING, INC.
MATHAUDHU, ENGINEERING, INC.
CALIFORNIA # 27118

APPROVED

LICENSED ARCHITECT
No. C-14548
MATHAUDHU ENGINEERING, INC.
CALIFORNIA # 27118

APPROVED

NO	DATE	BY	REMARKS

MECHANICAL CONTROL DIAGRAM and WIRING DIAGRAM

DRAWN M.F.S./J.O.
 CHECKED S.S.M.
 DATE 3/19/97
 SCALE NONE
 JOB NO. 9216400

M0.3

Murrieta Valley Unified School District

Thompson Middle School
 Phase 1 Bligs C&D

CONSULTANT

MATHAUDHU ENGINEERING CONSULTING ENGINEERS (714) 988-1776 3803 BROCKTON AVE., SUITE 2, RIVERSIDE, CA 92501

APPROVED

APPROVED

APPROVED











APPL 6116/67
 6/16/97

NO	DATE	BY	REMARKS

DETAILS

DRAWN BS
 CHECKED BS
 DATE 3-19-97
 SCALE NONE
 JOB NO. 926420

MO.4

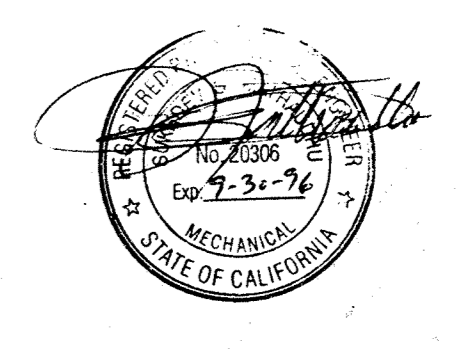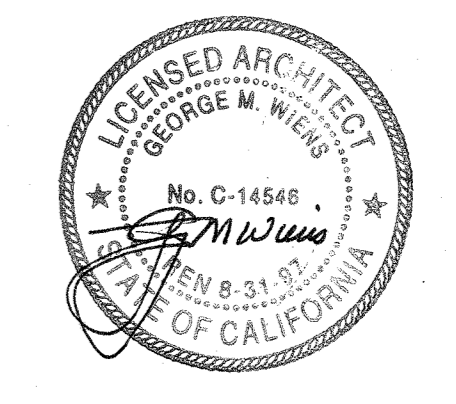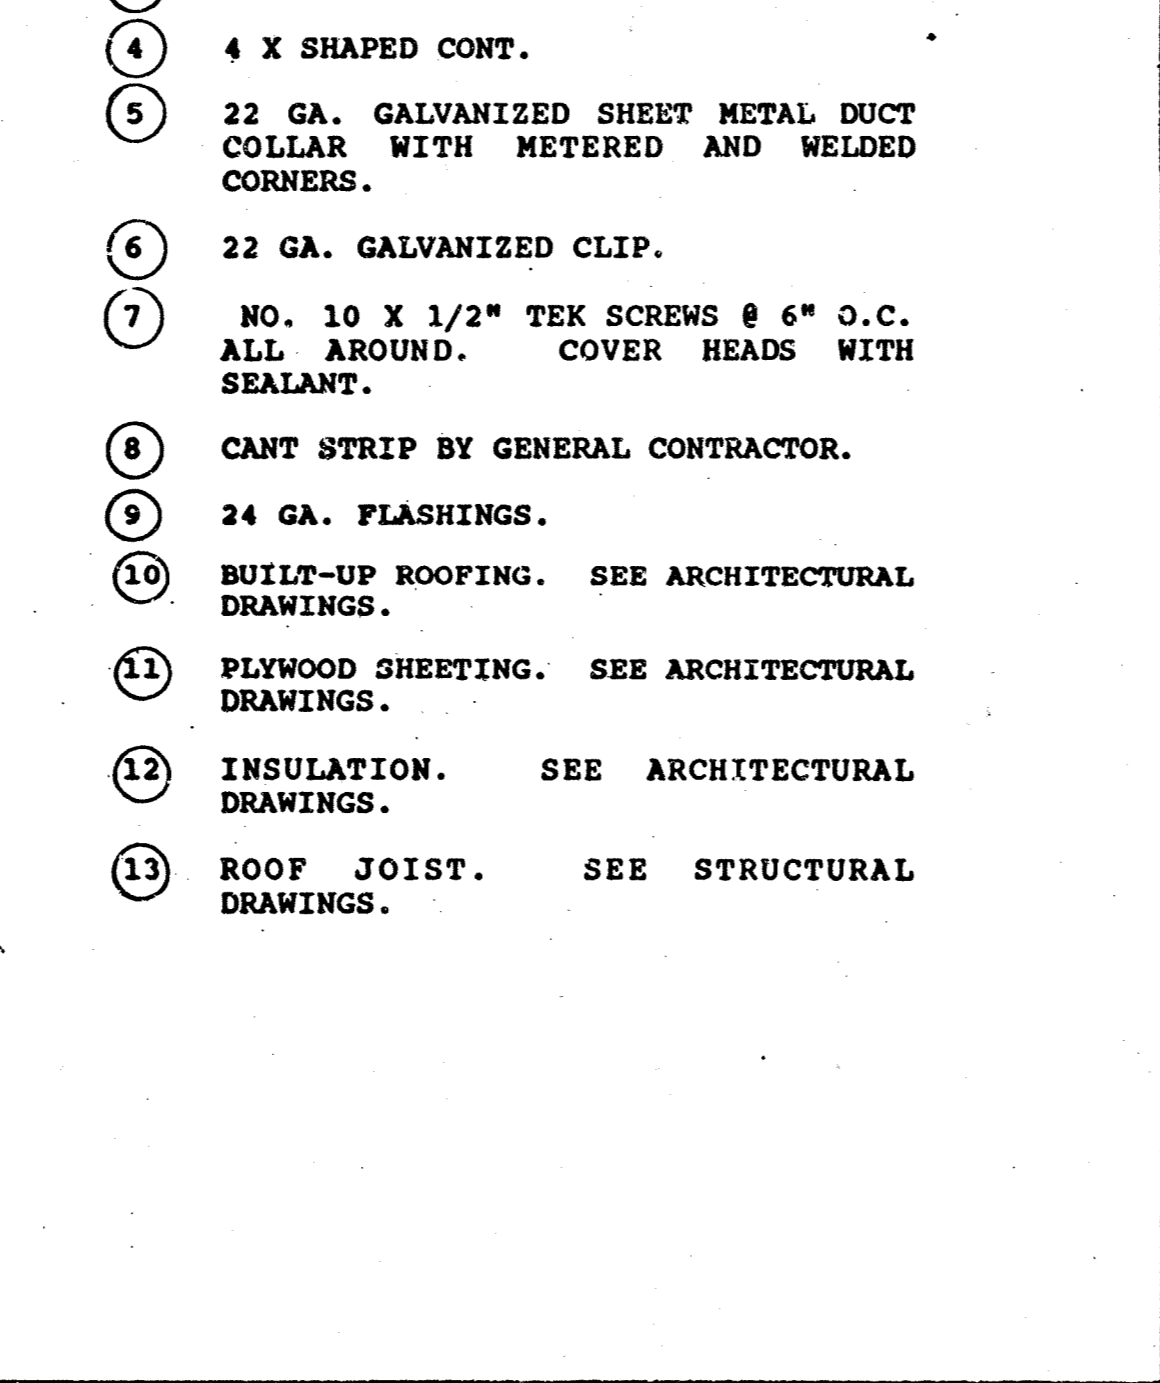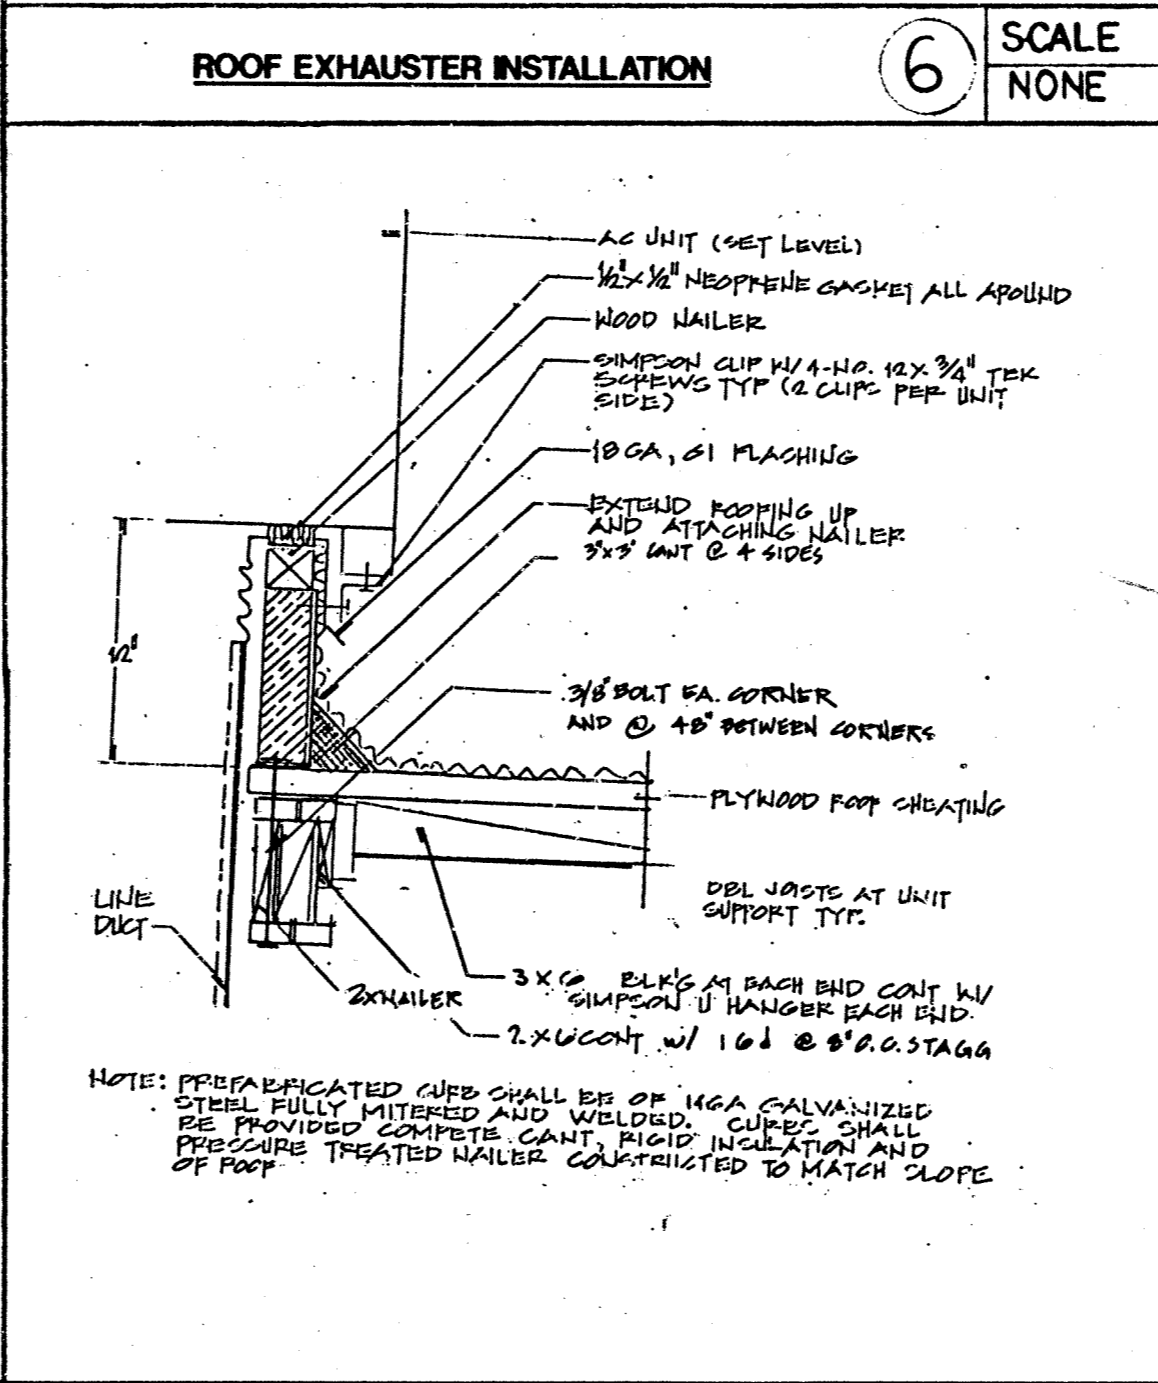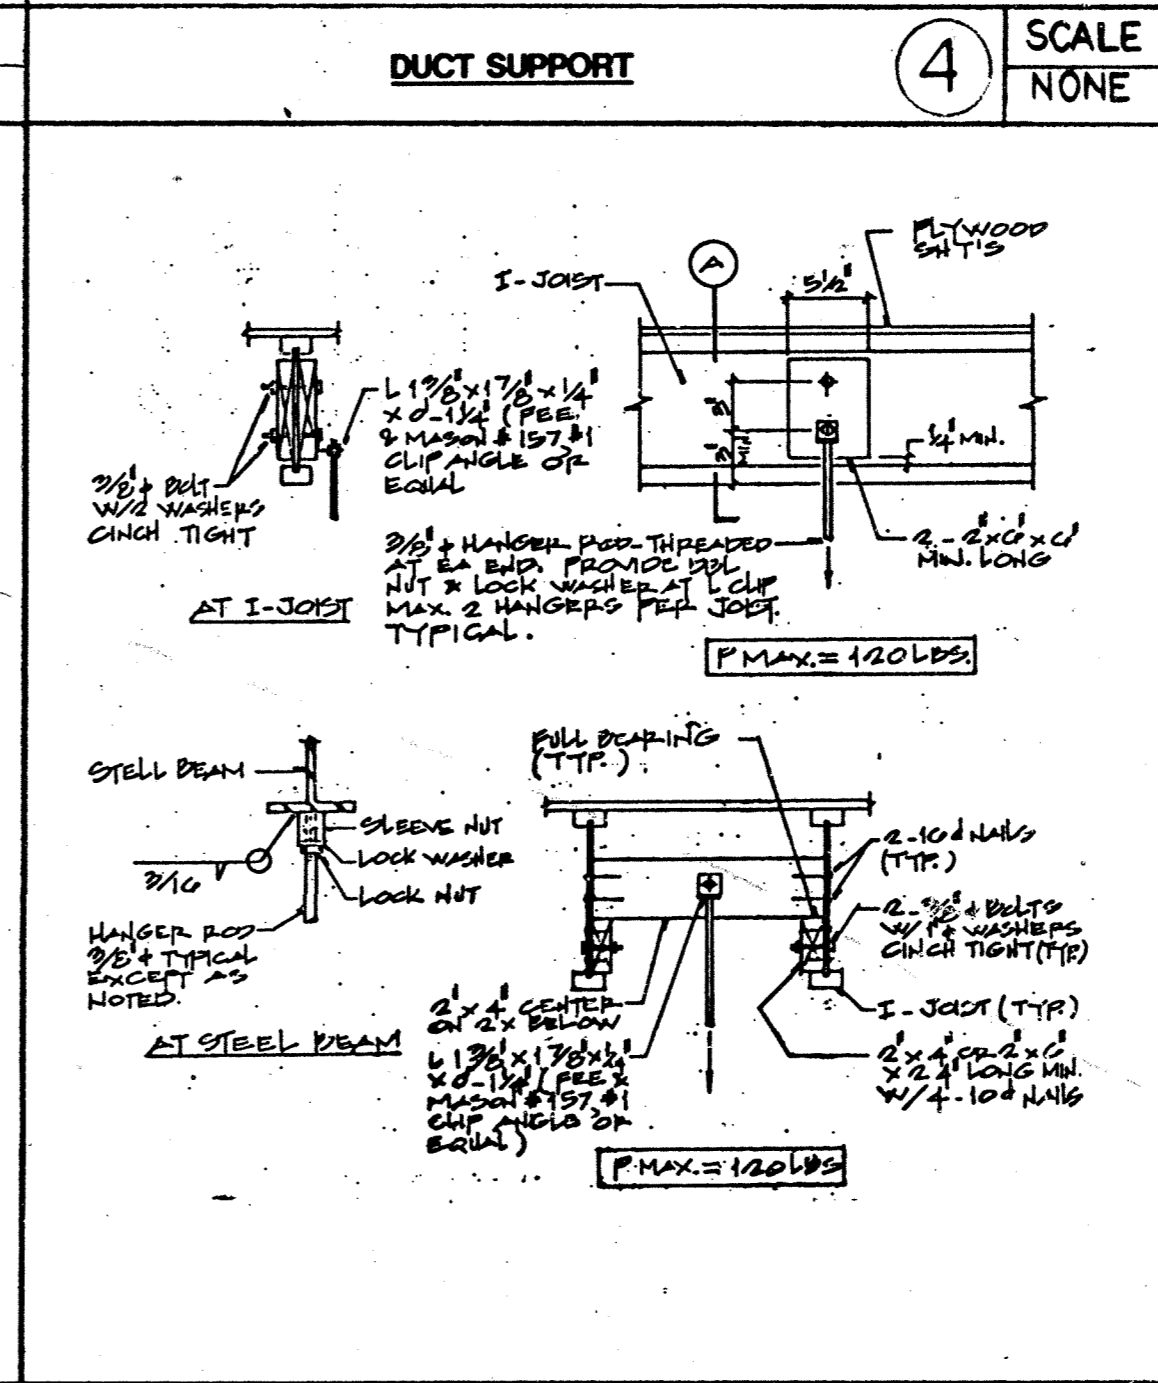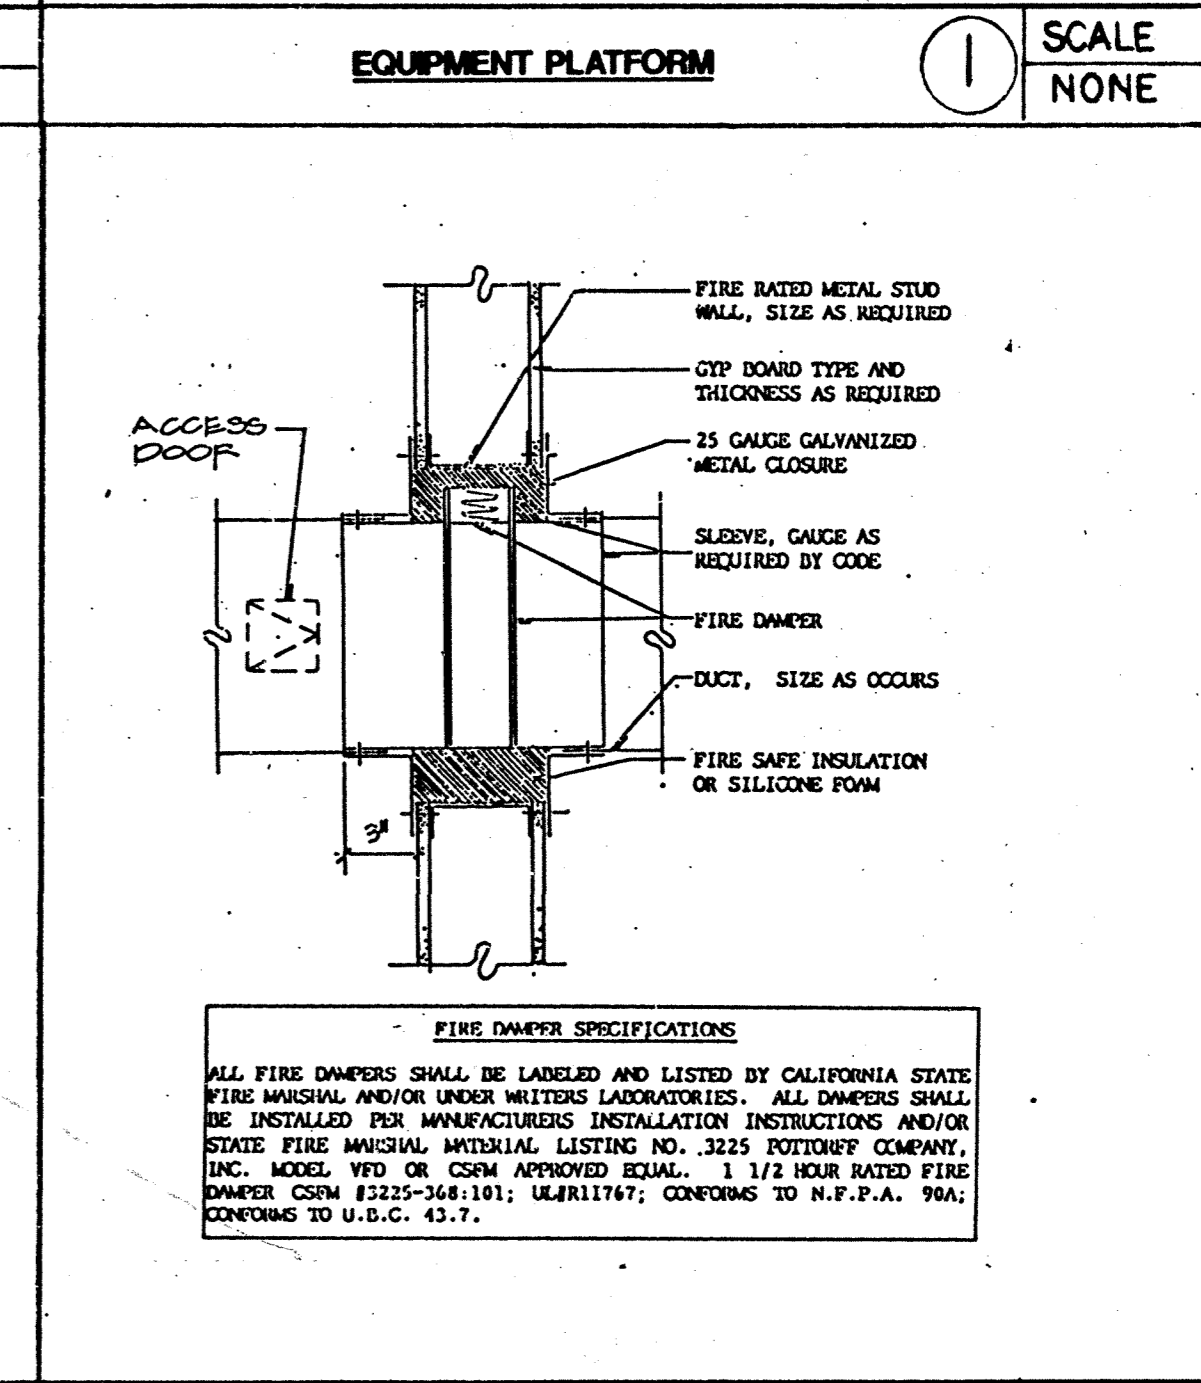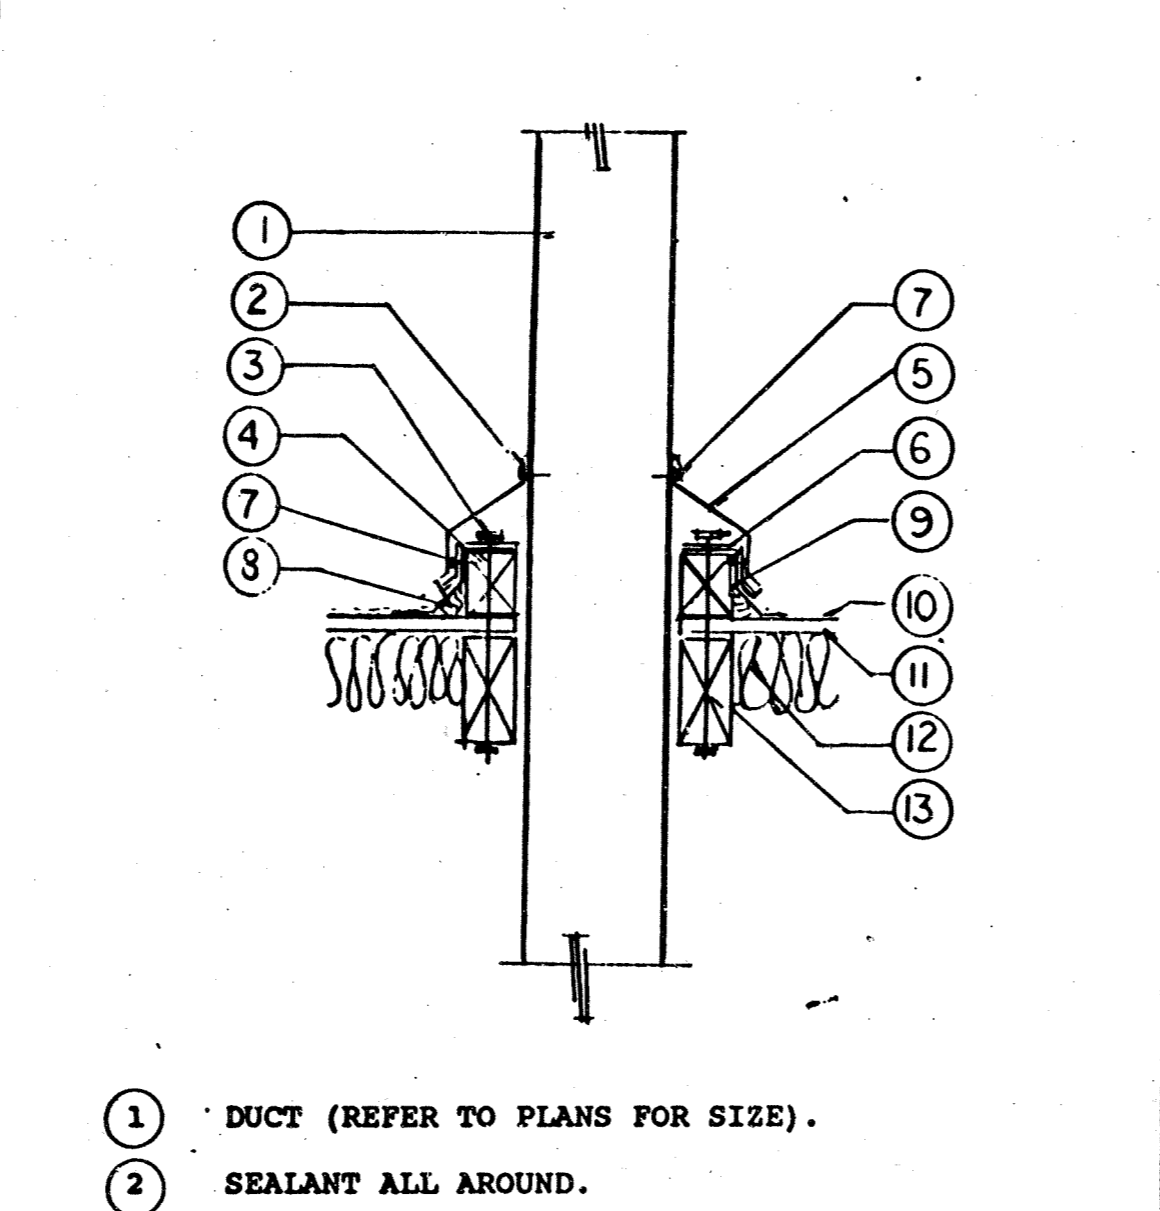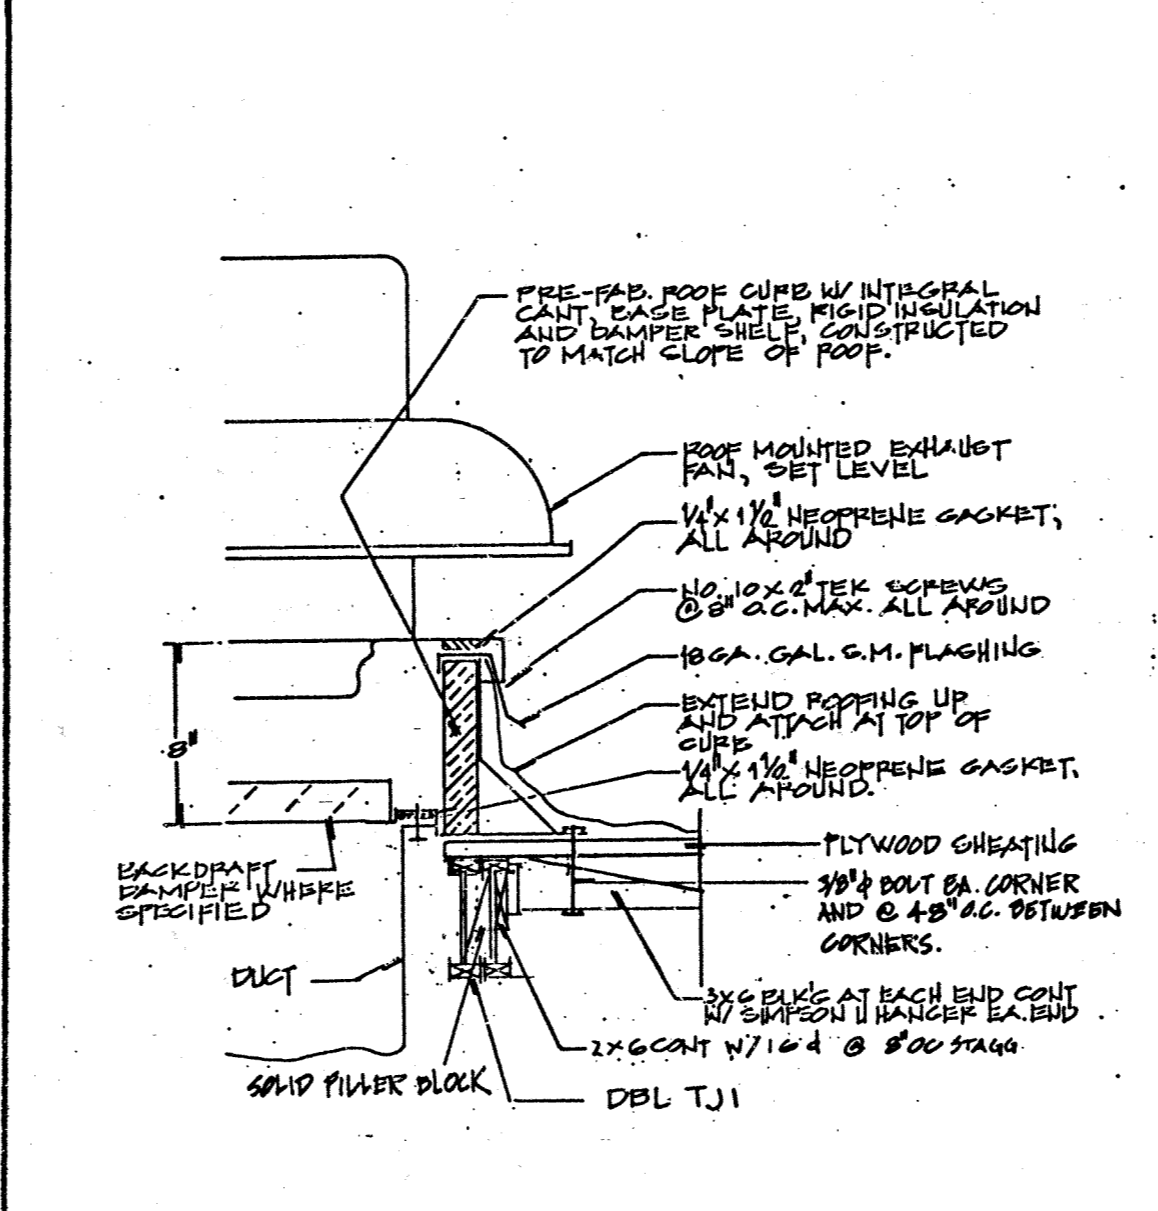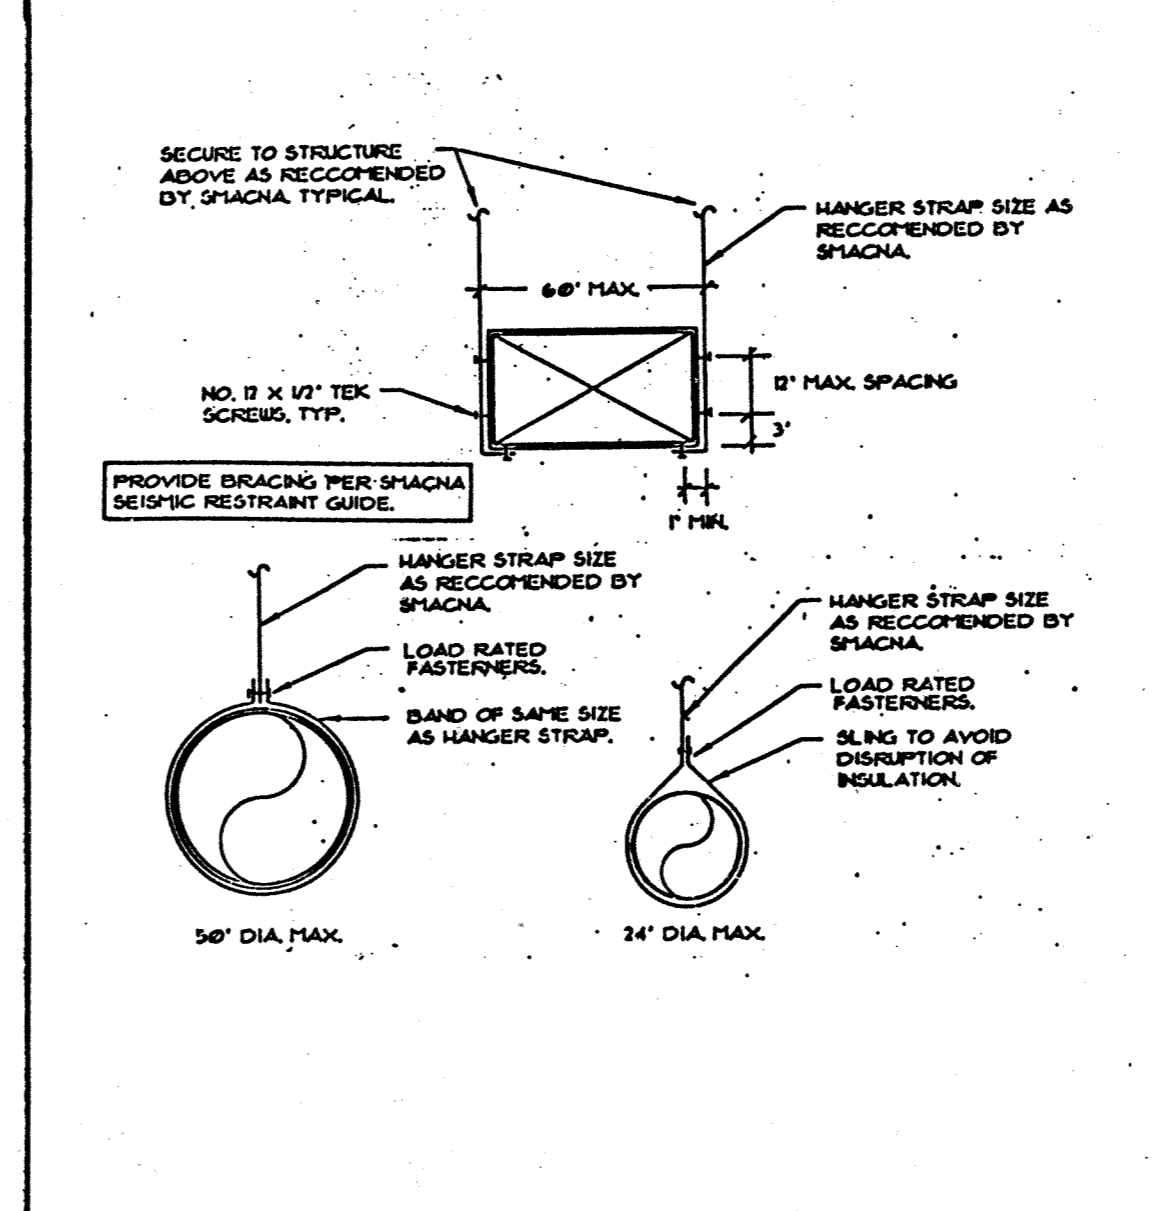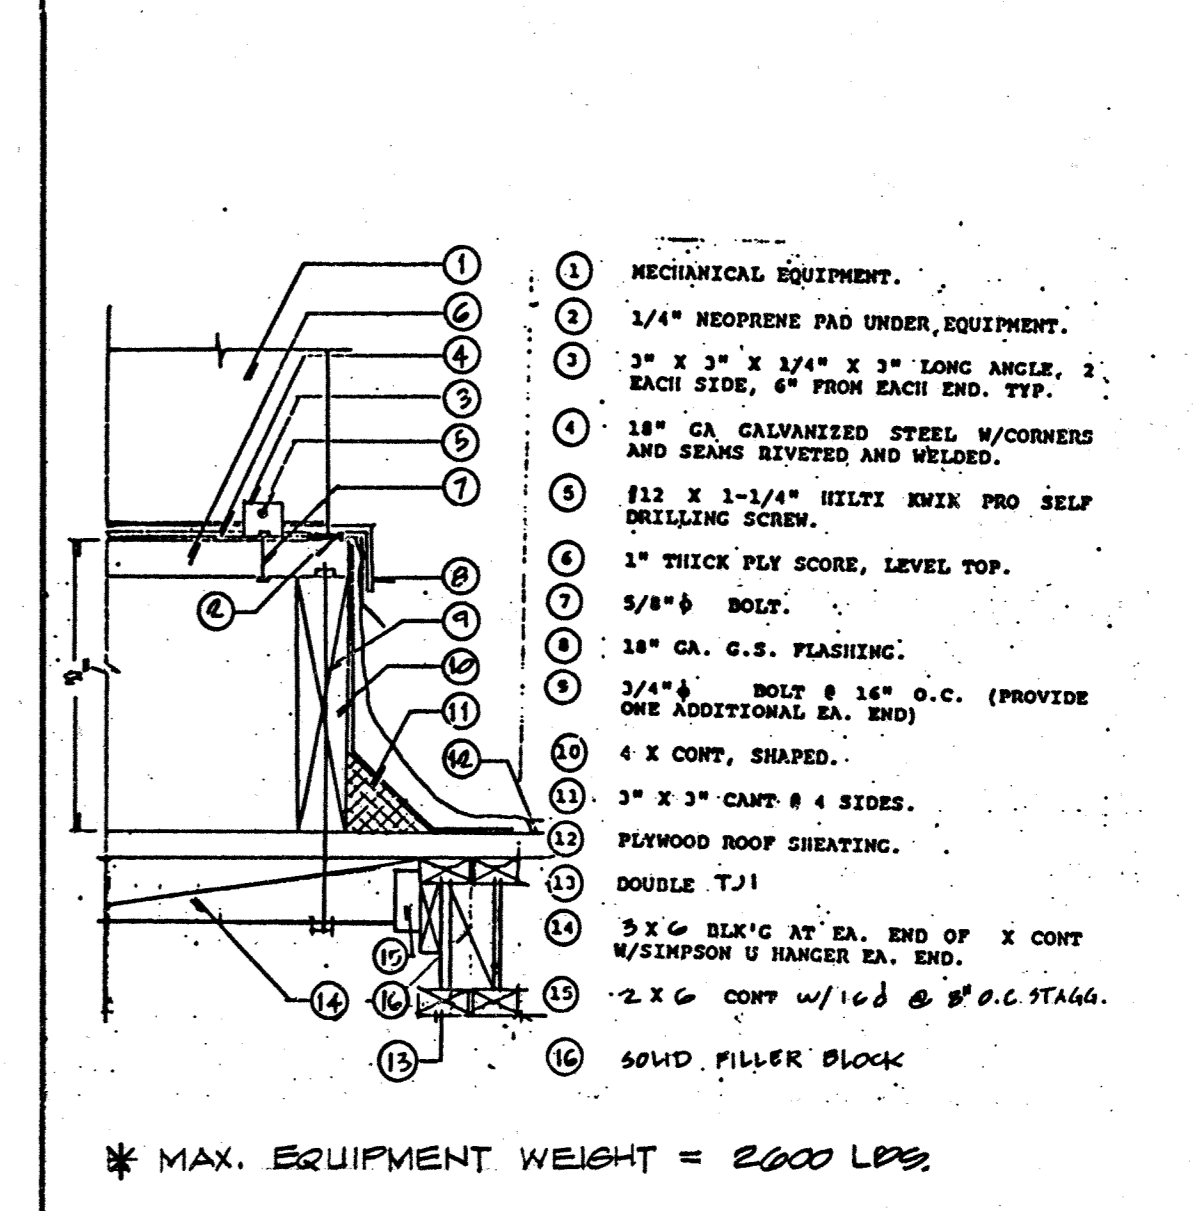

Murrieta Valley Unified School District

Thompson Middle School
 Phase 1
 Bldgs C&D

CONSULTANT
 MATHAUDHU ENGINEERING, INC.
 CONSULTING MECHANICAL ENGINEERS
 3803 BROOKTON AVE., SUITE 2, RIVERSIDE, CA 92501
 (951) 958-1778 FAX (951) 958-0891

APPROVED

APPROVED
 J. M. W. W. ARCHITECT
 C-14546
 STATE OF CALIFORNIA

APPROVED
 IDENTIFICATION STAMP
 DIV. OF THE STATE ARCHITECT
 OFFICE OF REGULATION SERVICES
 APPL 6167
 AC DATE 11/19/97
 DATE 11/19/97

NO	DATE	BY	REMARKS

BUILDING 'C' MECHANICAL FLOOR PLAN


DRAWN CCB/BTS
 CHECKED SSM
 DATE 2-19-97
 SCALE AS NOTED
 JOB NO. 216400
M1.C

ROOM NAMES

- C01 WOOD SHOP
- C02 INDUSTRIAL TECHNOLOGY LAB
- C03 STORAGE
- C04 AUDIO PRODUCTION ROOM
- C05 VIDEO PRODUCTION ROOM
- C06 WOOD SHOP
- C07 INDUSTRIAL TECHNOLOGY LAB
- C08 SCIENCE LAB
- C09 CORRIDOR
- C10 ARTS/RAFT CLASSROOM
- C11 STORAGE
- C12 KILN ROOM
- C13 STORAGE
- C14 ARTS/RAFT CLASSROOM
- C15 PREF ROOM
- C16 GIRL'S RESTROOM
- C17 WOMEN'S TOILET
- C18 ELECTRICAL ROOM
- C19 MEN'S TOILET
- C20 STAFF WORKROOM
- C21 SCIENCE PREF ROOM
- C22 BOYS' RESTROOM
- C23 CORRIDOR
- C24 SCIENCE LAB
- C25 SCIENCE LAB
- C26 SCIENCE LAB
- C27 SCIENCE LAB
- C28 CORRIDOR
- C29 CHANGE ROOM
- C30 MODERN LIVING CLASSROOM
- C31 COMPUTER LAB
- C32 SCIENCE LAB


REFERENCE NOTES

- 1 26" X 12" LINED SUPPLY AIR DUCT UP TO UNIT ON ROOF. PROVIDE TRANSITIONS AS REQUIRED AND CONNECT TO UNIT WITH FLEXIBLE CONNECTOR.
- 2 24" X 12" LINED RETURN AIR DUCT UP TO UNIT ON ROOF. PROVIDE TRANSITIONS AS REQUIRED AND CONNECT TO UNIT WITH FLEXIBLE CONNECTOR.
- 3 30" X 14" LINED SUPPLY AIR DUCT UP TO UNIT ON ROOF. PROVIDE TRANSITIONS AS REQUIRED AND CONNECT TO UNIT WITH FLEXIBLE CONNECTOR.
- 4 30" X 12" LINED RETURN AIR DUCT UP TO UNIT ON ROOF. PROVIDE TRANSITIONS AS REQUIRED AND CONNECT TO UNIT WITH FLEXIBLE CONNECTOR.
- 5 38" X 16" LINED SUPPLY AIR DUCT UP TO UNIT ON ROOF. PROVIDE TRANSITIONS AS REQUIRED AND CONNECT TO UNIT WITH FLEXIBLE CONNECTOR.
- 6 36" X 16" LINED RETURN AIR DUCT UP TO UNIT ON ROOF. PROVIDE TRANSITIONS AS REQUIRED AND CONNECT TO UNIT WITH FLEXIBLE CONNECTOR.
- 7 9" Ø EXHAUST DUCT UP THRU ROOF JACK. PROVIDE TRANSITIONS AS REQUIRED AND CONNECT TO EXHAUST FAN WITH FLEXIBLE CONNECTOR.
- 8 8" Ø EXHAUST DUCT UP THRU ROOF AND TERMINATE 12" ABOVE ROOF WITH WEATHER CAP WITH BOTTOM OF DUCT CAPPED @ 18" ABOVE FINISHED FLOOR. PROVIDE 2 - 6" Ø BRANCHES TO MAIN DUCT OF 6" LONG AT BOTH SIDE AS INDICATED ON DWG. FOR FUTURE CONNECTION TO KILN BY OTHERS. BOTTOM OF BRANCHES SHALL BE 12" ABOVE BOTTOM OF MAIN EXHAUST DUCT.
- 9 SIDEWALL ADJUSTABLE LINEAR SLOT SUPPLY REGISTER. REGISTER SHALL MEET ALL THE FOLLOWING CHARACTERISTICS: SURFACE MOUNT, 3 - 3/4" WIDE SLOTS, LENGTH = 2', AIRFLOW = 75 CFM/FT., NC = 30. DIFFUSER SHALL BE METALAIR, SERIES 6000.
- 10 SIDEWALL ADJUSTABLE LINEAR SLOT RETURN REGISTER. REGISTER SHALL MEET ALL THE FOLLOWING CHARACTERISTICS: SURFACE MOUNT, 3 - 3/4" WIDE SLOTS, LENGTH = 2'. REGISTER SHALL BE METALAIR, SERIES 6000.
- 11 12" Ø EXHAUST DUCT IN RATED DUCT SHAFT (BY ARCH., SEE DETAIL 23/A8-5) CONNECTED TO FINE HOOD AND UP TO EXHAUST FAN ON ROOF. (SEE FLOOR PLAN FOR DUCT LAYOUT). CONNECT DUCT TO EXHAUST FAN ON ROOF WITH CORROSION RESISTANT FLEXIBLE CONNECTOR WITH WEATHER COVER. EXTEND DUCT CONNECTED TO EXHAUST FAN OPENING UP TO 7'-0" MIN. ABOVE FINISH ROOF WITH CONCENTRIC DUCT SELF-DRAINING STACK. PROVIDE WIRE GUIDES (3) Ø 4'-0" ABOVE FINISH FLOOR. EXHAUST DUCT INCLUDING SCREWS FASTENER AND ALL OTHER ACCESSORIES WHICH ARE IN CONTACT WITH AIR STREAM SHALL BE OF TYPE 316 STAINLESS STEEL CONSTRUCTION. ALL DUCT CONNECTOR SHALL BE LEAK PROOF.
- 12 EXHAUST FAN SHALL BE ON PLATFORM WITH VIBRATION ISOLATOR AS PER MFR. RECOMMENDATION.

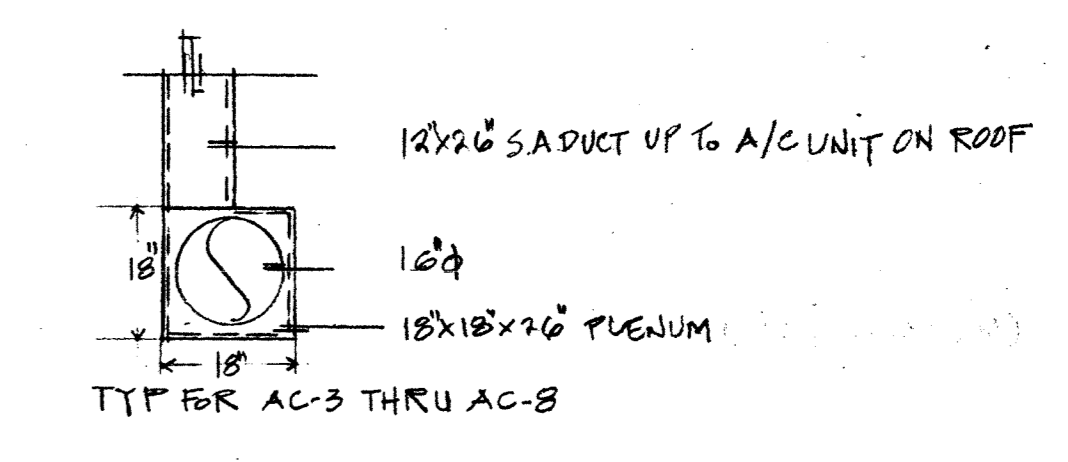

12x6 S A DUCT UP TO A/C UNIT ON ROOF
 12x6 PLENUM
 1/2" FOR AC-3 THRU AC-8
 DUCT AND PLENUM SIZES INDICATED ARE WITHOUT LININGS. ADD 1/2" THICK TO ACHIEVE AT REQUIRED CLEARANCE.
S A DUCT PLENUM

DETAIL NTS 2

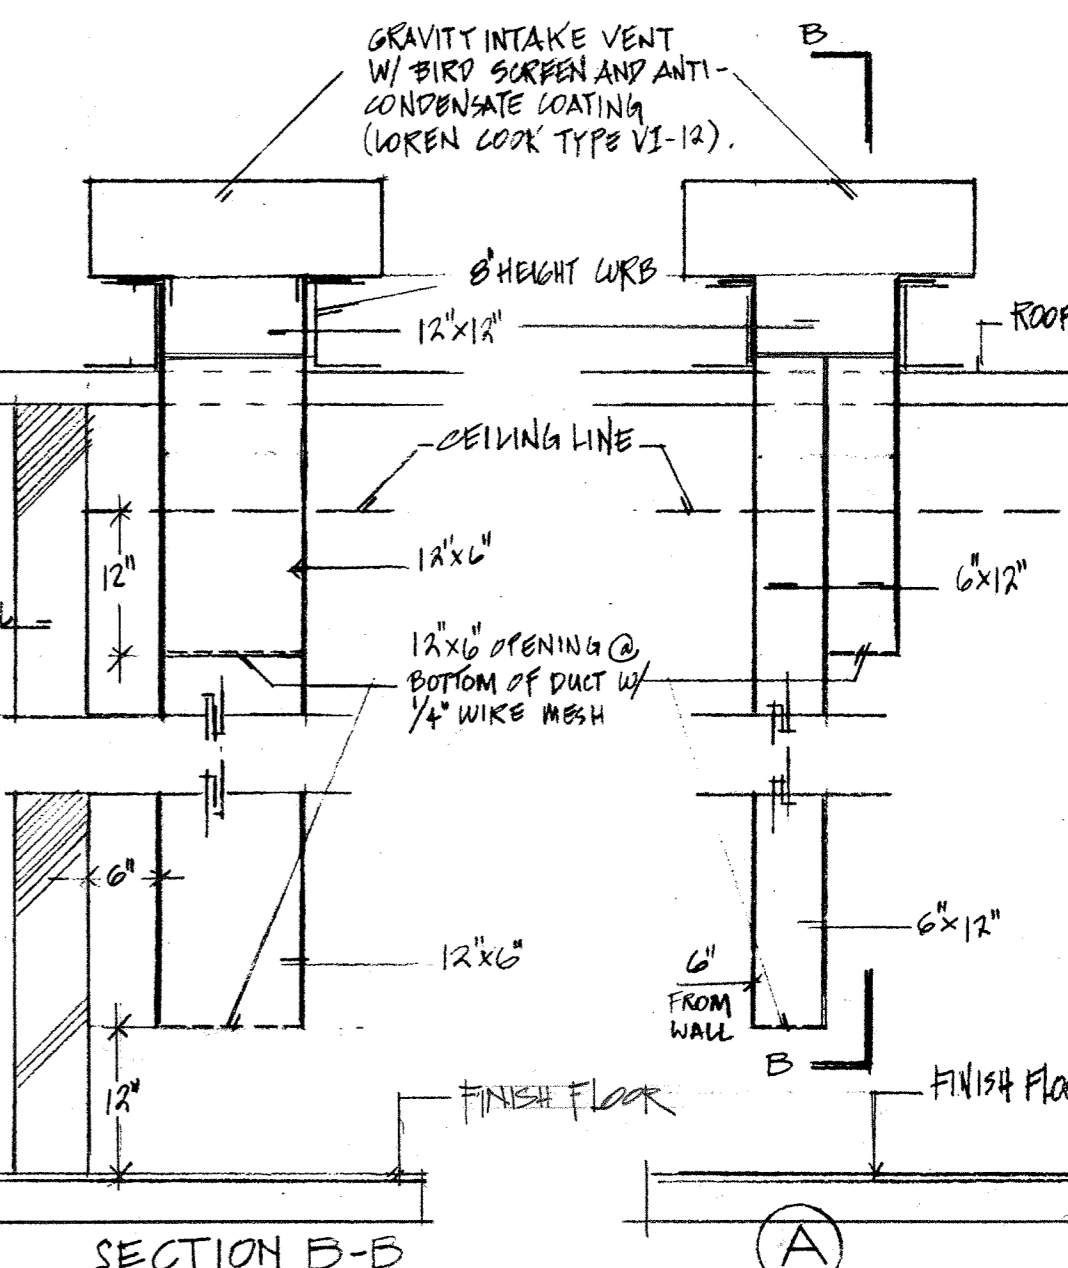


COMBUSTION AIR DUCT
 SECTION B-B
DETAIL NTS 1

COMBINATION WALL FIRE SMOKE DAMPER: (WPSD)
 DAMPER SHALL BE COMPLETE WITH ELECTRICAL ACTUATOR MODEL 5800-MB2 (CSFM #7481-3 68:5), 120V-60WATTS, AND DUCT SMOKE DETECTOR MODEL DM400ADC (CSFM #240-447-120) WITH RESETTABLE BI-METALLIC LINK. DAMPER SHALL BE POTTORFF SERIES 5020-1.
 DAMPER SHALL BE INSTALLED PER MANUFACTURERS INSTALLATION INSTRUCTIONS AND CSFM #3225-368:008 AND 3230-368:105, UL #R11767.


GENERAL NOTES

1. ALL TRANSFER DUCTS SHALL BE LINED WITH 1" THICK DUCT LINER INSULATION.
2. ALL EXTERIOR DOOR LOUVERS SHALL BE PROVIDED WITH SCREEN. SEE ARCHITECTURAL DRAWINGS.
3. ALL EXTERIOR DUCTWORK SHALL BE WEATHERPROOF AND SEALED TO FORM A POSITIVE AIR AND WATERTIGHT SEAL.

BUILDING 'C' FLOOR PLAN

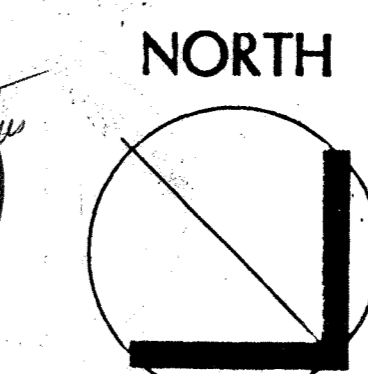

1/8" = 1'-0" A

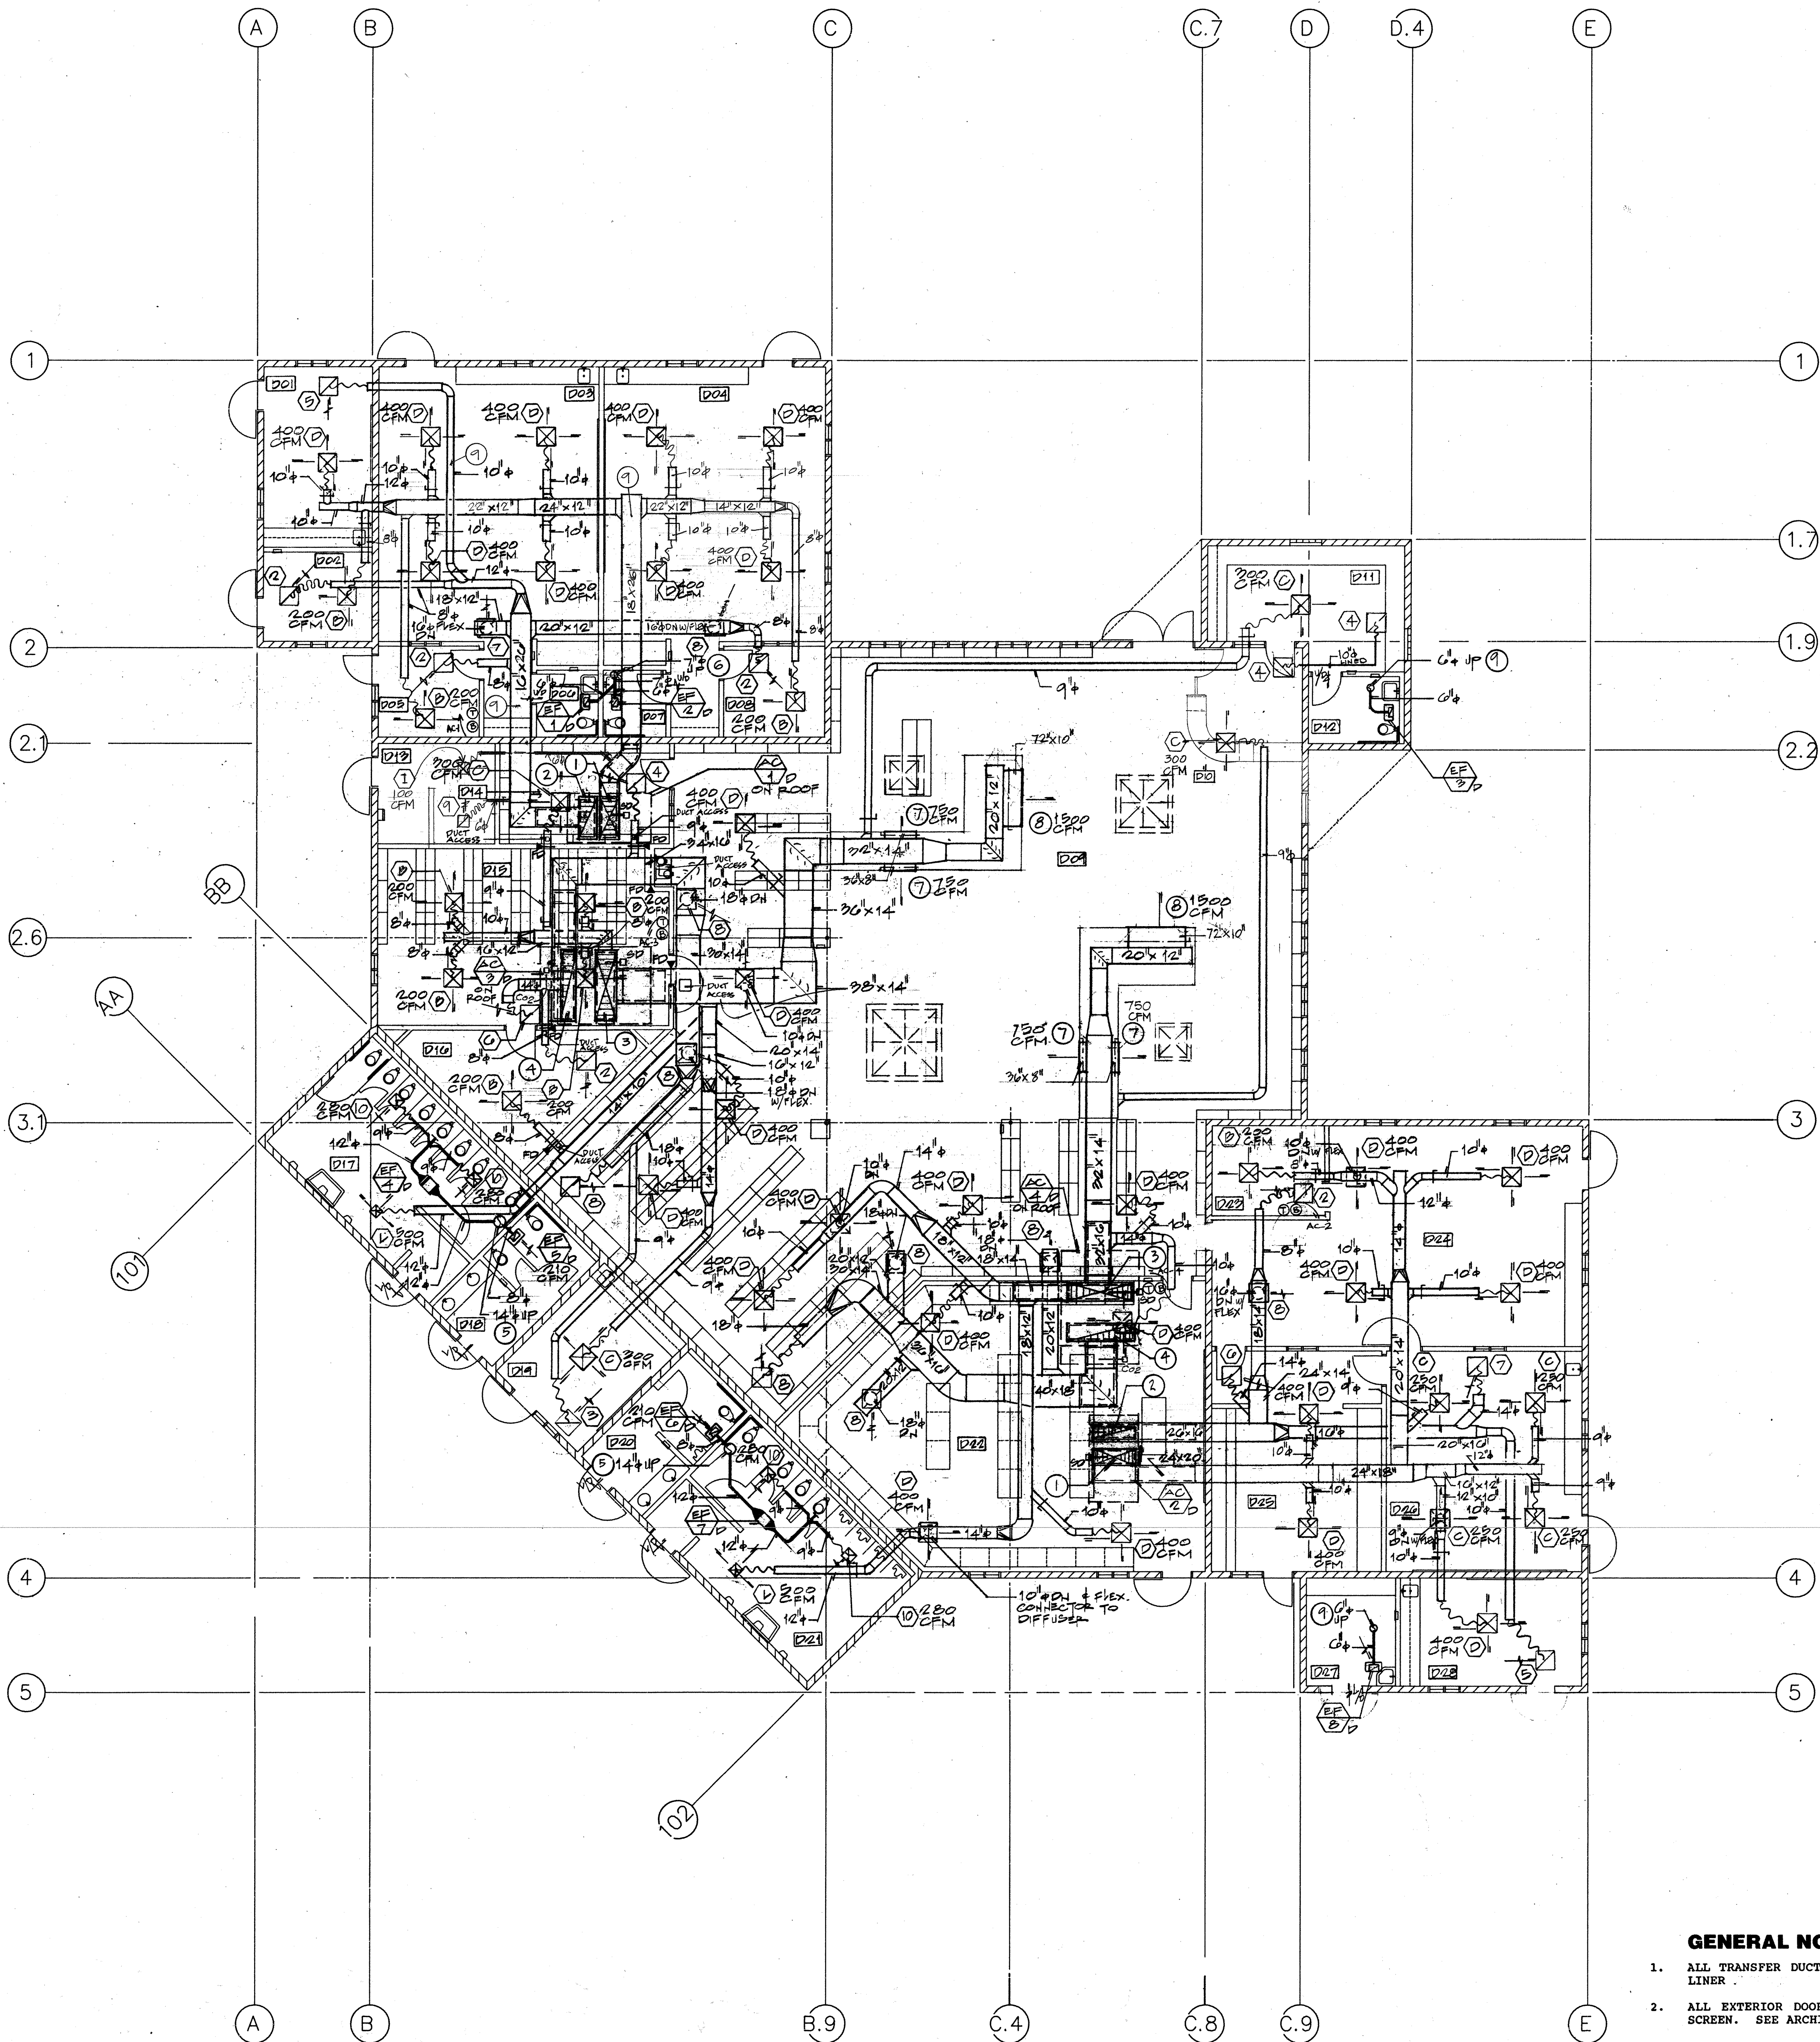

ROOM NAMES


- D01 STAFF WORKROOM
- D02 CAMPUS SUPERVISORS' OFFICE
- D03 SPECIAL EDUCATION CLASSROOM
- D04 SPECIAL EDUCATION CLASSROOM
- D05 STAFF WORKROOM
- D06 TOILET
- D07 TOILET
- D08 STAFF WORKROOM
- D09 LIBRARY
- D10 CHECK-OUT COUNTER
- D11 LIBRARIANS WORKROOM
- D12 TOILET
- D13 ELECTRICAL ROOM
- D14 PROFESSIONAL LIBRARY
- D15 AUDIO/VISUAL/TEXTBOOK STORAGE
- D16 PERIODICAL STORAGE
- D17 GIRLS' RESTROOM
- D18 WOMEN'S RESTROOM
- D19 STAFF WORKROOM
- D20 MEN'S RESTROOM
- D21 BOYS' RESTROOM
- D22 COMPUTER LAB
- D23 TESTING ROOM
- D24 RESOURCE SPECIALIST PROGRAM OFFICE
- D25 AUDIO/COMPUTER ROOM
- D26 INSTRUCTIONAL CLASSROOM
- D27 CUSTODIAN
- D28 STAFF WORKROOM

REFERENCE NOTES

- ① 32" X 16" LINED SUPPLY AIR DUCT UP TO UNIT ON ROOF. PROVIDE TRANSITIONS AS REQUIRED AND CONNECT TO UNIT WITH FLEXIBLE CONNECTOR.
- ② 30" X 16" LINED RETURN AIR DUCT UP TO UNIT ON ROOF. PROVIDE TRANSITIONS AS REQUIRED AND CONNECT TO UNIT WITH FLEXIBLE CONNECTOR.
- ③ 50" X 16" LINED SUPPLY AIR DUCT UP TO UNIT ON ROOF. PROVIDE TRANSITIONS AS REQUIRED AND CONNECT TO UNIT WITH FLEXIBLE CONNECTOR.
- ④ 48" X 16" LINED RETURN AIR DUCT UP TO UNIT ON ROOF. PROVIDE TRANSITIONS AS REQUIRED AND CONNECT TO UNIT WITH FLEXIBLE CONNECTOR.
- ⑤ 14" Ø EXHAUST DUCT RISER UP THRU ROOF TO ROOF JACK. DUCT BRANCHES CONNECTED TO RISER SHALL NOT BE IN THE SAME PLANE.
- ⑥ 7" Ø EXHAUST DUCT RISER UP THRU ROOF TO ROOF JACK. DUCT BRANCHES CONNECTED TO RISER SHALL NOT BE IN THE SAME PLANE.
- ⑦ SIDEWALL ADJUSTABLE LINEAR SLOT DIFFUSERS: DIFFUSERS SHALL MEET ALL THE FOLLOWING CHARACTERISTICS: SURFACE MOUNT, NUMBER AND SIZE OF SLOT = 8, 1" SLOTS, LENGTH = 3' (EA), AIR FLOW = 250 CFM/FT, NC = 35 MAX. DIFFUSER SHALL BE METAL AIRS SERIES 6000 COMPLETE WITH BEI INSULATED BOOT PLENUM.
- ⑧ SIDEWALL ADJUSTABLE LINEAR SLOT DIFFUSERS: DIFFUSERS SHALL MEET ALL THE FOLLOWING CHARACTERISTICS: SURFACE MOUNT, NUMBER AND SIZE OF SLOT = 8, 1" SLOTS, LENGTH = 6' (EA), AIR FLOW = 250 CFM/FT, NC = 35 MAX. DIFFUSER SHALL BE METAL AIRS SERIES 6000 COMPLETE WITH BEI INSULATED BOOT PLENUM.
- ⑨ DUCTS RUN BETWEEN ROOF RAFTERS.


GENERAL NOTES

- 1. ALL TRANSFER DUCTS SHALL BE LINED WITH 1" THICK DUCT LINER.
- 2. ALL EXTERIOR DOOR LOUVERS SHALL BE PROVIDED WITH SCREEN. SEE ARCHITECTURAL DRAWINGS.
- 3. ALL EXTERIOR DUCTWORK SHALL BE WEATHERPROOF AND SEALED TO FORM A POSITIVE AIR AND WATERTIGHT SEAL.

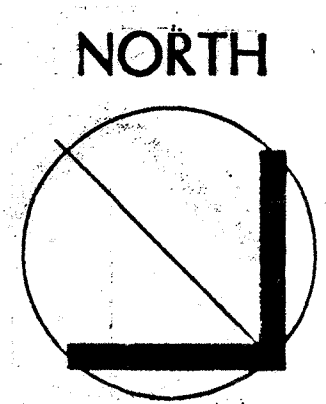

BUILDING 'D' FLOOR PLAN

1/8" = 1'-0" A

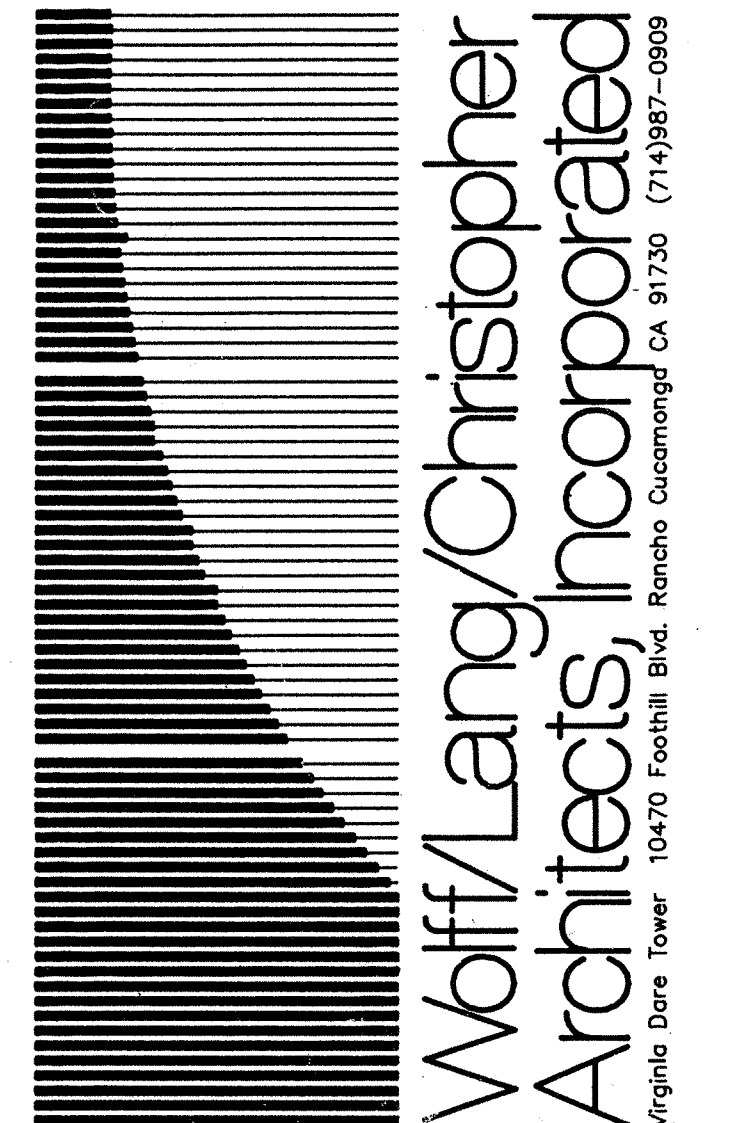

Murrieta Valley Unified School District
Thompson Middle School
 Phase 1
 Bligs C&D

CONSULTANT
MATHAUDHU ENGINEERING, INC.
 CONSULTING MECHANICAL ENGINEERS
 2803 BROOKTON AVE., SUITE B, RIVERSIDE, CA 92501
 (951) 506-1176 FAX (951) 506-3001

APPROVED

APPROVED

 J. M. Wines
 No. C-14548
 expires 05/31/14
 STATE OF CALIFORNIA

APPROVED
 IDENTIFICATION SHEET
 DIV. OF THE STATE ARCHITECT
 OFFICE OF REGULATION SERVICES
 APPL- 0118767
 AC _____ FL _____ SS _____
 DATE 6/11/14

NO	DATE	BY	REMARKS

BUILDING 'D' MECHANICAL FLOOR PLAN

DRAWN CC/ETS
 CHECKED SPM
 DATE 2-17-17
 SCALE AS NOTED
 JOB NO. 921040

M1.D